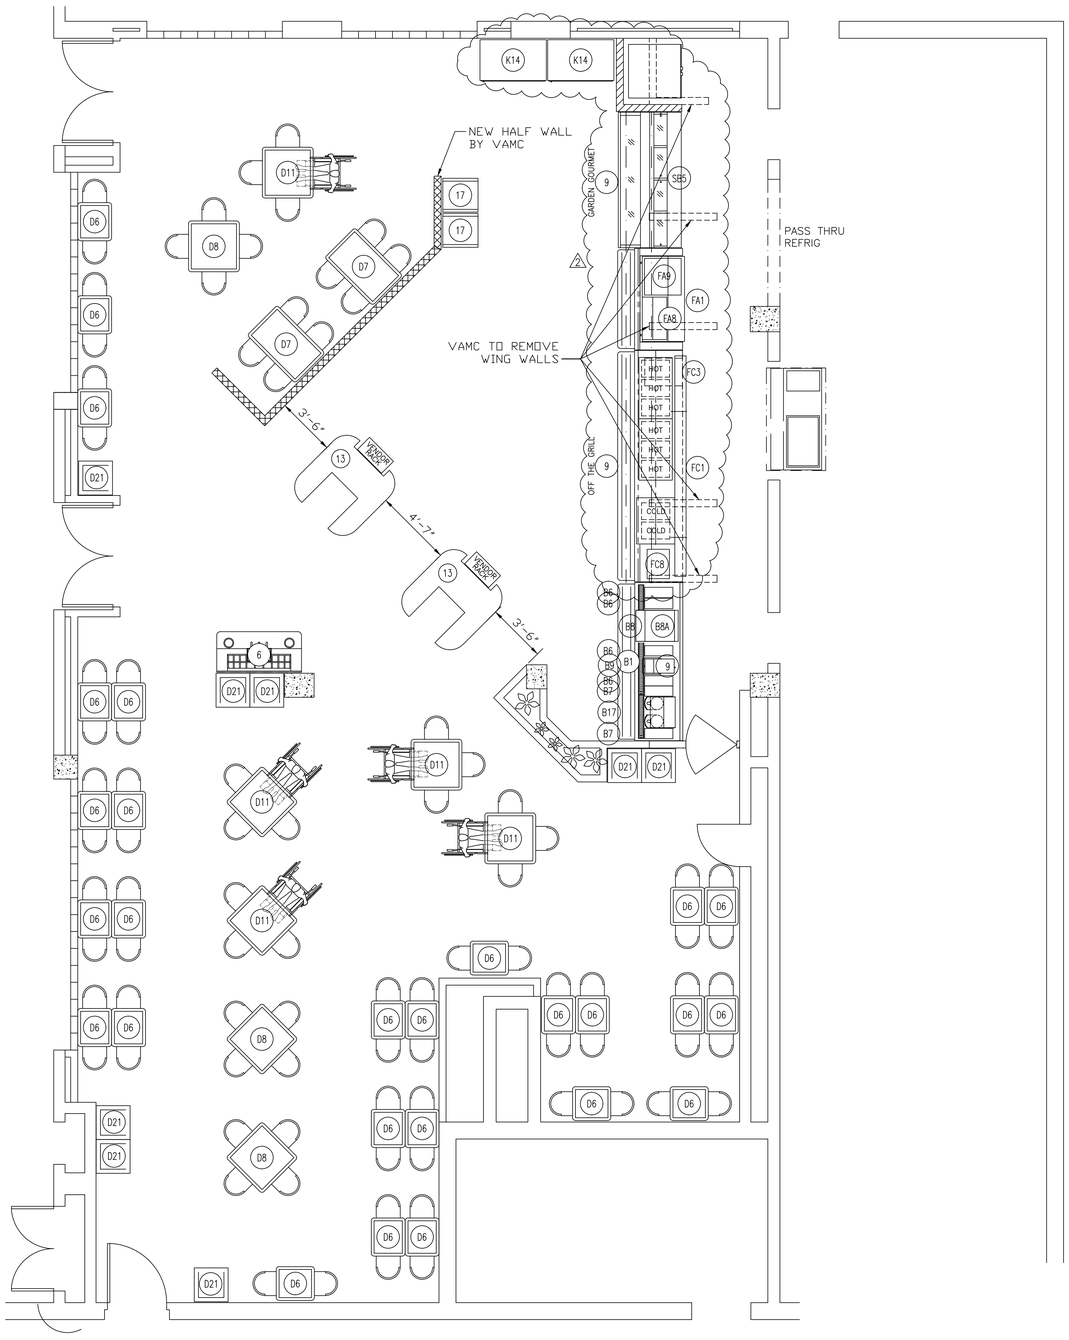
K14
K14
NEW HALF WALL
BY VAMC
D11
17
17
D8
D7
D7
D6
D6
D6
D21
VAMC TO REMOVE
WING WALLS
3'-6"
13
4'-7"
13
3'-6"
6
D21
D21
D11
D11
D11
D8
D8
D21
D21
D6
D6
D6