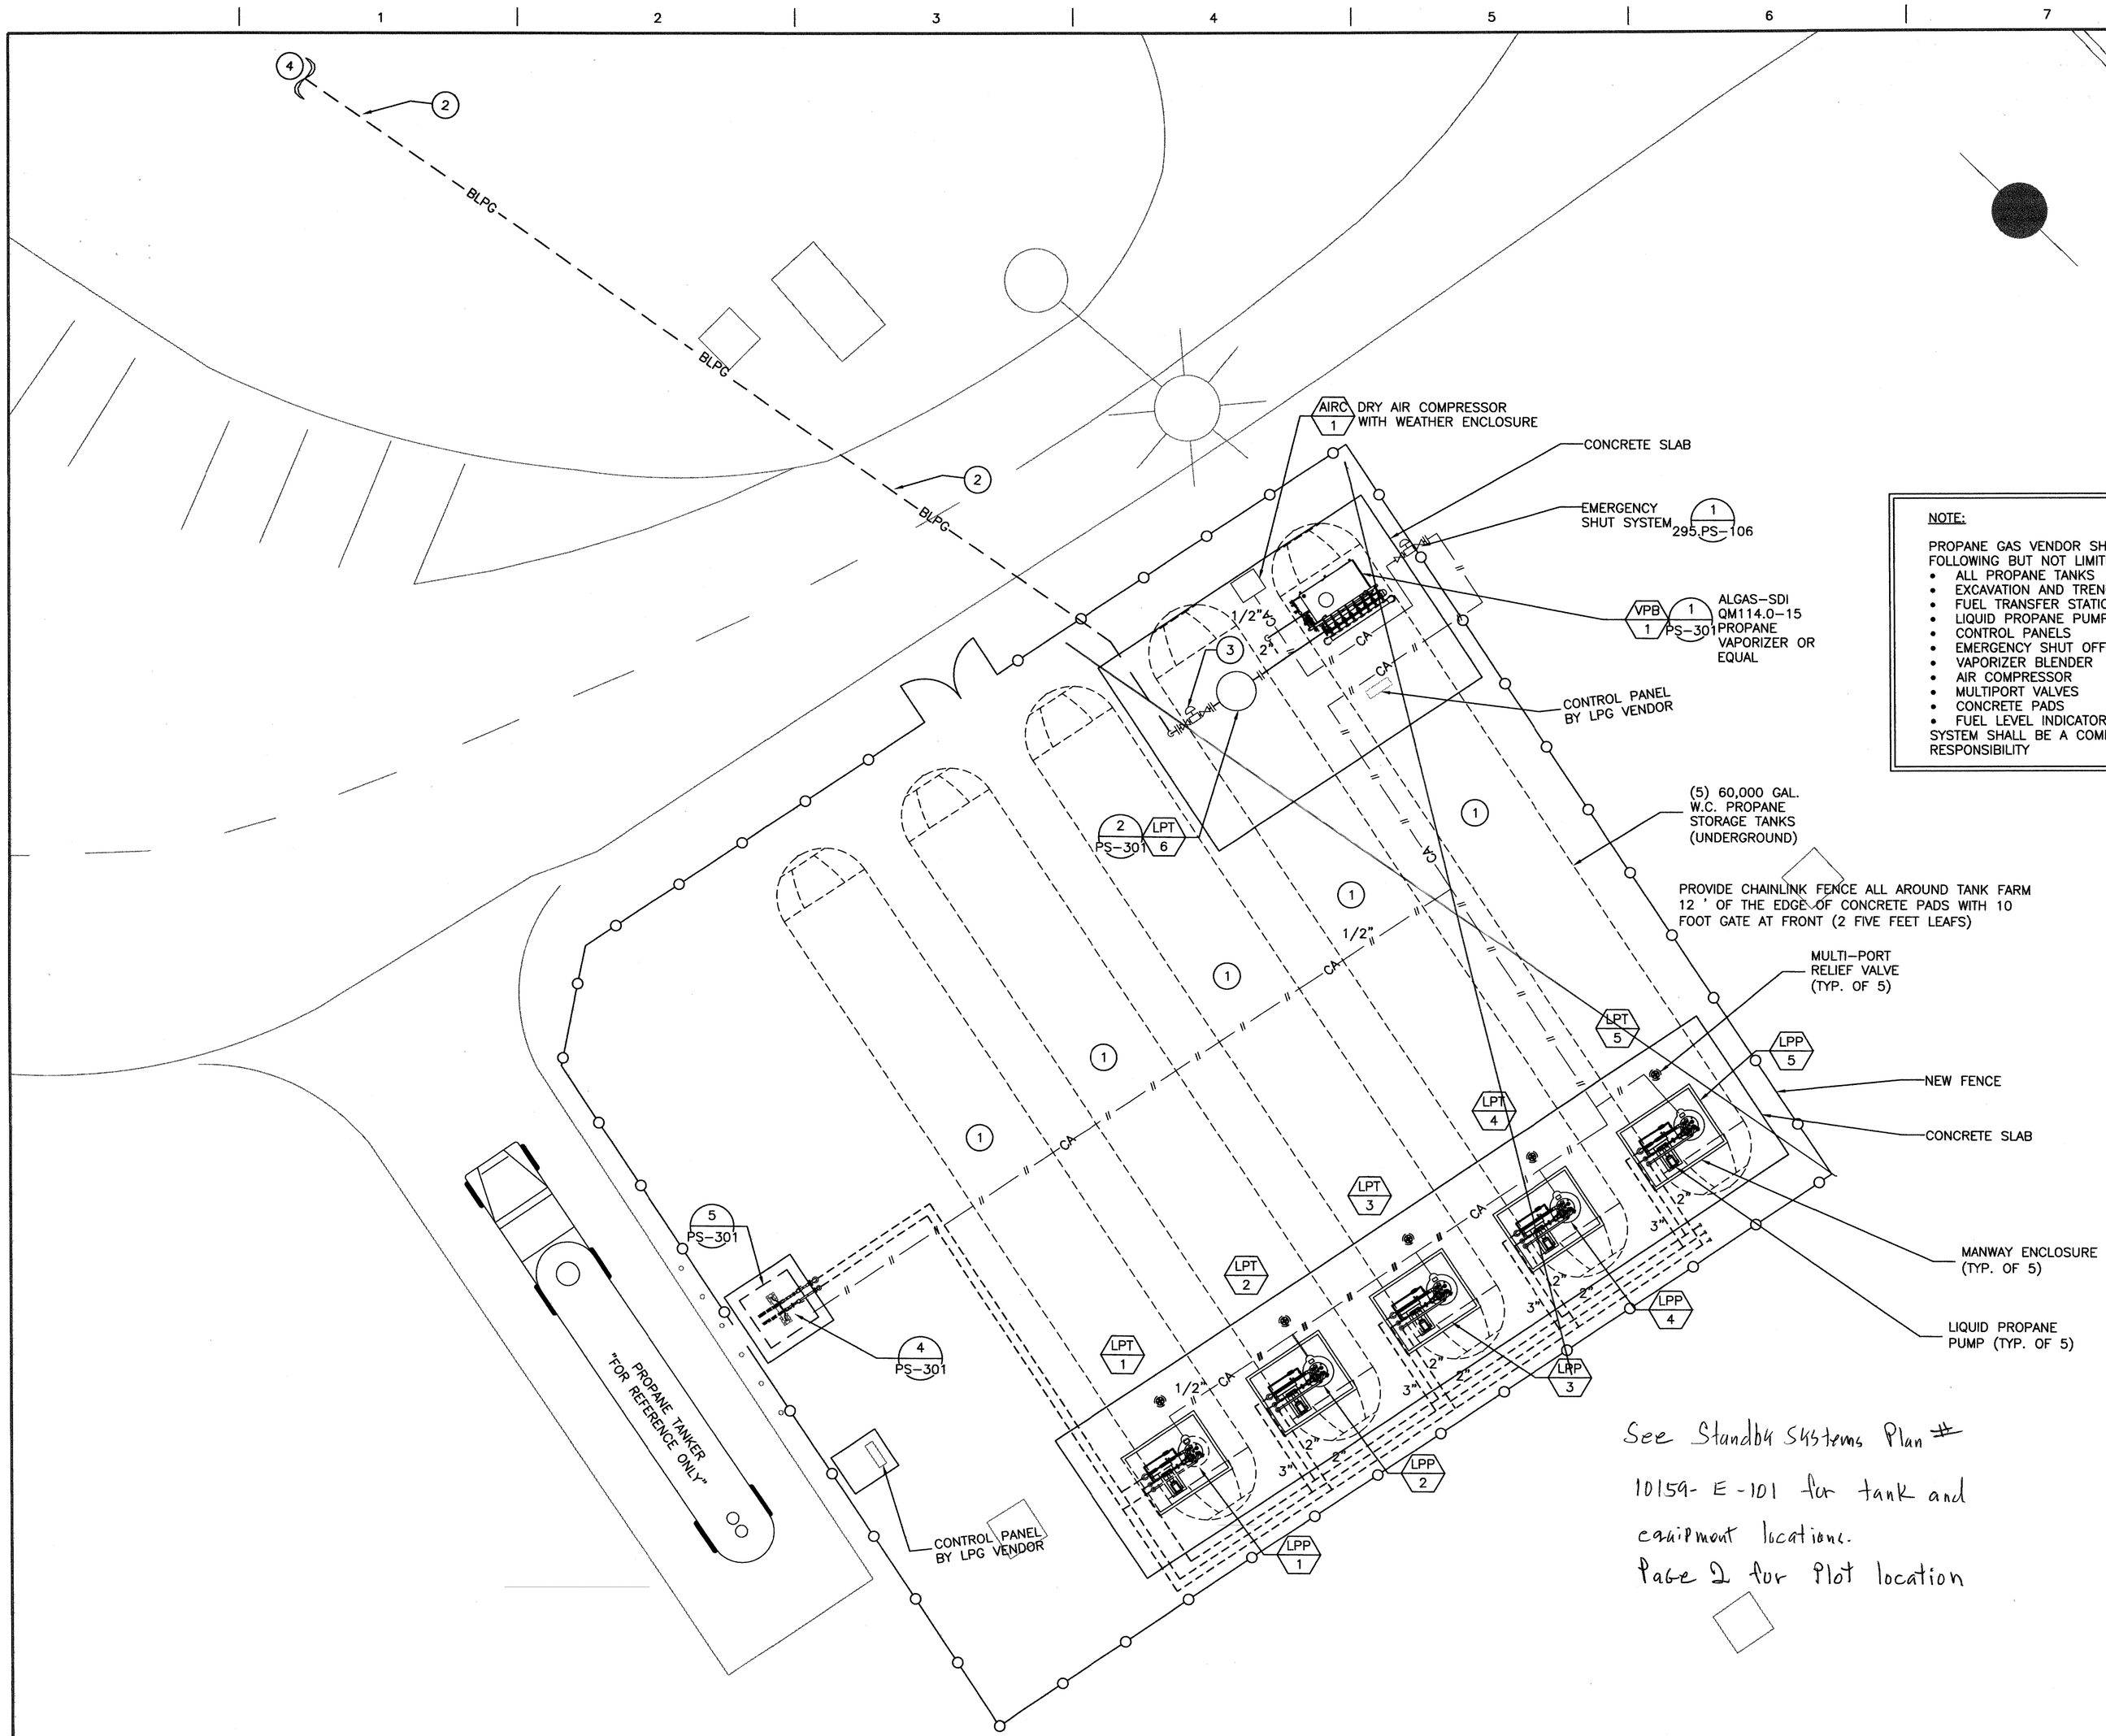

See Standby Systems Plan # 10159-E-101 for tank and equipment locations.
Page 2 for Plot location

GENERAL NOTES

1. COORDINATE EXACT LAYOUT AND DIMENSION OF THE TANKS LOCATION WITH STRUCTURAL AND CIVIL DRAWINGS PRIOR TO START OF WORK.
2. LABELING MUST BE IDENTIFIED ON ALL FUEL LINES.

KEY NOTES

1. INSTALL (5) 60,000 GALLON LPG TANKS WITH ALL THE REQUIRED APPURTENANCES.
2. ROUTE 8"BLPG FROM VAPORIZER/BLENDER TO BOILER PLANT.
3. PROVIDE LINE SIZE CALIFORNIA APPROVED EARTHQUAKE VALVE.
4. FOR CONTINUATION SEE 295.PS-103.

NOTE:

PROPANE GAS VENDOR SHALL PROVIDE AND INSTALL THE FOLLOWING BUT NOT LIMITED TO:

- ALL PROPANE TANKS
- EXCAVATION AND TRENCHING
- FUEL TRANSFER STATION
- LIQUID PROPANE PUMPS
- CONTROL PANELS
- EMERGENCY SHUT OFF
- VAPORIZER BLENDER
- AIR COMPRESSOR
- MULTIPORT VALVES
- CONCRETE PADS
- FUEL LEVEL INDICATORS

SYSTEM SHALL BE A COMPLETE PACKAGE SINGLE POINT OF RESPONSIBILITY

LPG TANK FARM PLAN

SCALE: 1/8"=1'-0"

0 4' 8' 16'
1/8" = 1'-0"

AS BUILT
REVISIONS BUILT

100% CD SUBMITTAL	02/29/2012
65% DD SUBMITTAL	01/27/2012
35% ED SUBMITTAL	11/17/2011
Revisions	

VA FORM 08-6231, OCT 1978

ARCHITECT/ENGINEERS/CONSULTANTS:

GOTAMA BUILDING ENGINEERS, INC.
434 E. BROADWAY - LONG BEACH, CA 90802
P. 562.216.7366 F. 562.216.7369
GBE JOB # - 211-128-01

REGISTERED PROFESSIONAL ENGINEER
GOTAMA GOTAMI
NO. M24849
Exp. 9-30-13
MECHANICAL
STATE OF CALIFORNIA

SIGNATURES FOR APPROVAL

	DATE		DATE		DATE
MEDICAL CENTER DIRECTOR		ASSOC. DIR ADMINISTRATIVE SERVICES		CHIEF, ENGINEERING SERVICE	
CHIEF OF STAFF		ASSOC. DIR. PATIENT SVCS/NURSE EXEC.		SAFETY MANAGER	
CHIEF OF CONST. MGMT/DESIGN SECTION		G.E.M.S. COORDINATOR		CHIEF, ENVIRONMENTAL CARE SECTION	
MAINTENANCE CONTROL MANAGER		CHIEF OF SERVICE		CHIEF OF POLICE	

CHIEF PROJECT SECTION (PRODUCTION) DATE
PROJECT ENGINEER DATE

Drawing Title: TANK_FARM_PLAN

Project Title: VA GREATER LOS ANGELES HEALTHCARE CENTER RETROFIT BOILER PLANTS

Location: 11301 WILSHIRE BLVD. LOS ANGELES CA, 90073 AND 16111 PLUMMER ST., NORTH HILLS, CA 91343

Date: 02-29-2012 | Checked: AA | Drawn: JE

Project Number: 691-12-107WL
Building Number: 295
Drawing Number: 295.PS-105
Dwg. SHT of

Office of Facilities Management

Department of Veterans Affairs