


[illegible]

SAMPLES AS REFERENCED ON THE KEY BELOW
ARE DETERMINED TO BE LEAD-BASED PAINT IN
FAIR, POOR OR PEELING CONDITION AND
REQUIRE CORRECTIVE ACTION. SAMPLE
LOCATIONS ARE SHOWN ON THIS PLAN.

LBP-000 LEAD PAINT SAMPLE

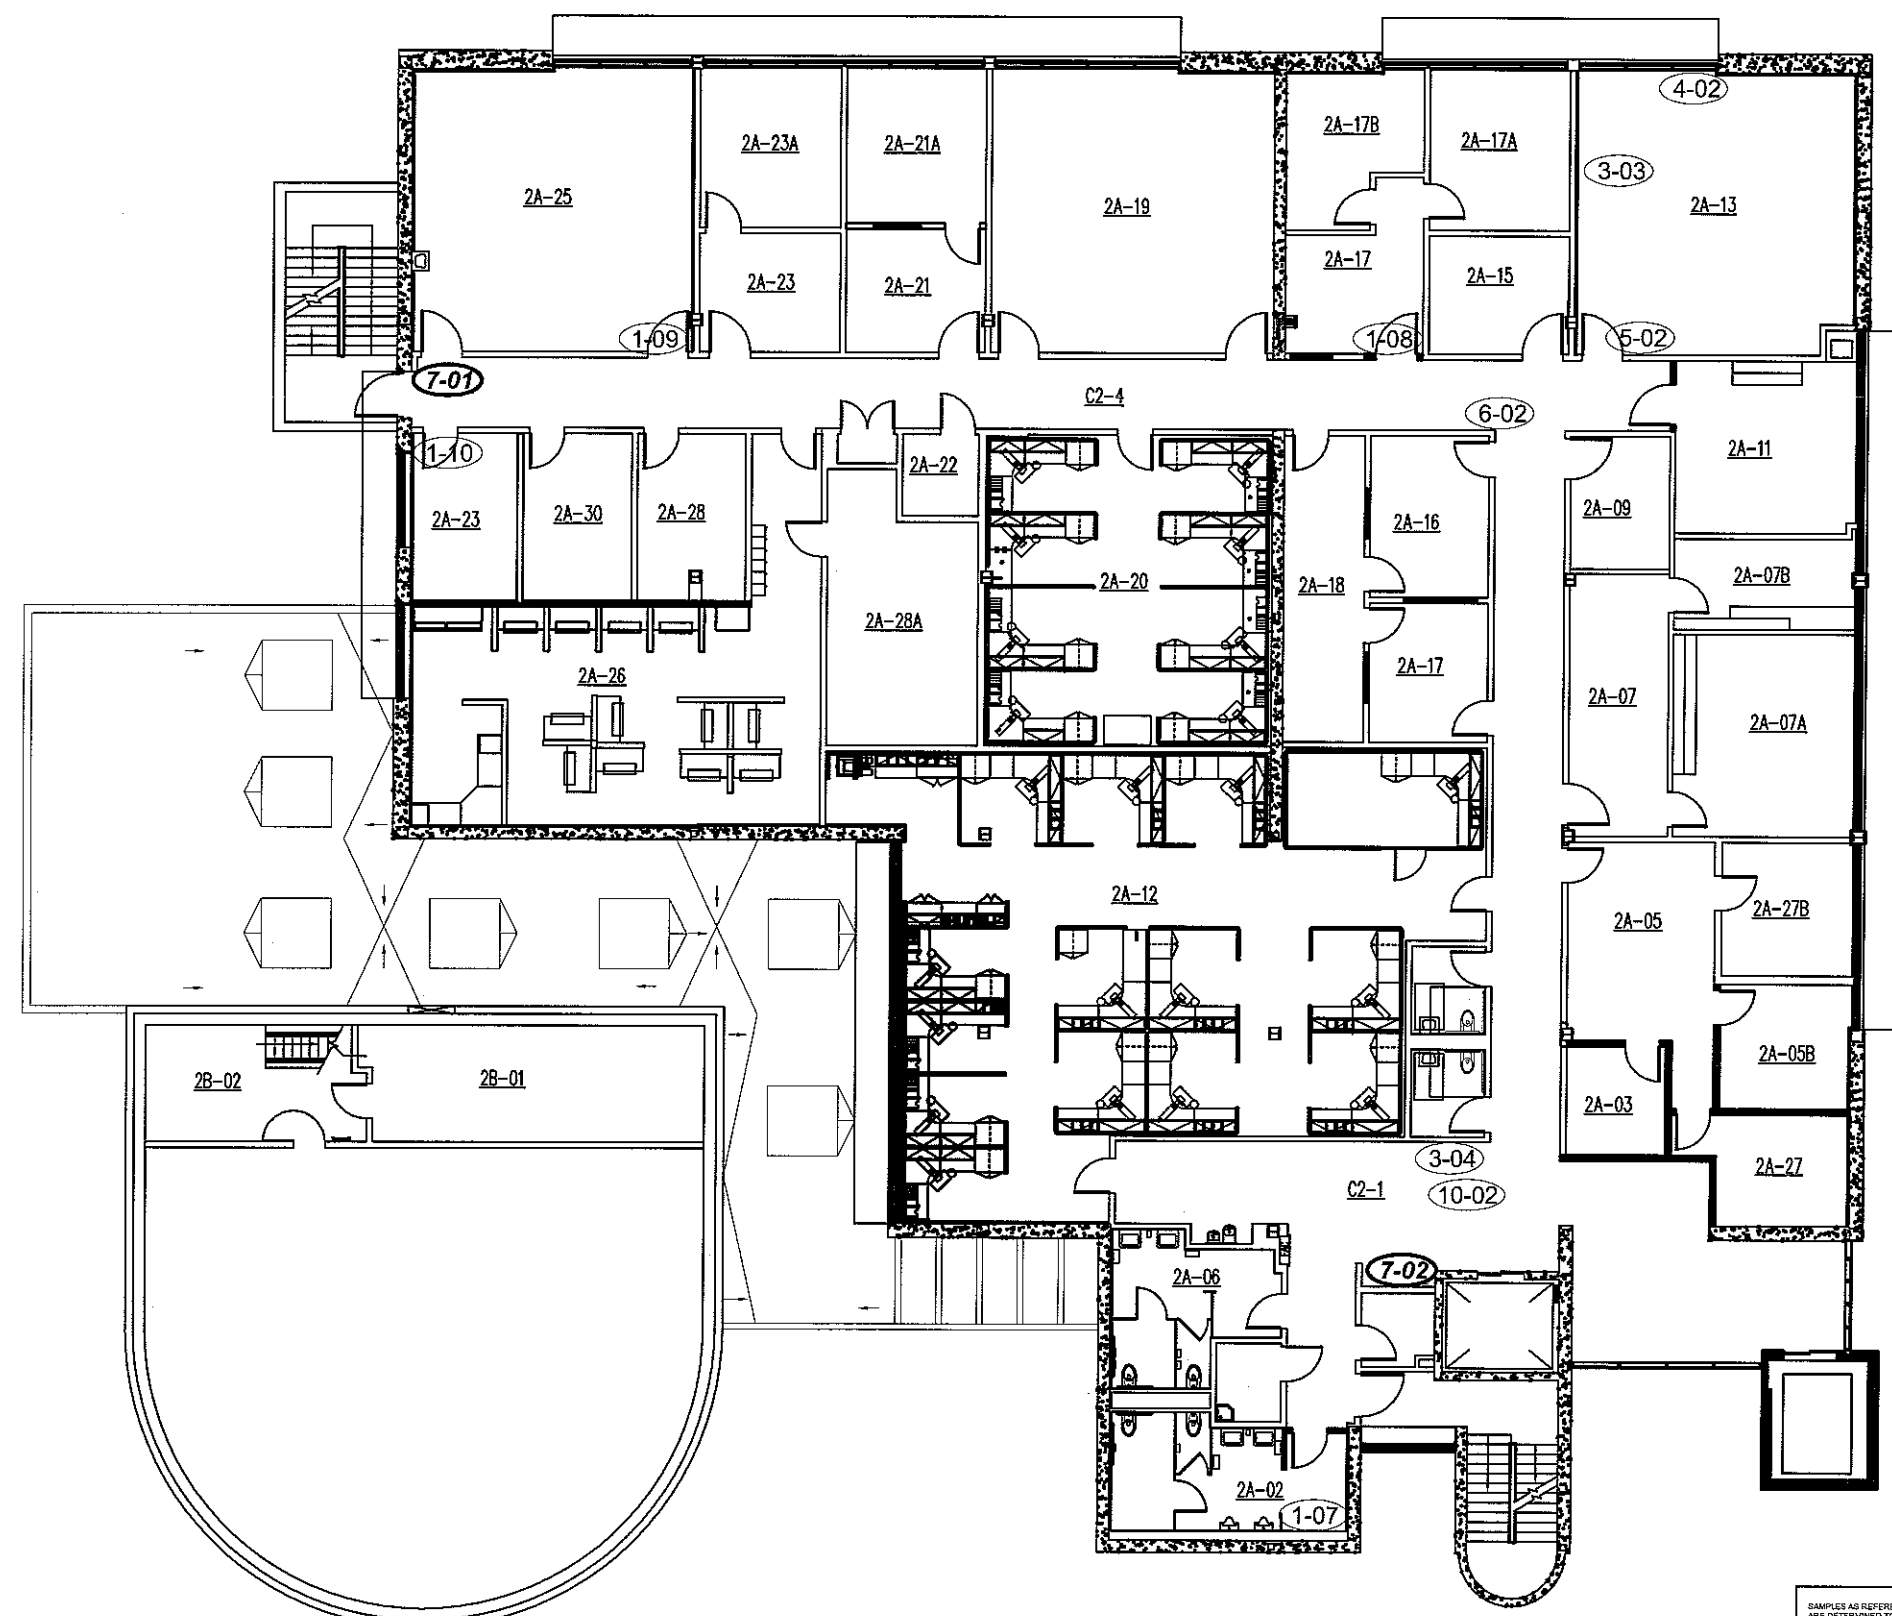

T. BROOKS & ASSOCIATES
613 Harvard Ave. STE. 201
Clovis, CA 93612
Tel: 559.298.9135
Fax: 559.298.2281
www.brooksconsult.com