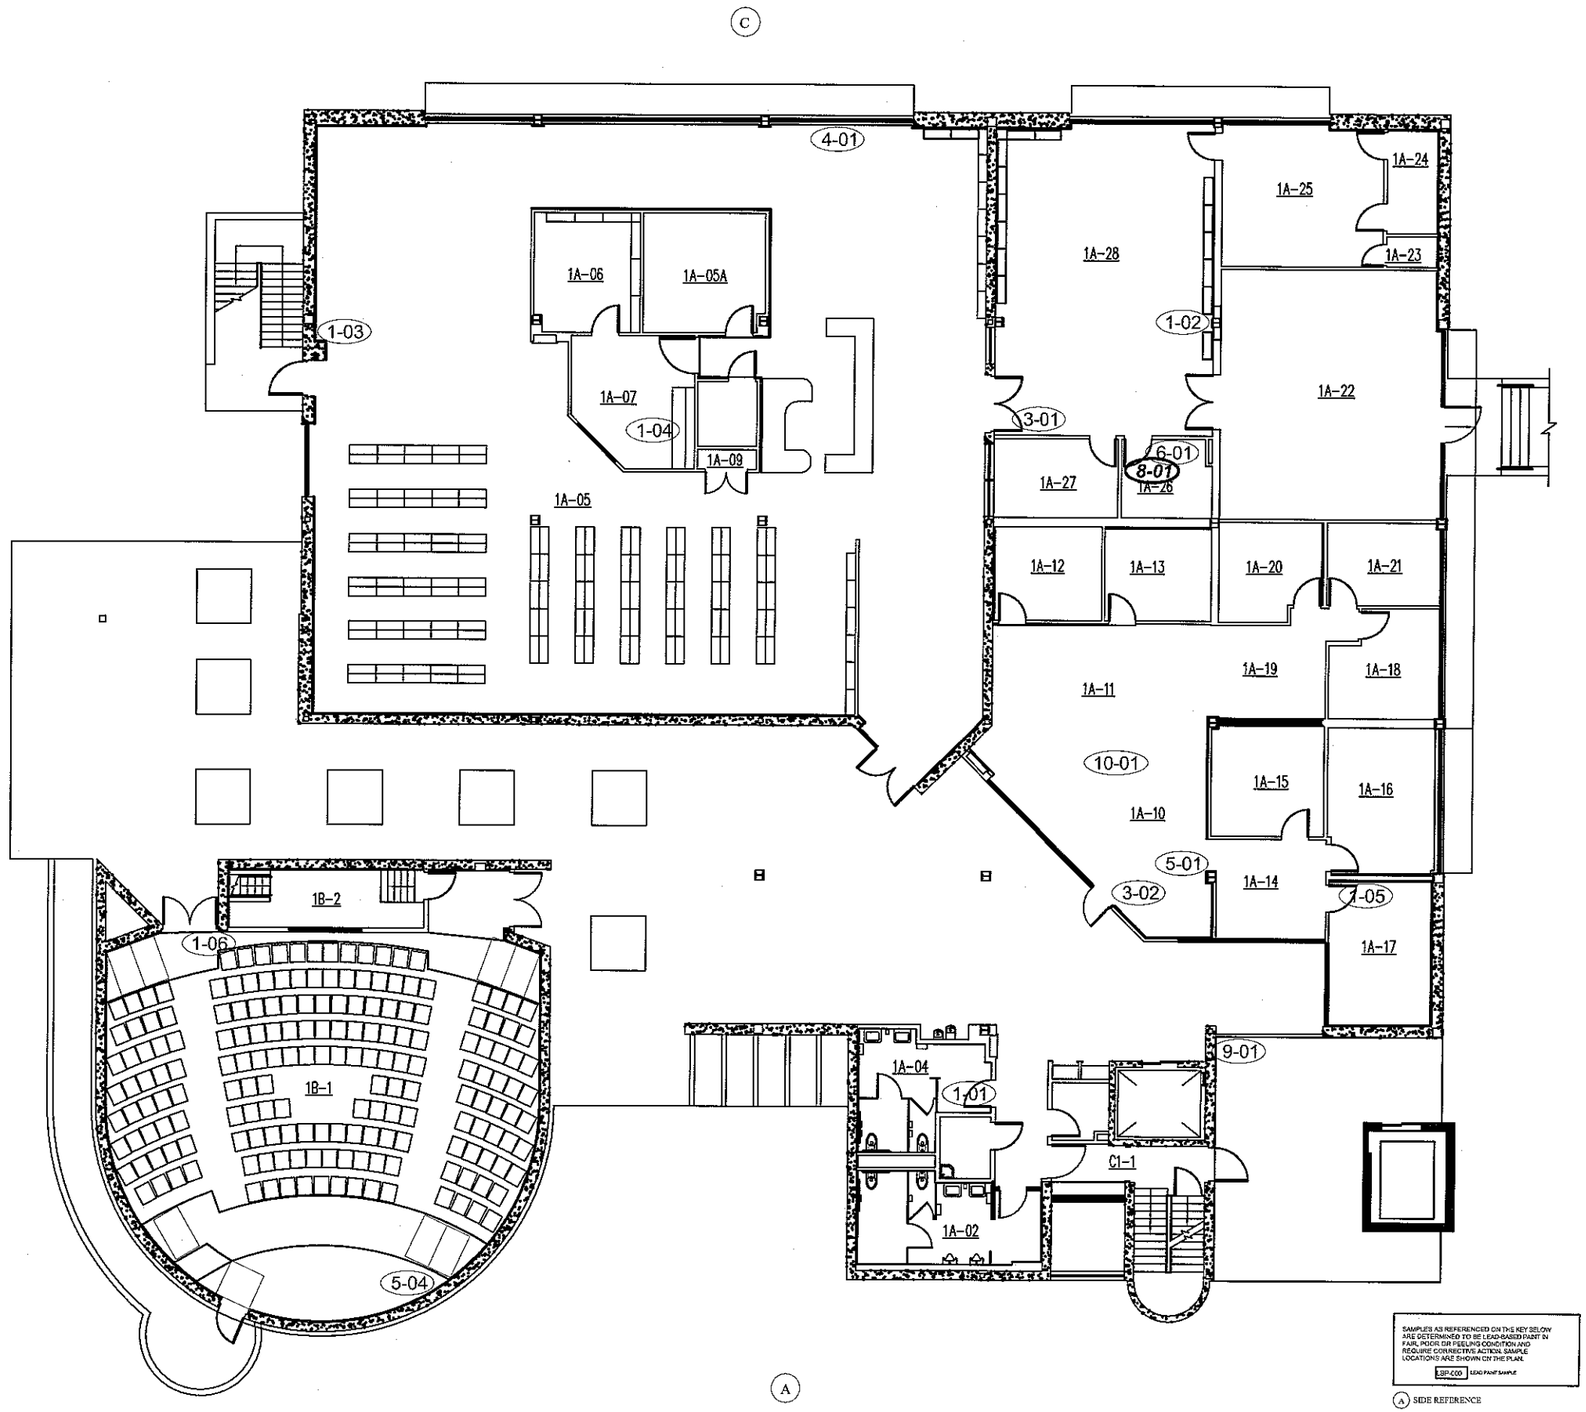

SAMPLES AS REFERENCED ON THIS KEY SELOW ARE DETERMINED TO BE LEAD-BASED PAINT IN FAIR, POOR OR FUELING CONDITION AND REQUIRE CORRECTIVE ACTION. SAMPLE LOCATIONS ARE SHOWN ON THE PLAN.

LBP-C00 LEAD PAINT SAMPLE

(A) SIDE REFERENCE

T. BROOKS & ASSOCIATES
613 Harvard Ave. STE. 201
Clovis, CA 93612
Tel: 559.298.9135
Fax: 559.298.2281
www.brooksconsult.com

CLIENT
CONTACT WILLIAM BLAYNEY
BROOKS & ASSOCIATES PROJECT MANAGER
Tim and Chad
DATE
1/5/2011

HMC ARCHITECTS
1827 E. FIR AVE., STUDIO 103, FRESNO CA.
WILLIAM BLAYNEY

VA BLDG. 24 SEISMIC UPGRADE
2615 E. CLINTON AVE.
FRESNO, CA

1 ST FLOOR PLAN

SIZE 11" X 17"
SCALE: N.T.S
BROOKS & ASSOCIATES PROJECT NUMBER
11-5789
SHEET 1 OF 2
A01

FILE NAME: E:\MedShare\Brooks & Associates Files\2011 Projects\11-5789, VA Bldg 24, HMC Architects, Asb Lead Survey\11-5789.1.dwg LAYOUT NAME: Layout3 (2) PLOTTED: Tuesday, March 22, 2011 - 4:06pm