




2 EAST ELEVATION
SCALE: $\frac{1}{16}'' = 1'-0''$

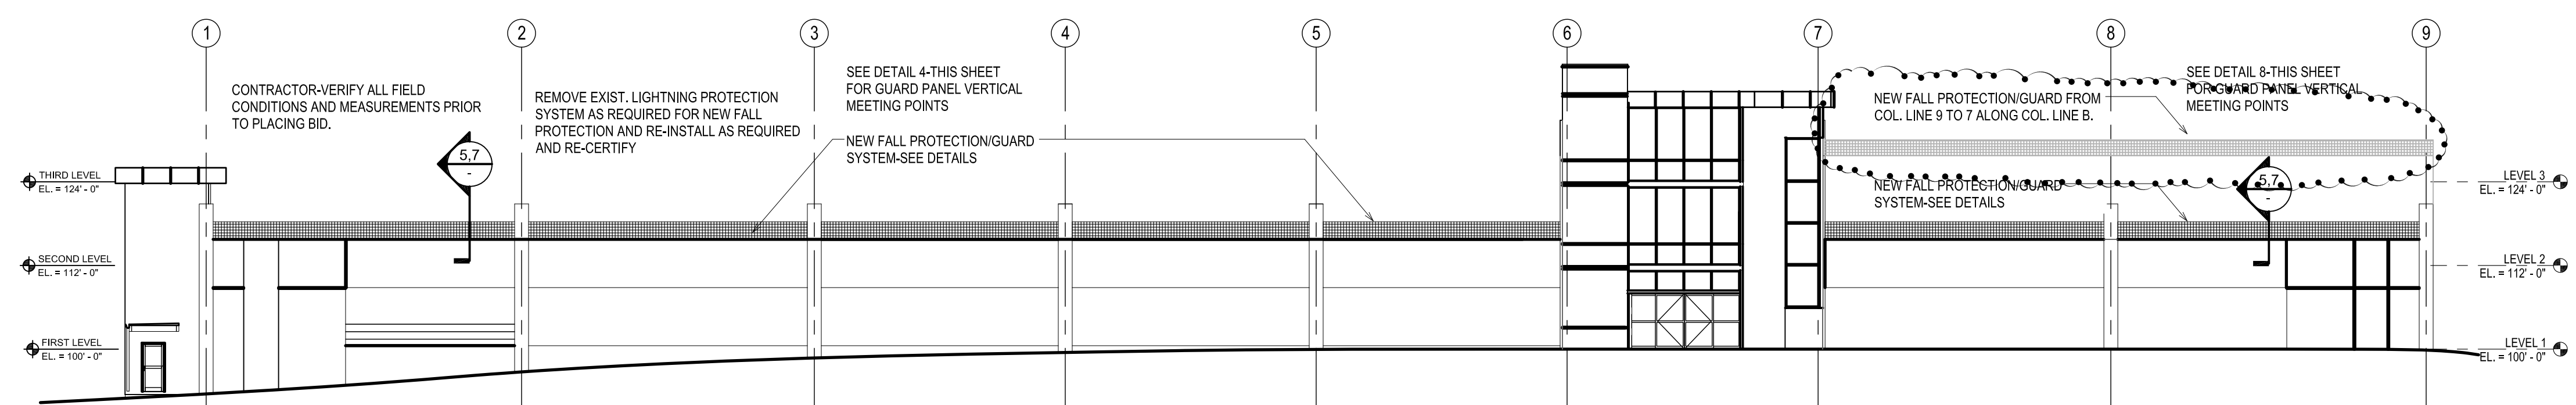

3 SOUTH ELEVATION
SCALE: $\frac{1}{16}''=1'-0''$

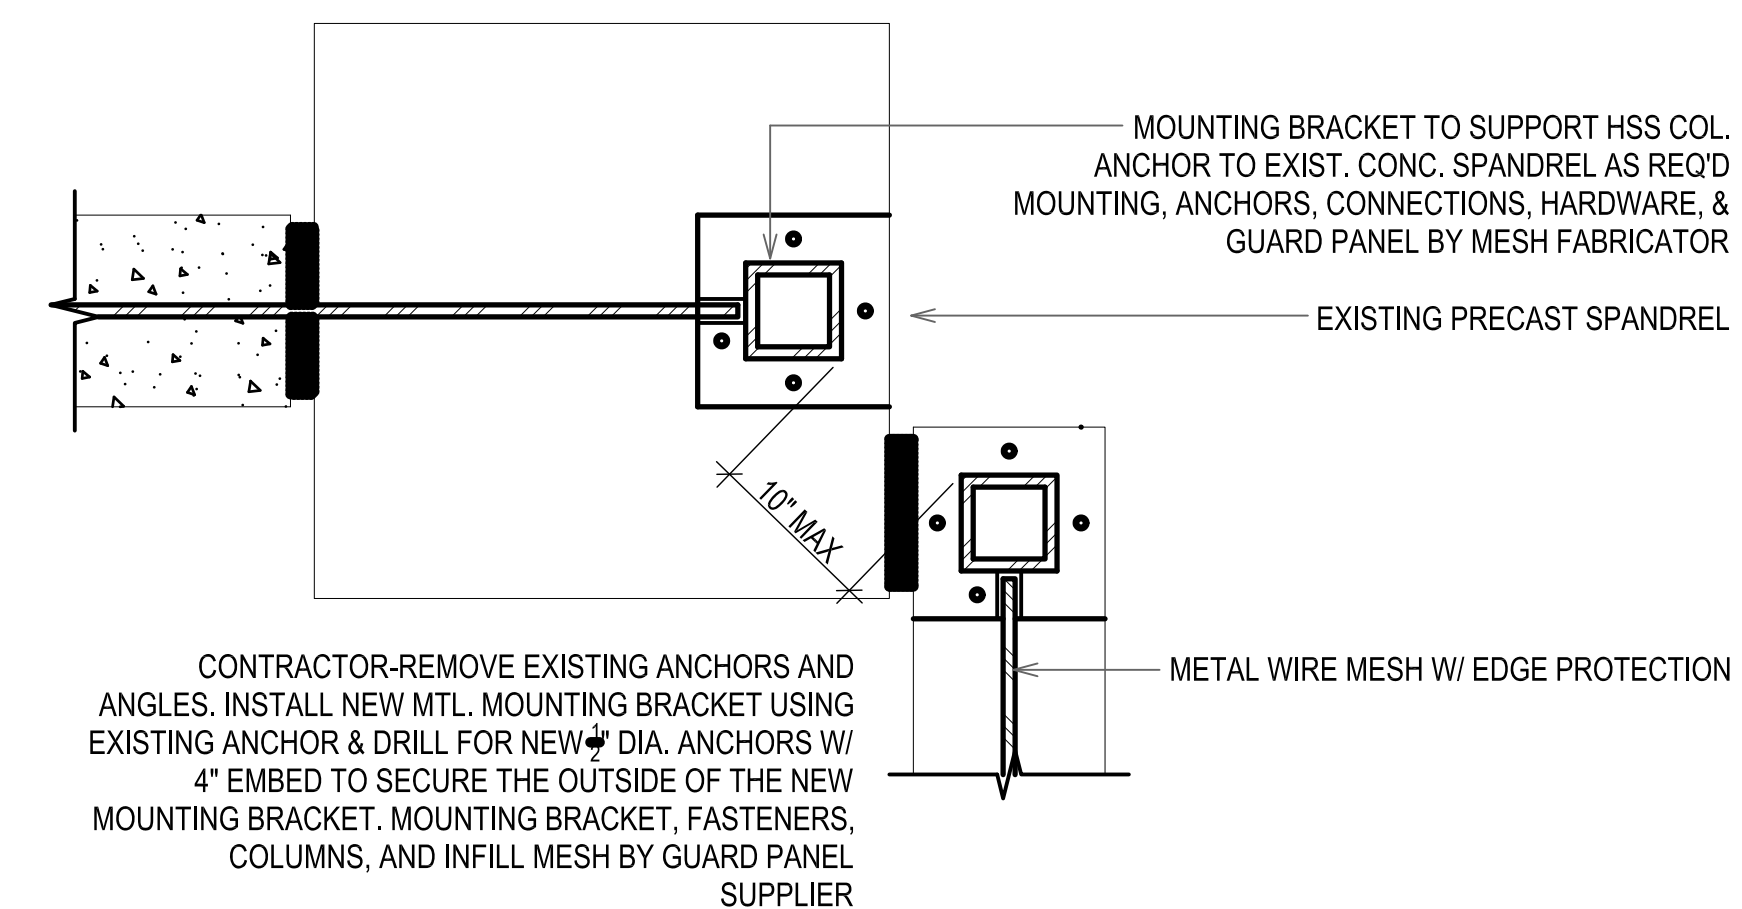

9 FALL PROTECT. DETAIL-
SCALE: 1-1/2"=1'-0"

BID SET				
Drawing Title BUILDING ELEVATIONS		Project Title PARKING DECK PARKING SAFETY		Building Number Bldg 9
				OFFICE OF FACILITIES MANAGEMENT
		Location W.G. (BILL) HEFNER VAMC		Drawing Number
		Date 5.1.18	Checked By: PDL	VA Project Number 659-18-206
				AD101
				VA  U.S. Department of Veterans Affairs