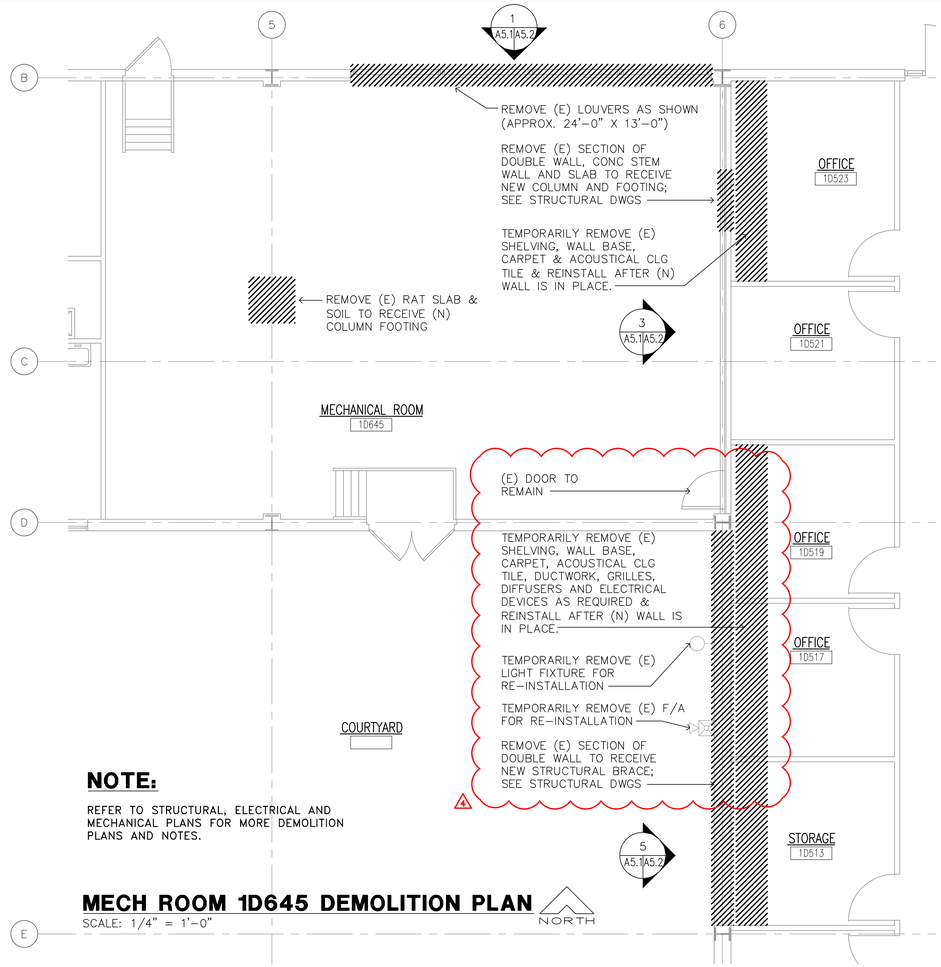

NOTE:

REFER TO STRUCTURAL, ELECTRICAL AND MECHANICAL PLANS FOR MORE DEMOLITION PLANS AND NOTES.

MECH ROOM 1D645 DEMOLITION PLAN

SCALE: 1/4" = 1'-0"

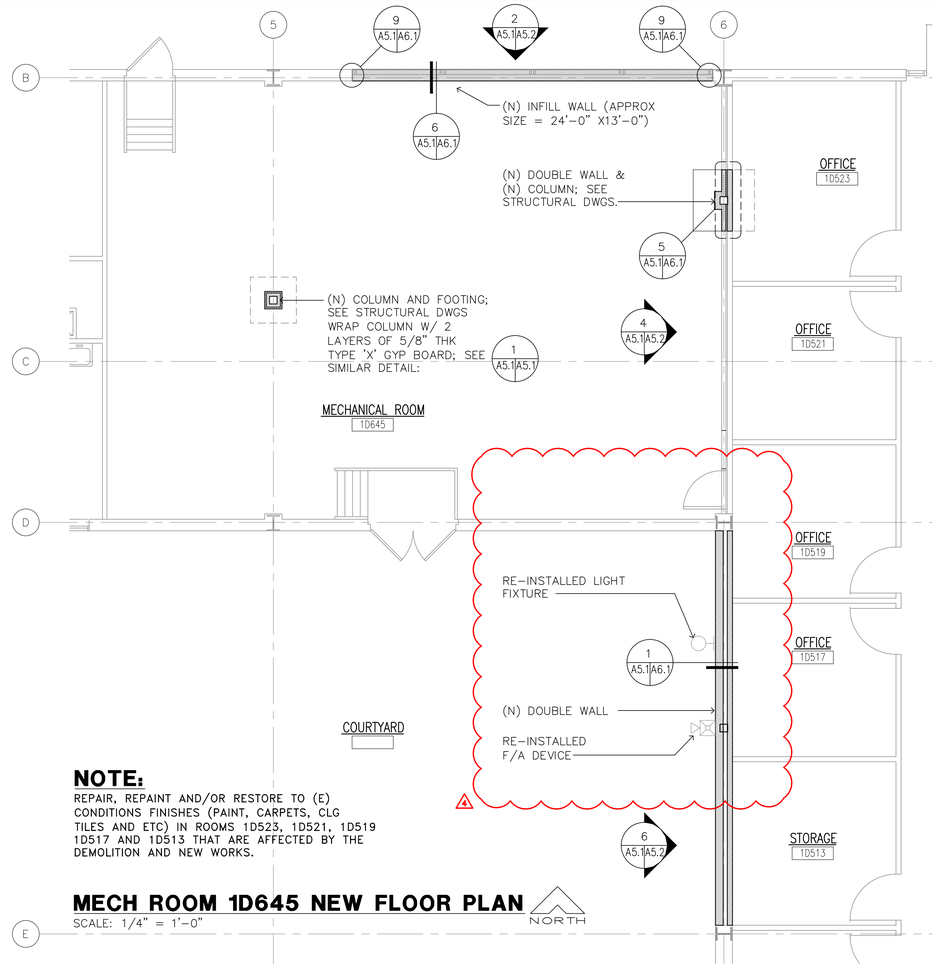

NOTE:

REPAIR, REPAINT AND/OR RESTORE TO (E) CONDITIONS FINISHES (PAINT, CARPETS, CLG TILES AND ETC) IN ROOMS 1D523, 1D521, 1D519 1D517 AND 1D513 THAT ARE AFFECTED BY THE DEMOLITION AND NEW WORKS.

MECH ROOM 1D645 NEW FLOOR PLAN

SCALE: 1/4" = 1'-0"

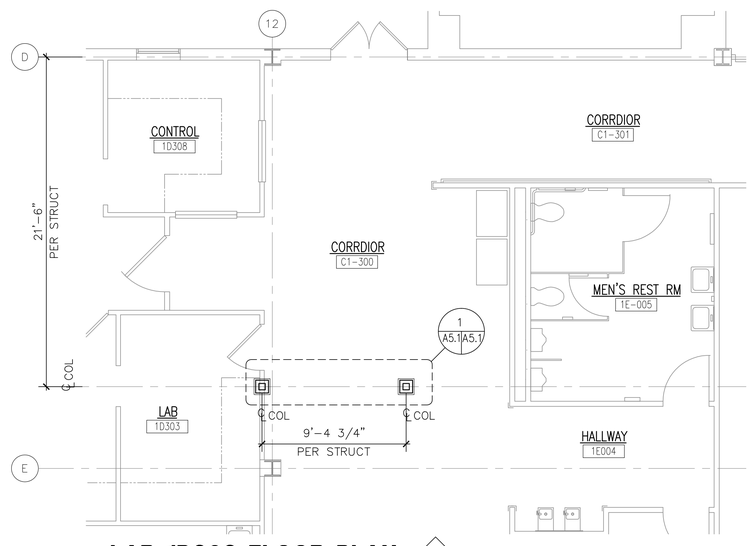

LAB 1D303 FLOOR PLAN

SCALE: 1/4" = 1'-0"

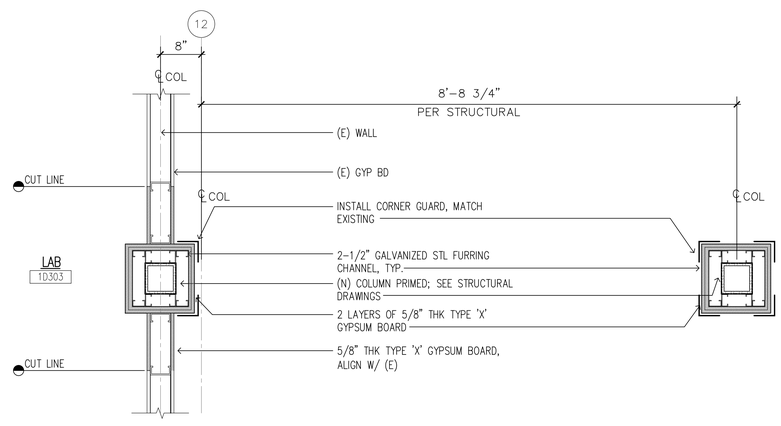

(N) COLUMN PLAN

1"=1'-0"

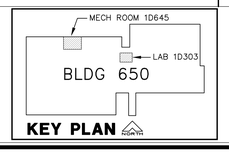

KEY PLAN

K.F. DAVIS ENGINEERING, INC
530 LA GONDA WAY, SUITE E
DANVILLE, CA 94526

Revisions: DATED 11/10/08; DATED 11/19/08; DATED 07/14/09; DATED 12/05/2011	Drawing Title: MECHANICAL ROOM 1D645 DEMOLITION AND NEW FLOORS	Project Title: BLDG 650 REPLACE AIR HANDLERS 1 THRU 4, 7 AND 9 – 15	Date: 12/05/11
			Project No.: 612A4-07-342
Approved:	Approved: Medical Center Director	Drawn: VMAN	Building Number:
Approved:	Approved: Chief, Engineering Service	Checked: JA	Location: MATHER VAMC MATHER CALIFORNIA
			DRAWING No. A5.1 Dwg. Of

Department of Veterans Affairs

SCALE: 3/4"=1'-0" 1/2"=1'-0" 1/4"=1'-0" 1/8"=1'-0"

0307108