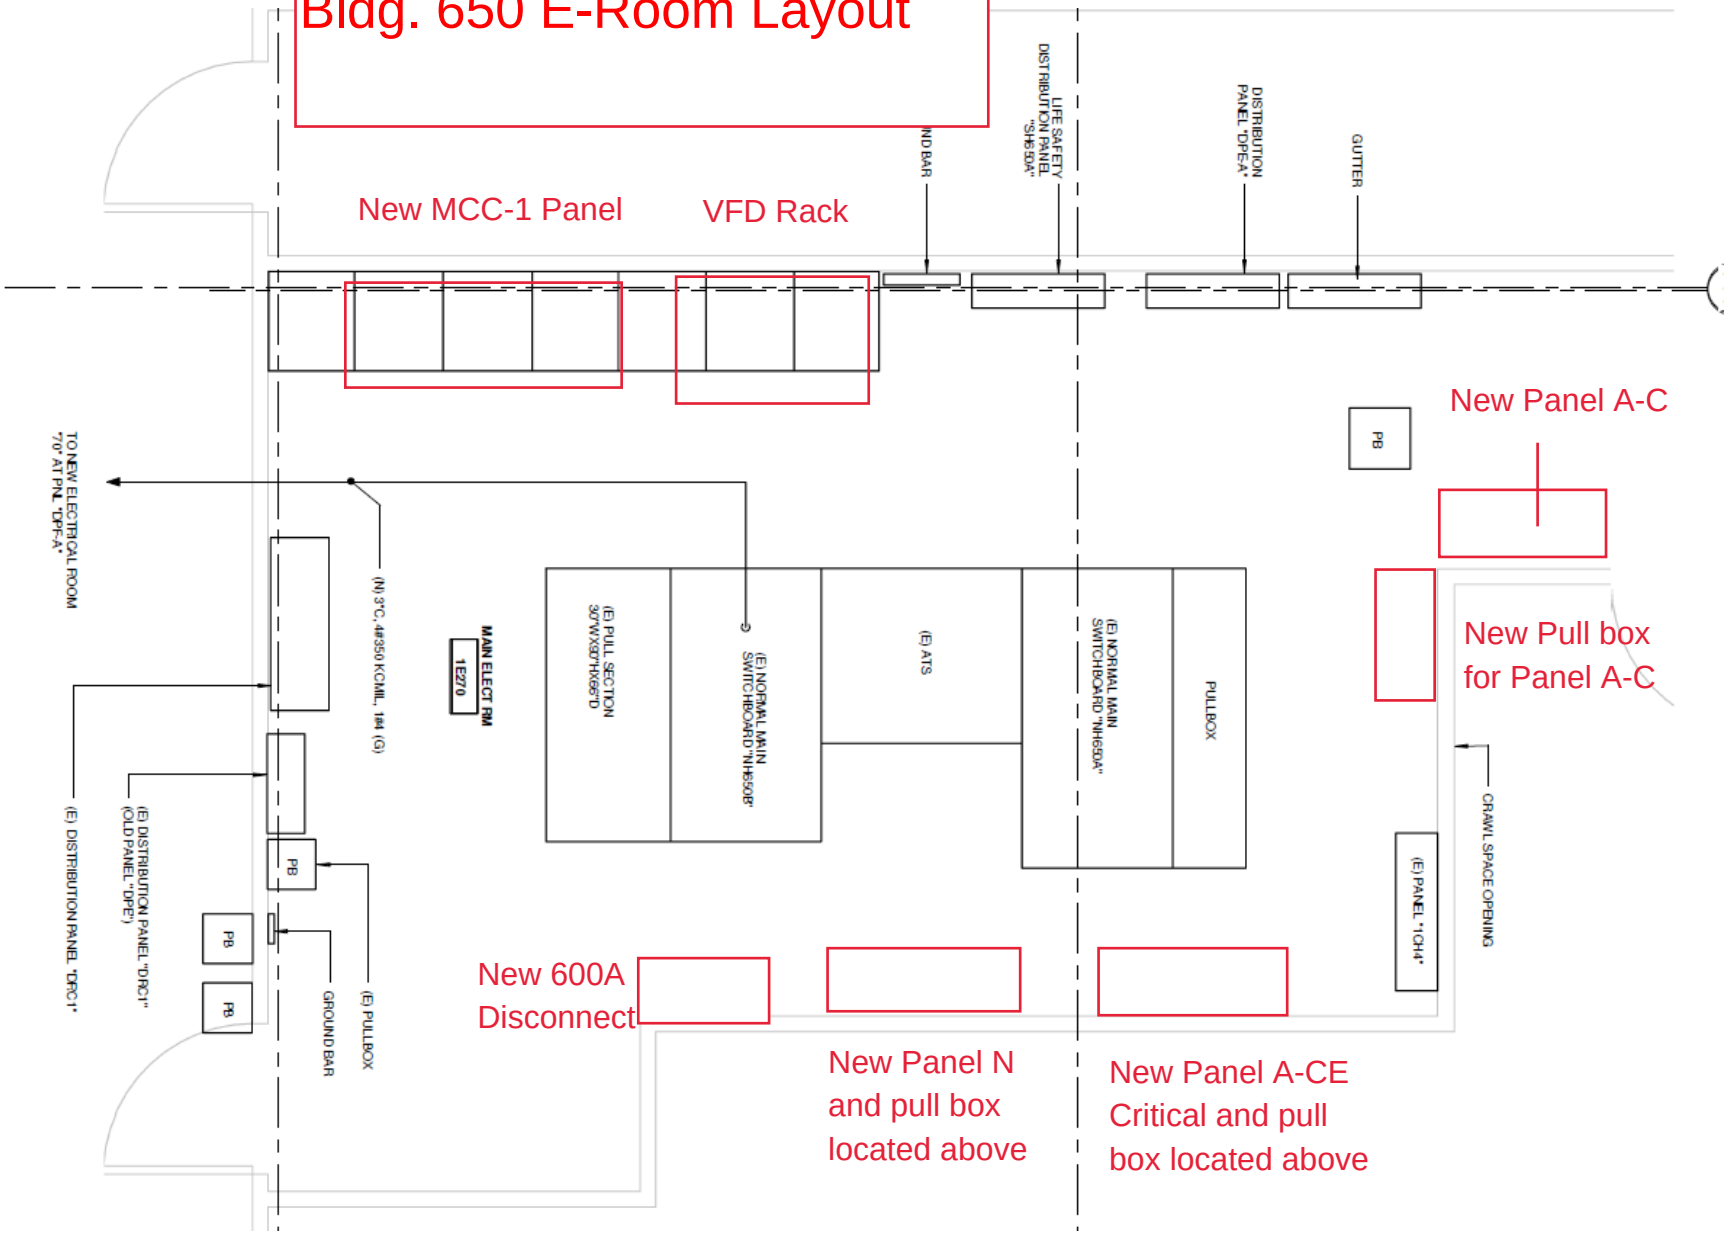Bldg. 650 E-Room Layout