


## Utility Plant Layout 645

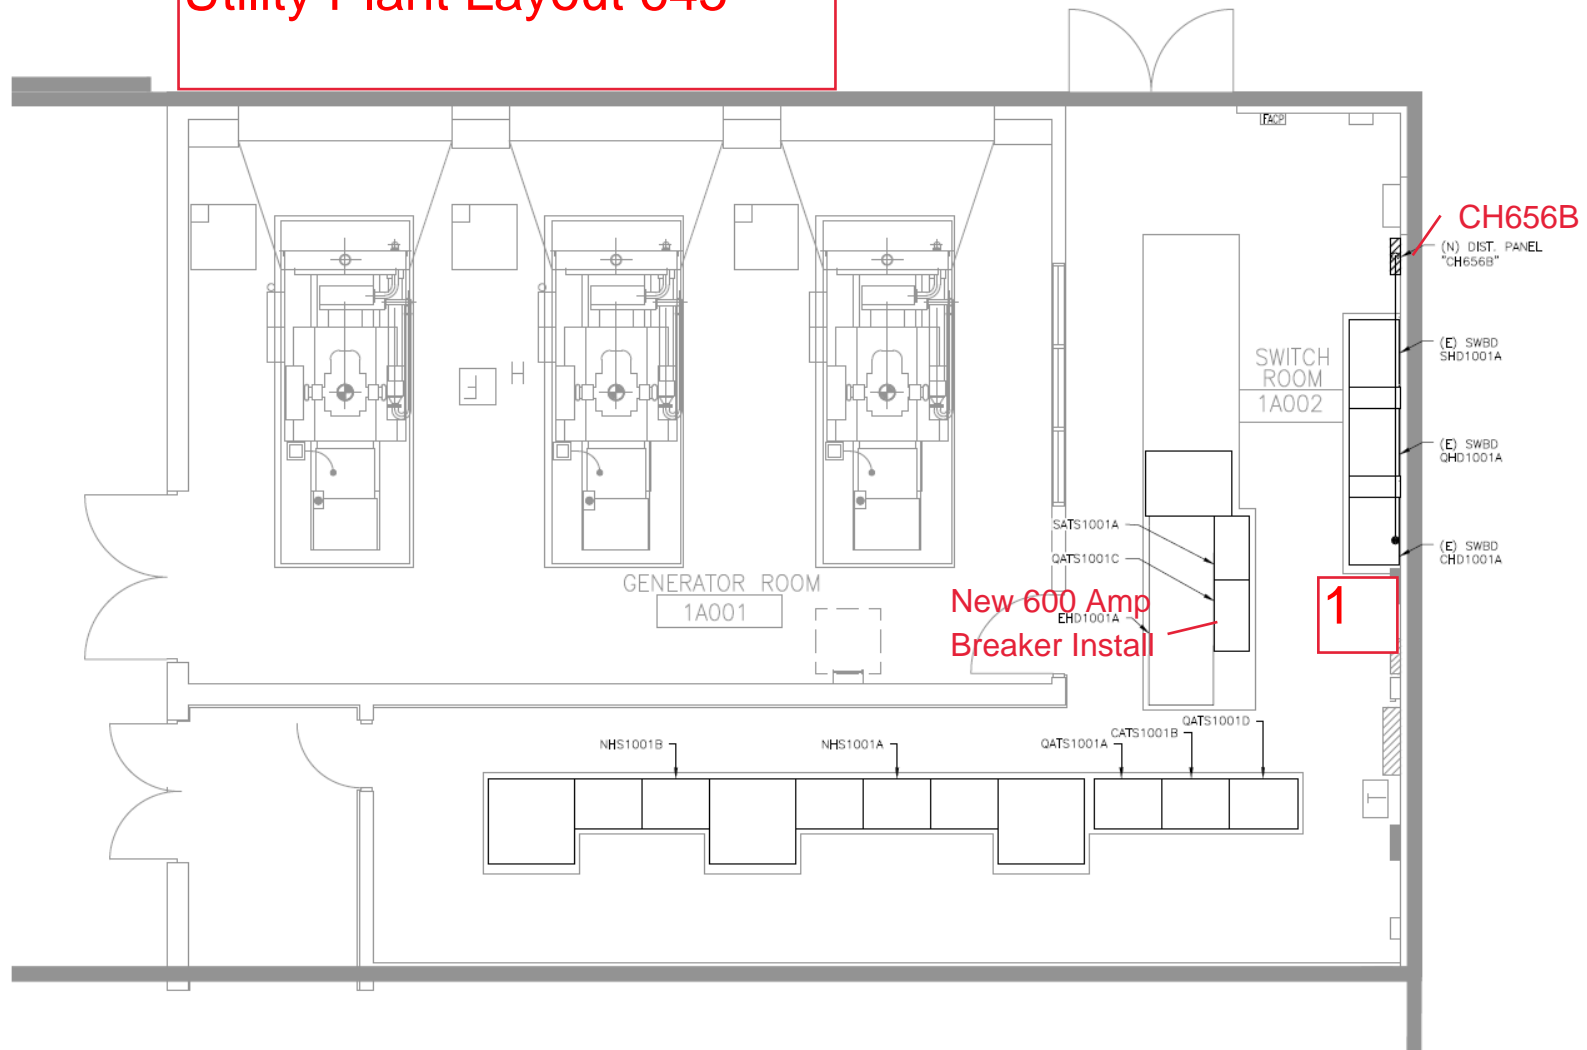

Point 1 is pull box and intercept location proposed.