







PLUMBING FIELD STUDY KEY SYMBOLS	
TYPE A – PIPE LENGTH GREATER THAN TWICE THE DIAMETER OF THE PIPE SIZE TERMINATING AT CAP, VALVE, OR FITTING.	
TYPE B – PIPE LENGTH GREATER THAN TWICE THE DIAMETER OF THE PIPES TERMINATING AT AN INFREQUENTLY USED PLUMBING FITTURE.	
TYPE C – PIPE LENGTH GREATER THAN 25 FEET TERMINATING AT A FREQUENTLY USED PLUMBING FITTURE.	
	DEAD LEG TAG
	MINING VALVE TAG
	REMEDATE DEAD LEG
	NON-INSULATED PIPE REFER TO SCHEDULE



BUILDING 28 BASEMENT  
PLUMBING AS BUILT/DEAD LEG PLAN

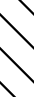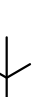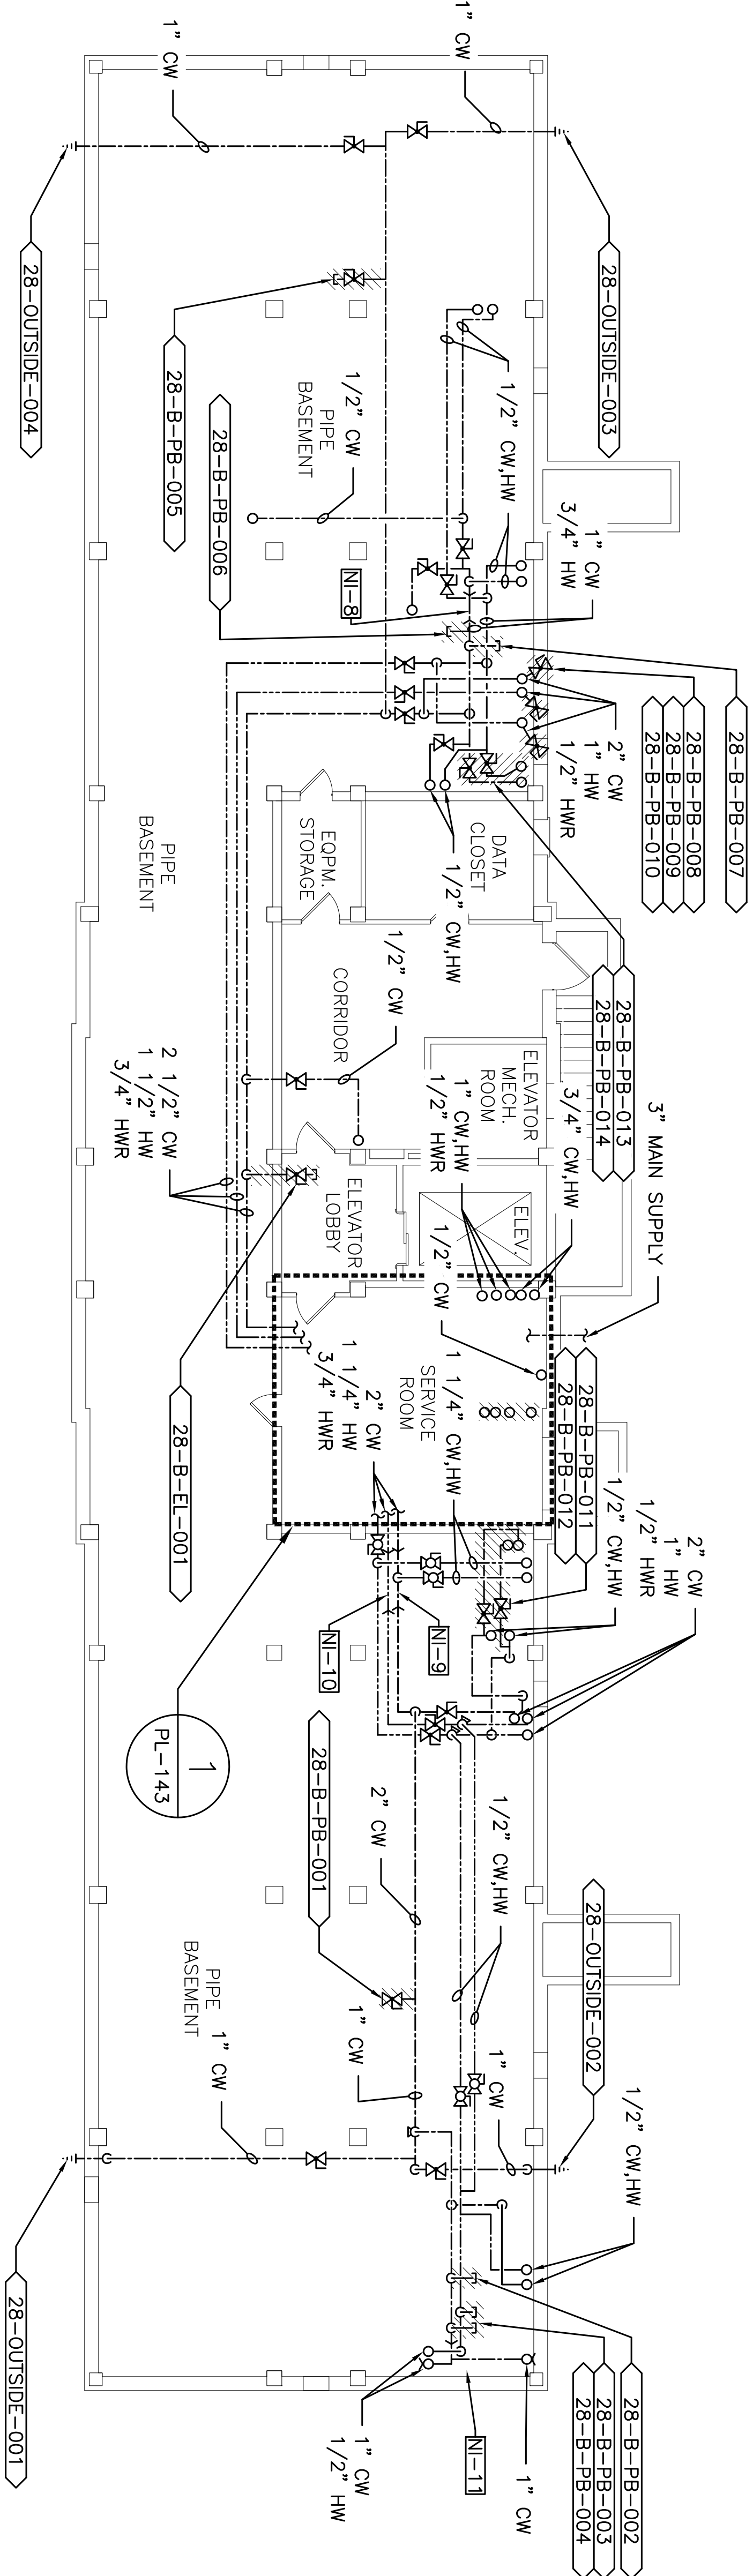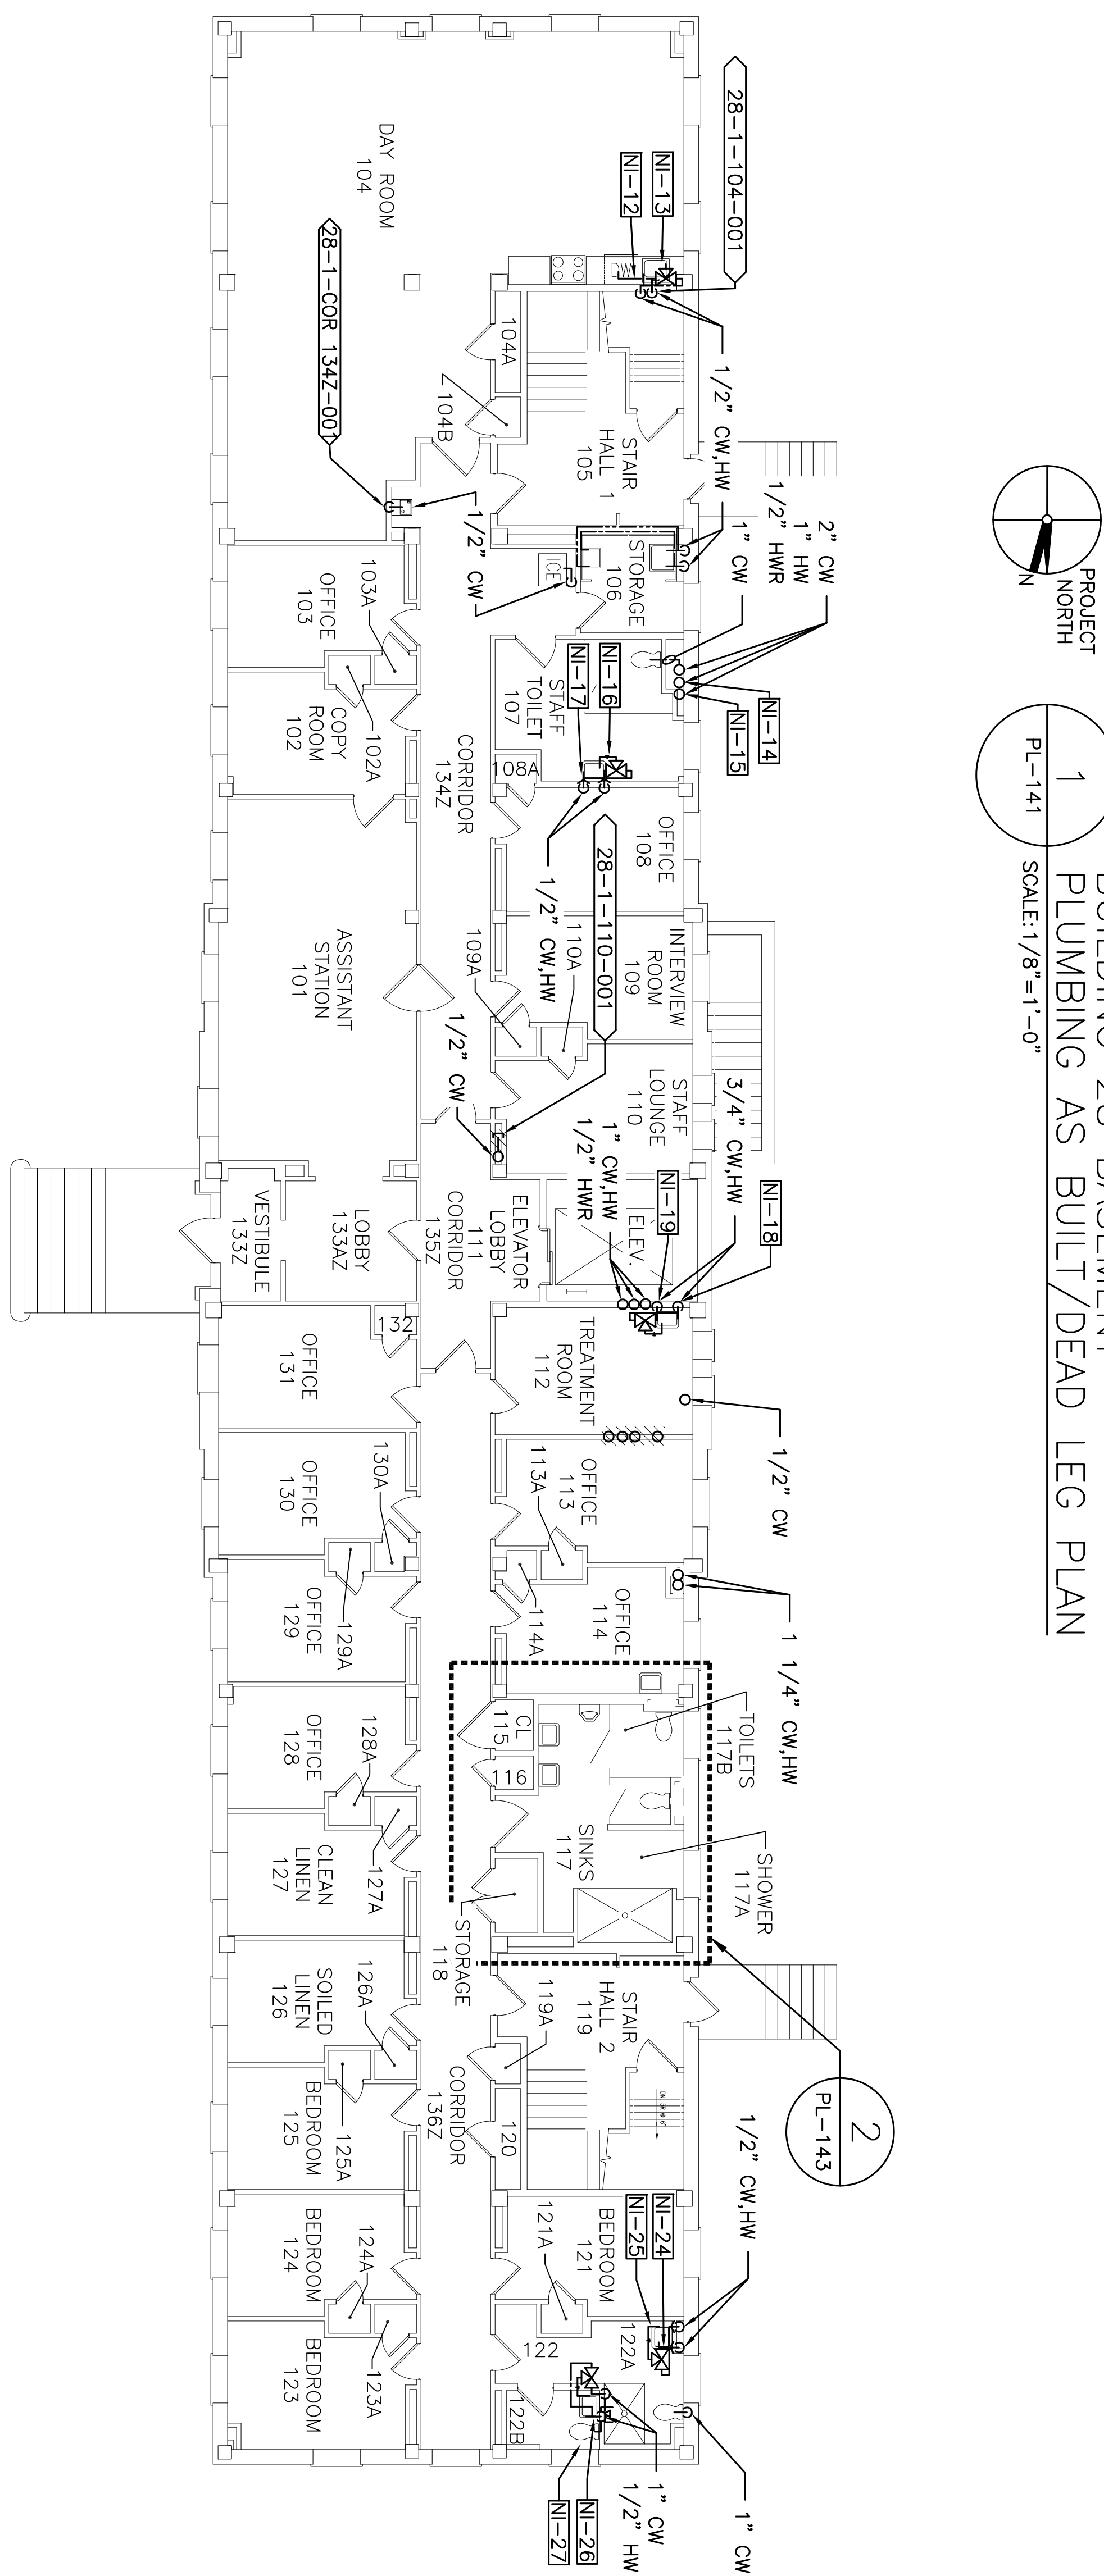

BUILDING 28 FIRST FLOOR  
PLUMBING AS BUILT/DEAD LEG PLAN

[illegible]