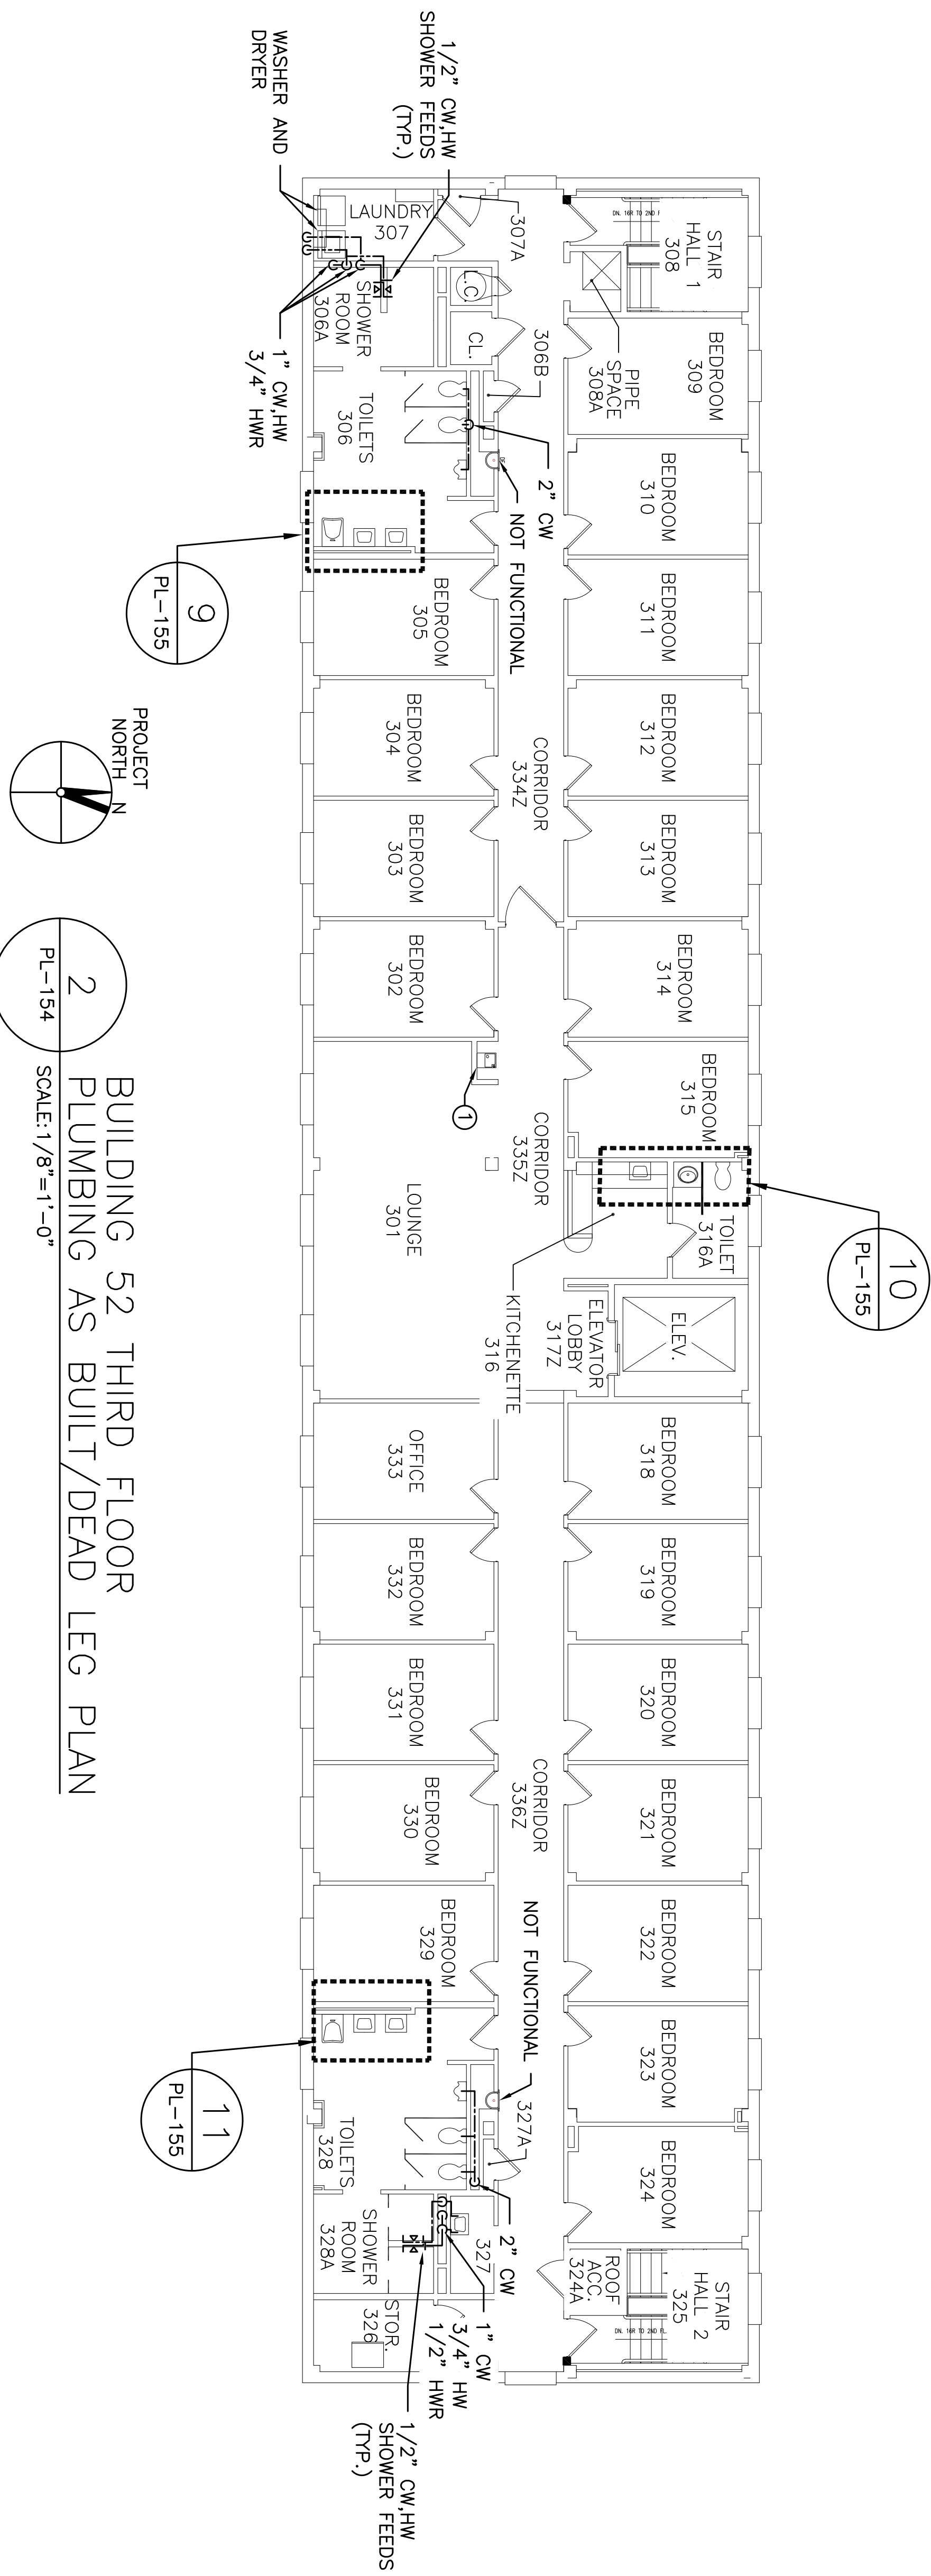
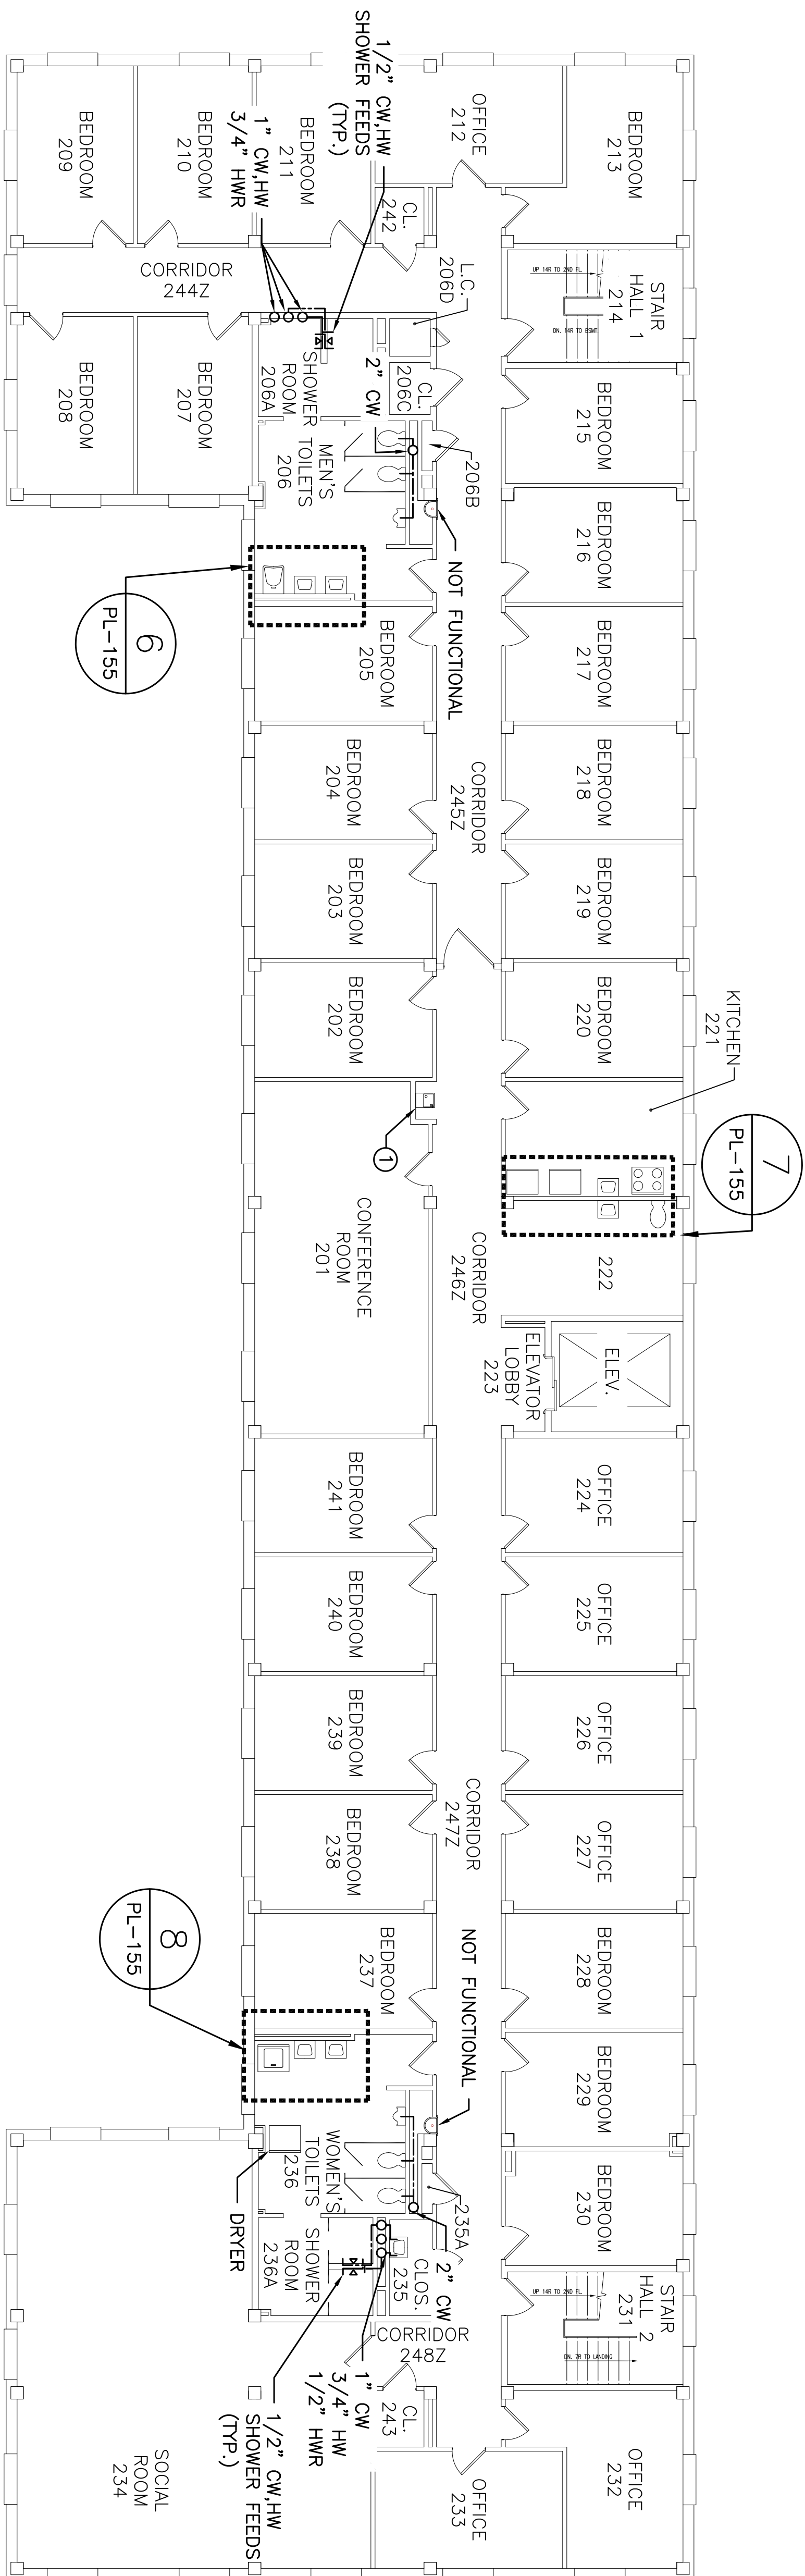


KEYED NOTE:

① ROUTING CANNOT BE CONFIRMED  
WITHOUT DEMOLITION WATER  
FOUNTAIN/WATER COOLERS ARE ACTIVE

[illegible]