PLUMBING FIELD STUDY KEY SYMBOLS	
TYPE A – PIPE LENGTH GREATER THAN TWICE THE DIAMETER OF THE PIPE SIZE TERMINATING AT CAP, VALVE, OR FITTING.	
TYPE B – PIPE LENGTH GREATER THAN TWICE THE DIAMETER OF THE PIPES TERMINATING AT AN INFREQUENTLY USED PLUMBING FIXTURE.	
TYPE C – PIPE LENGTH GREATER THAN 25 FEET TERMINATING AT A FREQUENTLY USED PLUMBING FIXTURE	
XXX–XX–XXX–XXX	DEAD LEG TAG
XXX–XX–XXX–XXX	MIXING VALVE TAG
	REMEDIATE DEAD LEG
NI–0	NON–INSULATED PIPE REFER TO SCHEDULE

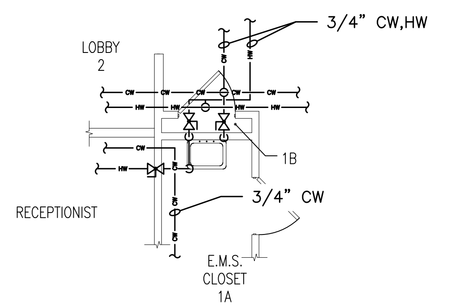

2 PL–137

BUILDING 16 GROUND FLOOR ROOM 1B ENLARGED PLAN

SCALE: 1/4"=1'–0"

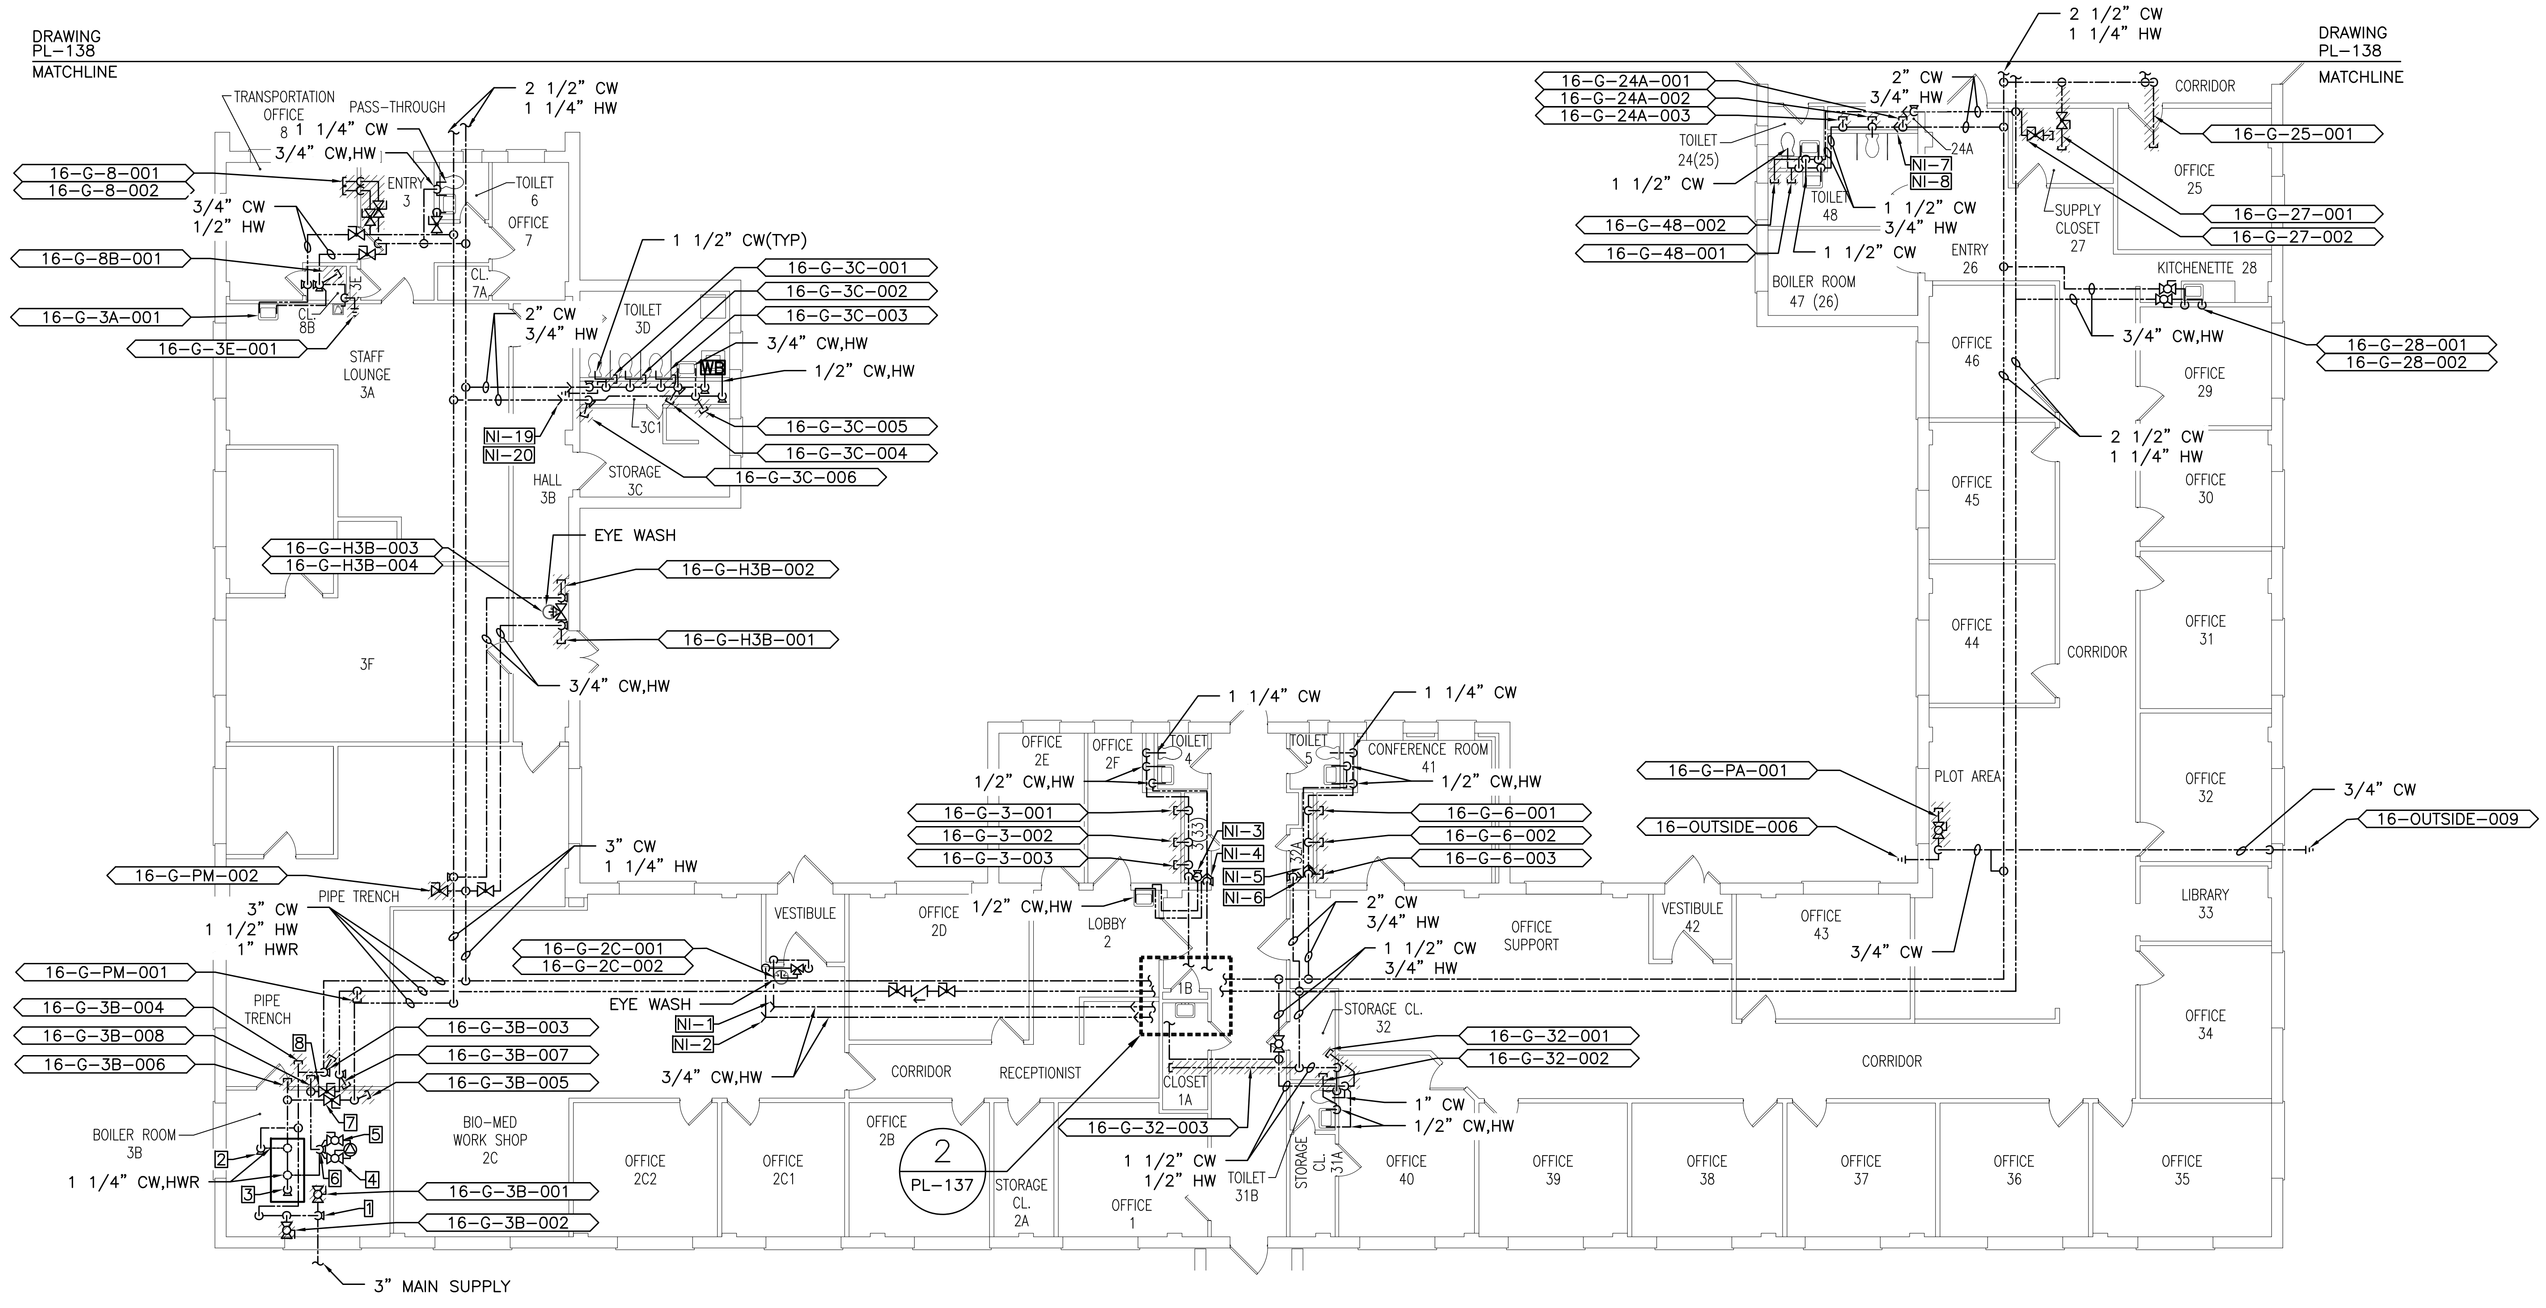

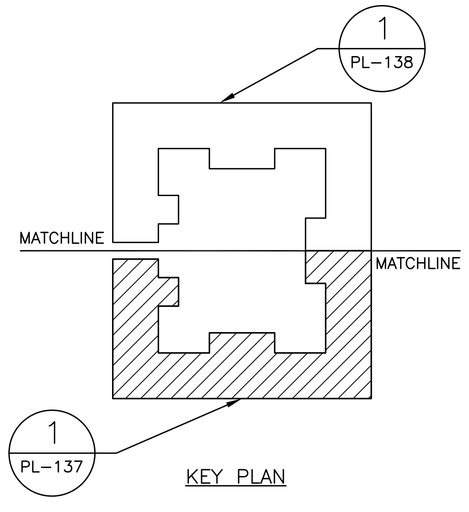

PROJECT NORTH N

1 PL–137

BUILDING 16 GROUND FLOOR PLUMBING AS BUILT/DEAD LEG PLAN A

SCALE: 1/8"=1'–0"

100% WORKING DRAWINGS SUBMISSION

100% Working Drawings Submission	03-09-2018
Revisions:	Date:

CONSULTANTS:

ARCHITECT/ENGINEERS:

NORTH:

Drawing Title	Building 16 Ground Floor Plumbing As-Built / Dead-Leg Plan / Enlarged Plan
Project Title	Remove Domestic Dead-Legs at the Montrose Campus
Project Number	620-18-119
Building(s) Number	16
Approved: Facility Director , VAHVHCS:	
Location	Montrose, New York
Drawing Number	PL 137
Approved: John Cliffe, Facility Chief of Engineering	
Date	03-08-2018
Checked	MR
Drawn	MF
Sheet	59 of 77

Engineering Service

Department of Veterans Affairs

VA FORM 08–6231, OCT 1978