PLUMBING FIELD STUDY KEY SYMBOLS	
TYPE A – PIPE LENGTH GREATER THAN TWICE THE DIAMETER OF THE PIPE SIZE TERMINATING AT CAP, VALVE, OR FITTING.	
TYPE B – PIPE LENGTH GREATER THAN TWICE THE DIAMETER OF THE PIPES TERMINATING AT AN INFREQUENTLY USED PLUMBING FIXTURE.	
TYPE C – PIPE LENGTH GREATER THAN 25 FEET TERMINATING AT A FREQUENTLY USED PLUMBING FIXTURE	
XXX–XX–XXX–XXX	DEAD LEG TAG
XXX–XX–XXX–XXX	MIXING VALVE TAG
	REMEDIATE DEAD LEG
NI–0	NON–INSULATED PIPE REFER TO SCHEDULE

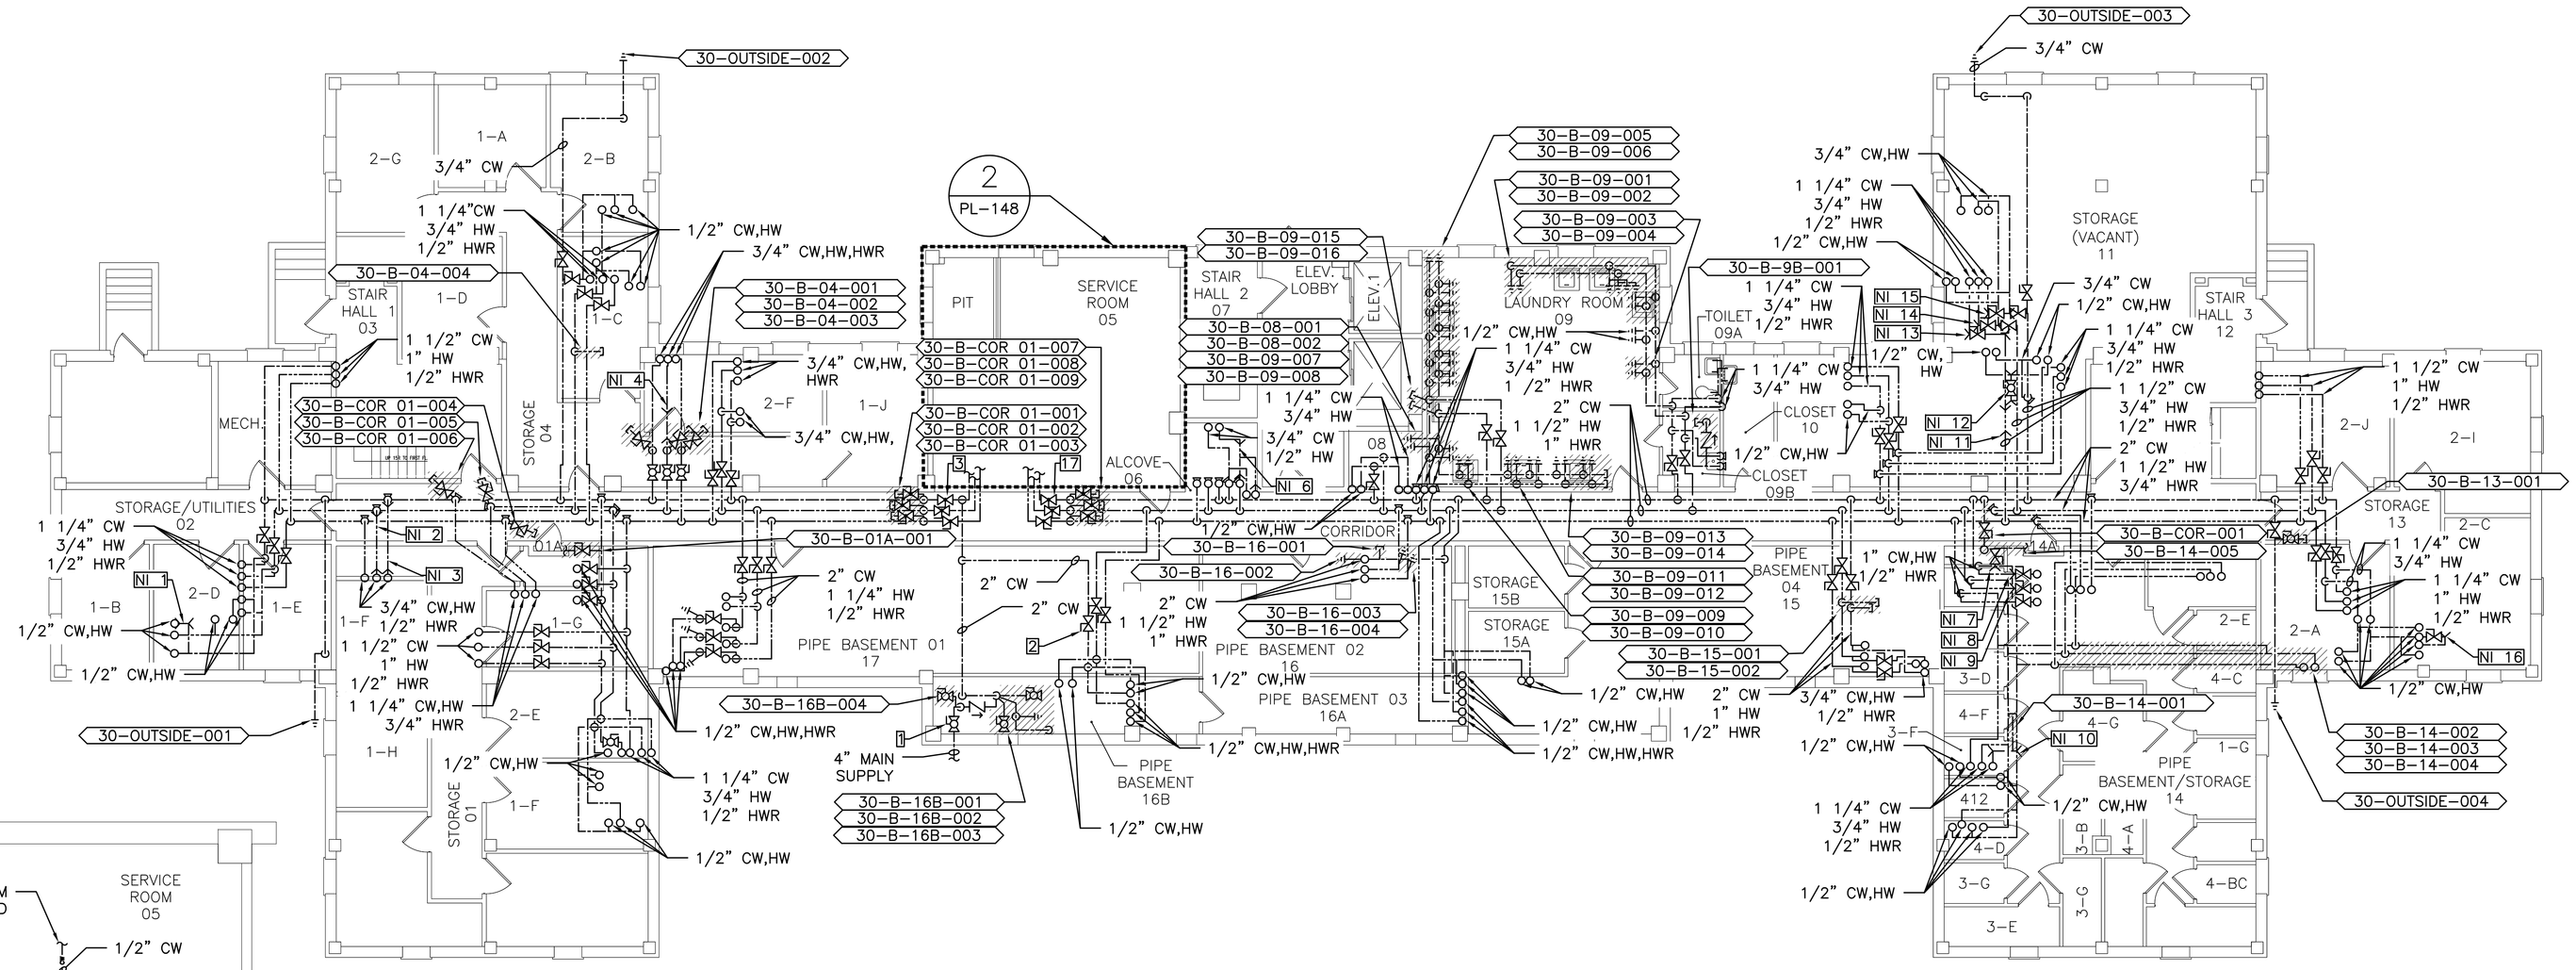

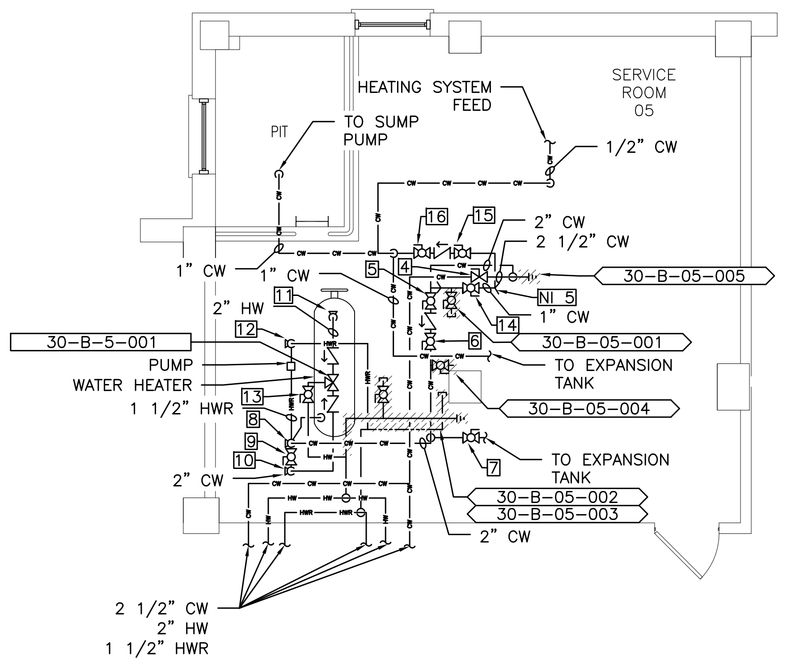

N PROJECT NORTH

2 PL–148 BUILDING 30 PIPE BASEMENT SERVICE ROOM 05 ENLARGED PLAN

SCALE: 1/4"=1'–0"

N PROJECT NORTH

1 PL–148 BUILDING 30 BASEMENT PLUMBING AS BUILT/DEAD LEG PLAN

SCALE: 1/8"=1'–0"

100% WORKING DRAWINGS SUBMISSION

100% Working Drawings Submission	03-09-2018
Revisions:	Date:

CONSULTANTS:

ARCHITECT/ENGINEERS:

NORTH:

Drawing Title: Building 30 Basement Plumbing As-Built / Dead-Leg Plan

Project Title: Remove Domestic Dead-Legs at the Montrose Campus

Project Number: 620-18-119

Building(s) Number: 30

Approved: Facility Director , VAHVHCS:

Location: Montrose, New York

Drawing Number: PL 148

Approved: John Cliffe, Facility Chief of Engineering

Date: 03-08-2018 | Checked: MR | Drawn: MF

Sheet 70 of 77

Engineering Service

Department of Veterans Affairs

VA FORM 08–6231, OCT 1978