PLUMBING FIELD STUDY KEY SYMBOLS	
TYPE A – PIPE LENGTH GREATER THAN TWICE THE DIAMETER OF THE PIPE SIZE TERMINATING AT CAP, VALVE, OR FITTING.	
TYPE B – PIPE LENGTH GREATER THAN TWICE THE DIAMETER OF THE PIPES TERMINATING AT AN INFREQUENTLY USED PLUMBING FIXTURE.	
TYPE C – PIPE LENGTH GREATER THAN 25 FEET TERMINATING AT A FREQUENTLY USED PLUMBING FIXTURE	
XXX–XX–XXX–XXX	DEAD LEG TAG
XXX–XX–XXX–XXX	MIXING VALVE TAG
	REMEDIATE DEAD LEG
NI–0	NON–INSULATED PIPE REFER TO SCHEDULE

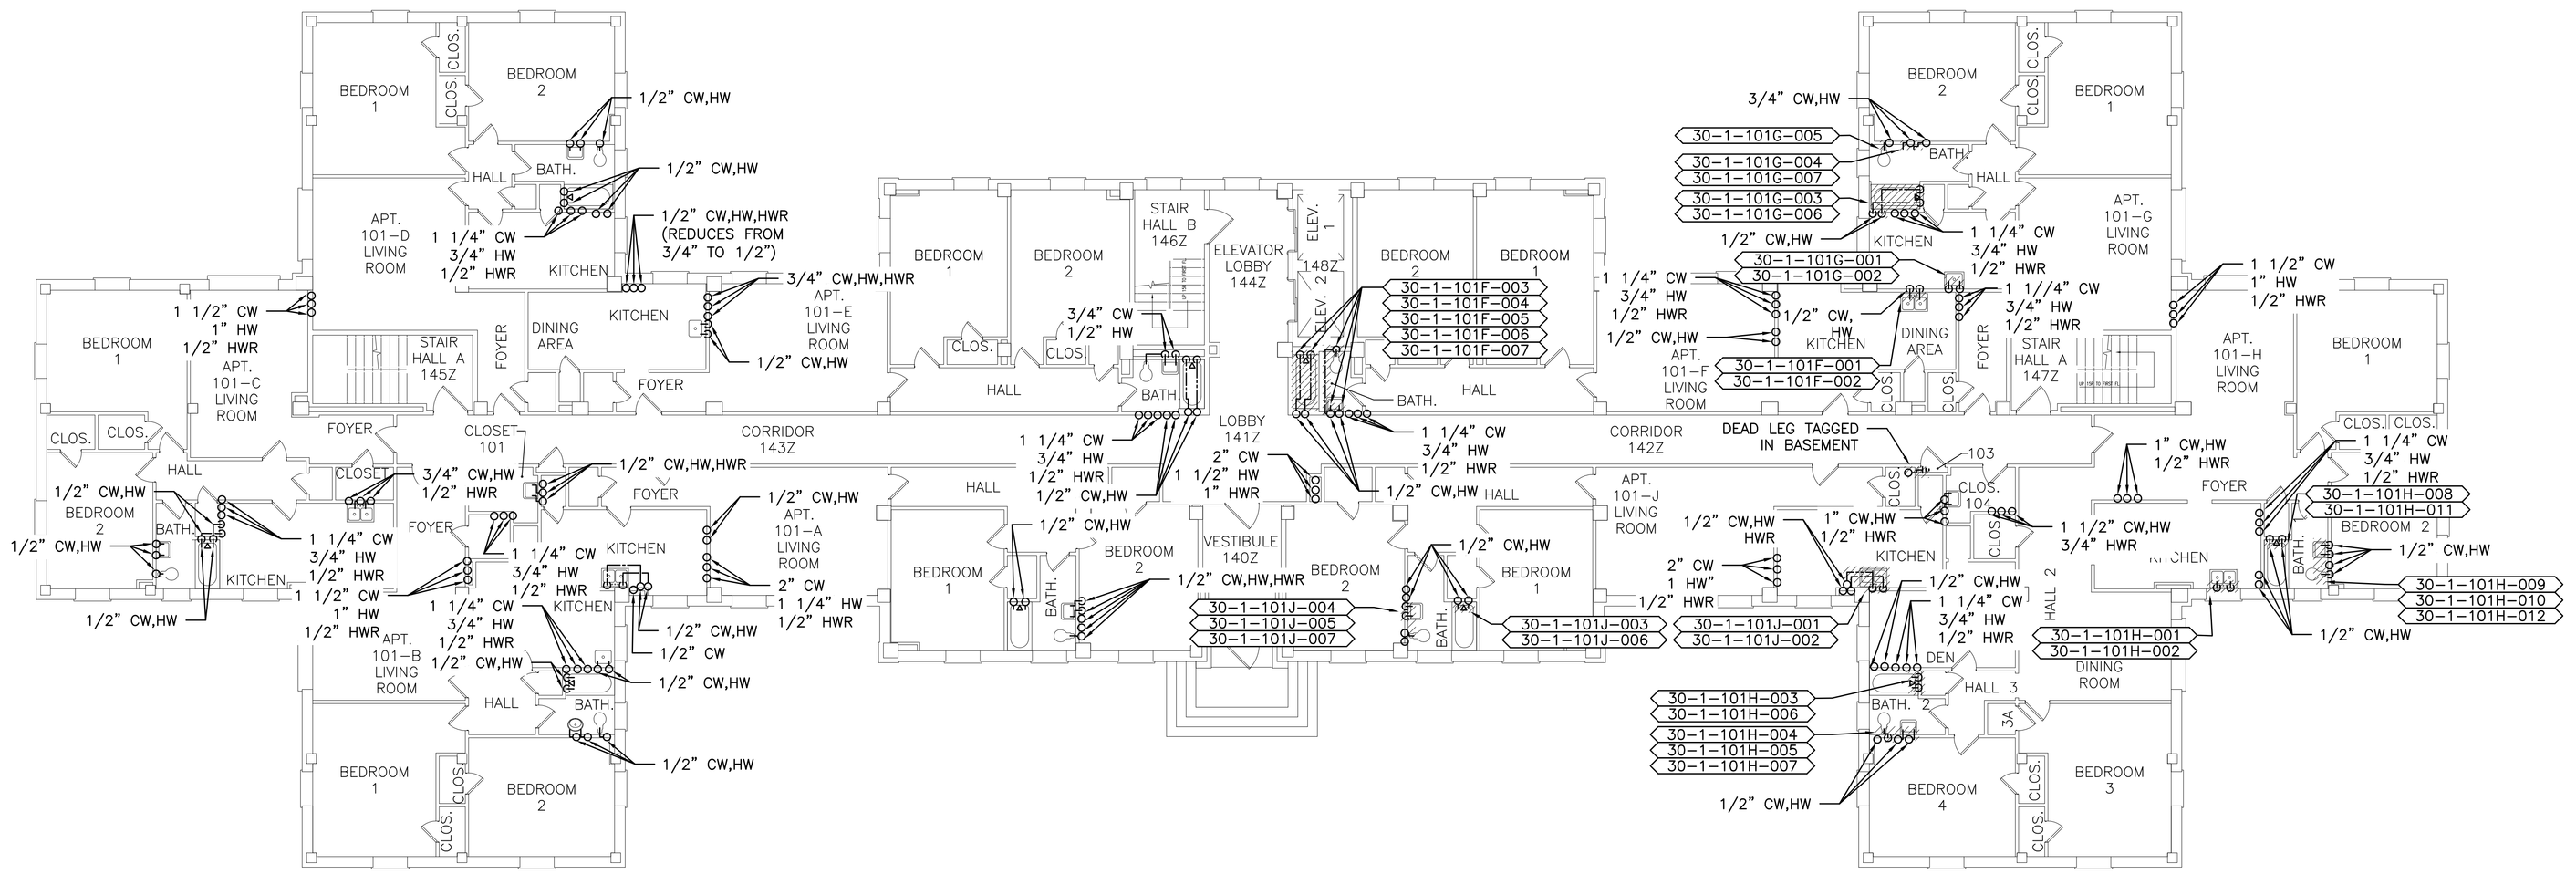

N
PROJECT NORTH

1
PL–149

BUILDING 30 FIRST FLOOR
PLUMBING AS BUILT/DEAD LEG PLAN
SCALE: 1/8"=1'–0"

100% WORKING DRAWINGS SUBMISSION

100% Working Drawings Submission	03-09-2018
Revisions:	Date:

CONSULTANTS:

ARCHITECT/ENGINEERS:

NORTH:

Drawing Title: Building 30 First Floor Plumbing As-Built / Dead-Leg Plan

Project Title: Remove Domestic Dead-Legs at the Montrose Campus

Project Number: 620-18-119

Building(s) Number: 30

Drawing Number: PL 149

Sheet 71 of 77

Approved: Facility Director , VAHVHCS:

Approved: John Cliffe, Facility Chief of Engineering

Location: Montrose, New York

Date	Checked	Drawn
03-08-2018	MR	MF

Engineering Service

Department of Veterans Affairs

VA FORM 08–6231, OCT 1978