PLUMBING FIELD STUDY KEY SYMBOLS	
TYPE A – PIPE LENGTH GREATER THAN TWICE THE DIAMETER OF THE PIPE SIZE TERMINATING AT CAP, VALVE, OR FITTING.	
TYPE B – PIPE LENGTH GREATER THAN TWICE THE DIAMETER OF THE PIPES TERMINATING AT AN INFREQUENTLY USED PLUMBING FIXTURE.	
TYPE C – PIPE LENGTH GREATER THAN 25 FEET TERMINATING AT A FREQUENTLY USED PLUMBING FIXTURE	
XXX–XX–XXX–XXX	DEAD LEG TAG
XXX–XX–XXX–XXX	MIXING VALVE TAG
	REMEDIATE DEAD LEG
NI–0	NON–INSULATED PIPE REFER TO SCHEDULE

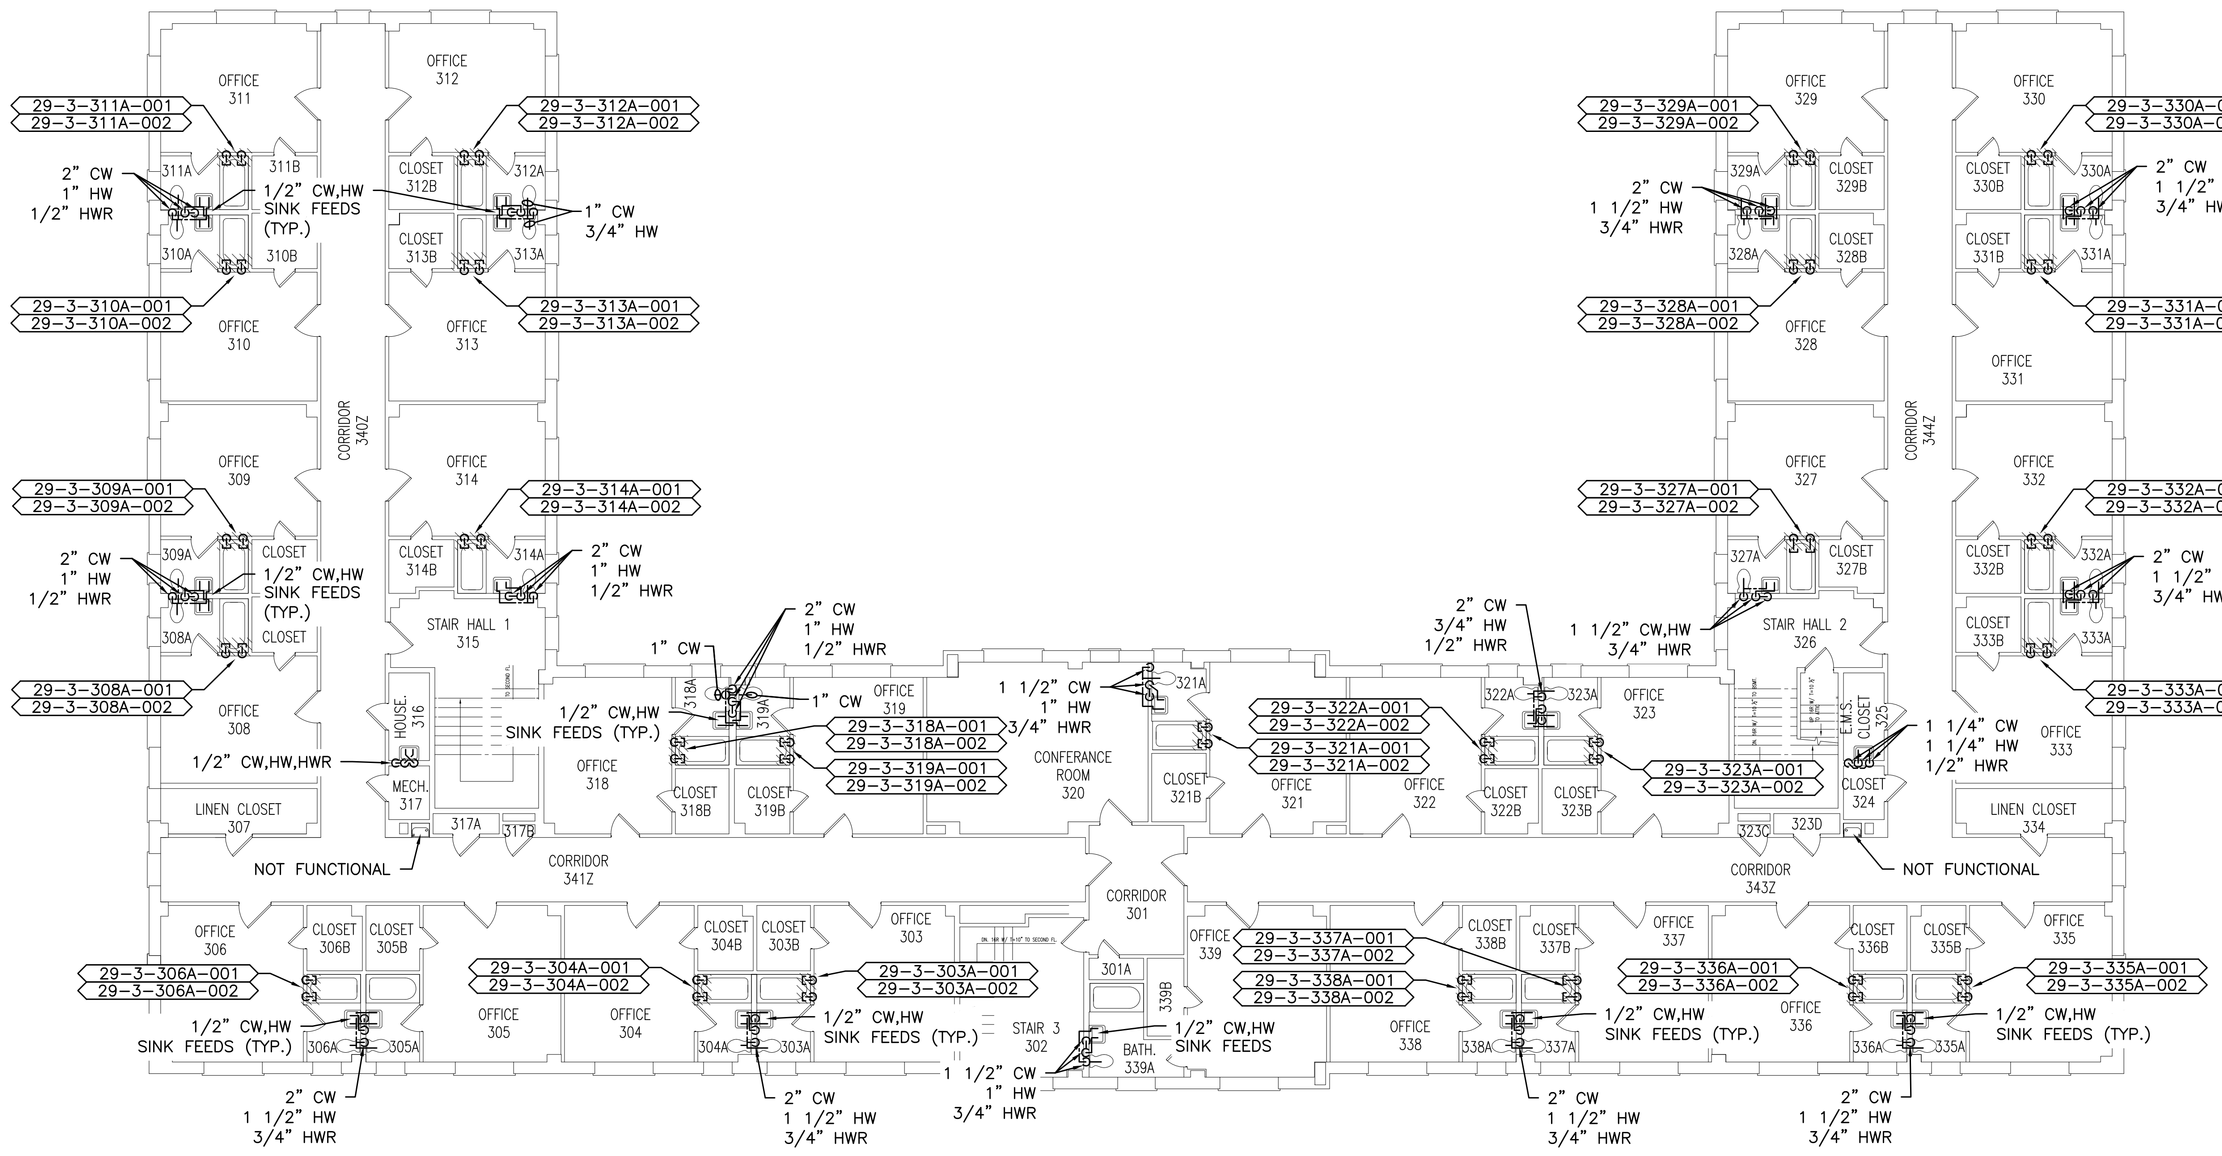

PROJECT NORTH

1 / PL–147

BUILDING 29 THIRD FLOOR
PLUMBING AS BUILT/DEAD LEG PLAN

SCALE: 1/8"=1'–0"

100% WORKING DRAWINGS SUBMISSION

100% Working Drawings Submission	03-09-2018
Revisions:	Date:

CONSULTANTS:

ARCHITECT/ENGINEERS:

NORTH:

Drawing Title	Building 29 Third Floor Plumbing As-Built / Dead-Leg Plan
Approved: Facility Director , VAHVHCS:	
Approved: John Cliffe, Facility Chief of Engineering	
Project Title	Remove Domestic Dead-Legs at the Montrose Campus
Location	Montrose, New York
Date	03-08-2018
Checked	MR
Drawn	MF
Project Number	620-18-119
Building(s) Number	29
Drawing Number	PL 147
Sheet	69 of 77

Engineering Service

Department of Veterans Affairs

VA FORM 08–6231, OCT 1978