| PLUMBING FIELD STUDY KEY SYMBOLS | |
|---|---|
| TYPE A – PIPE LENGTH GREATER THAN TWICE THE DIAMETER OF THE PIPE SIZE TERMINATING AT CAP, VALVE, OR FITTING. | |
| TYPE B – PIPE LENGTH GREATER THAN TWICE THE DIAMETER OF THE PIPES TERMINATING AT AN INFREQUENTLY USED PLUMBING FIXTURE. | |
| TYPE C – PIPE LENGTH GREATER THAN 25 FEET TERMINATING AT A FREQUENTLY USED PLUMBING FIXTURE | |
| XXX–XX–XXX–XXX | DEAD LEG TAG |
| XXX–XX–XXX–XXX | MIXING VALVE TAG |
| | REMEDIATE DEAD LEG |
| NI–0 | NON–INSULATED PIPE REFER TO SCHEDULE |

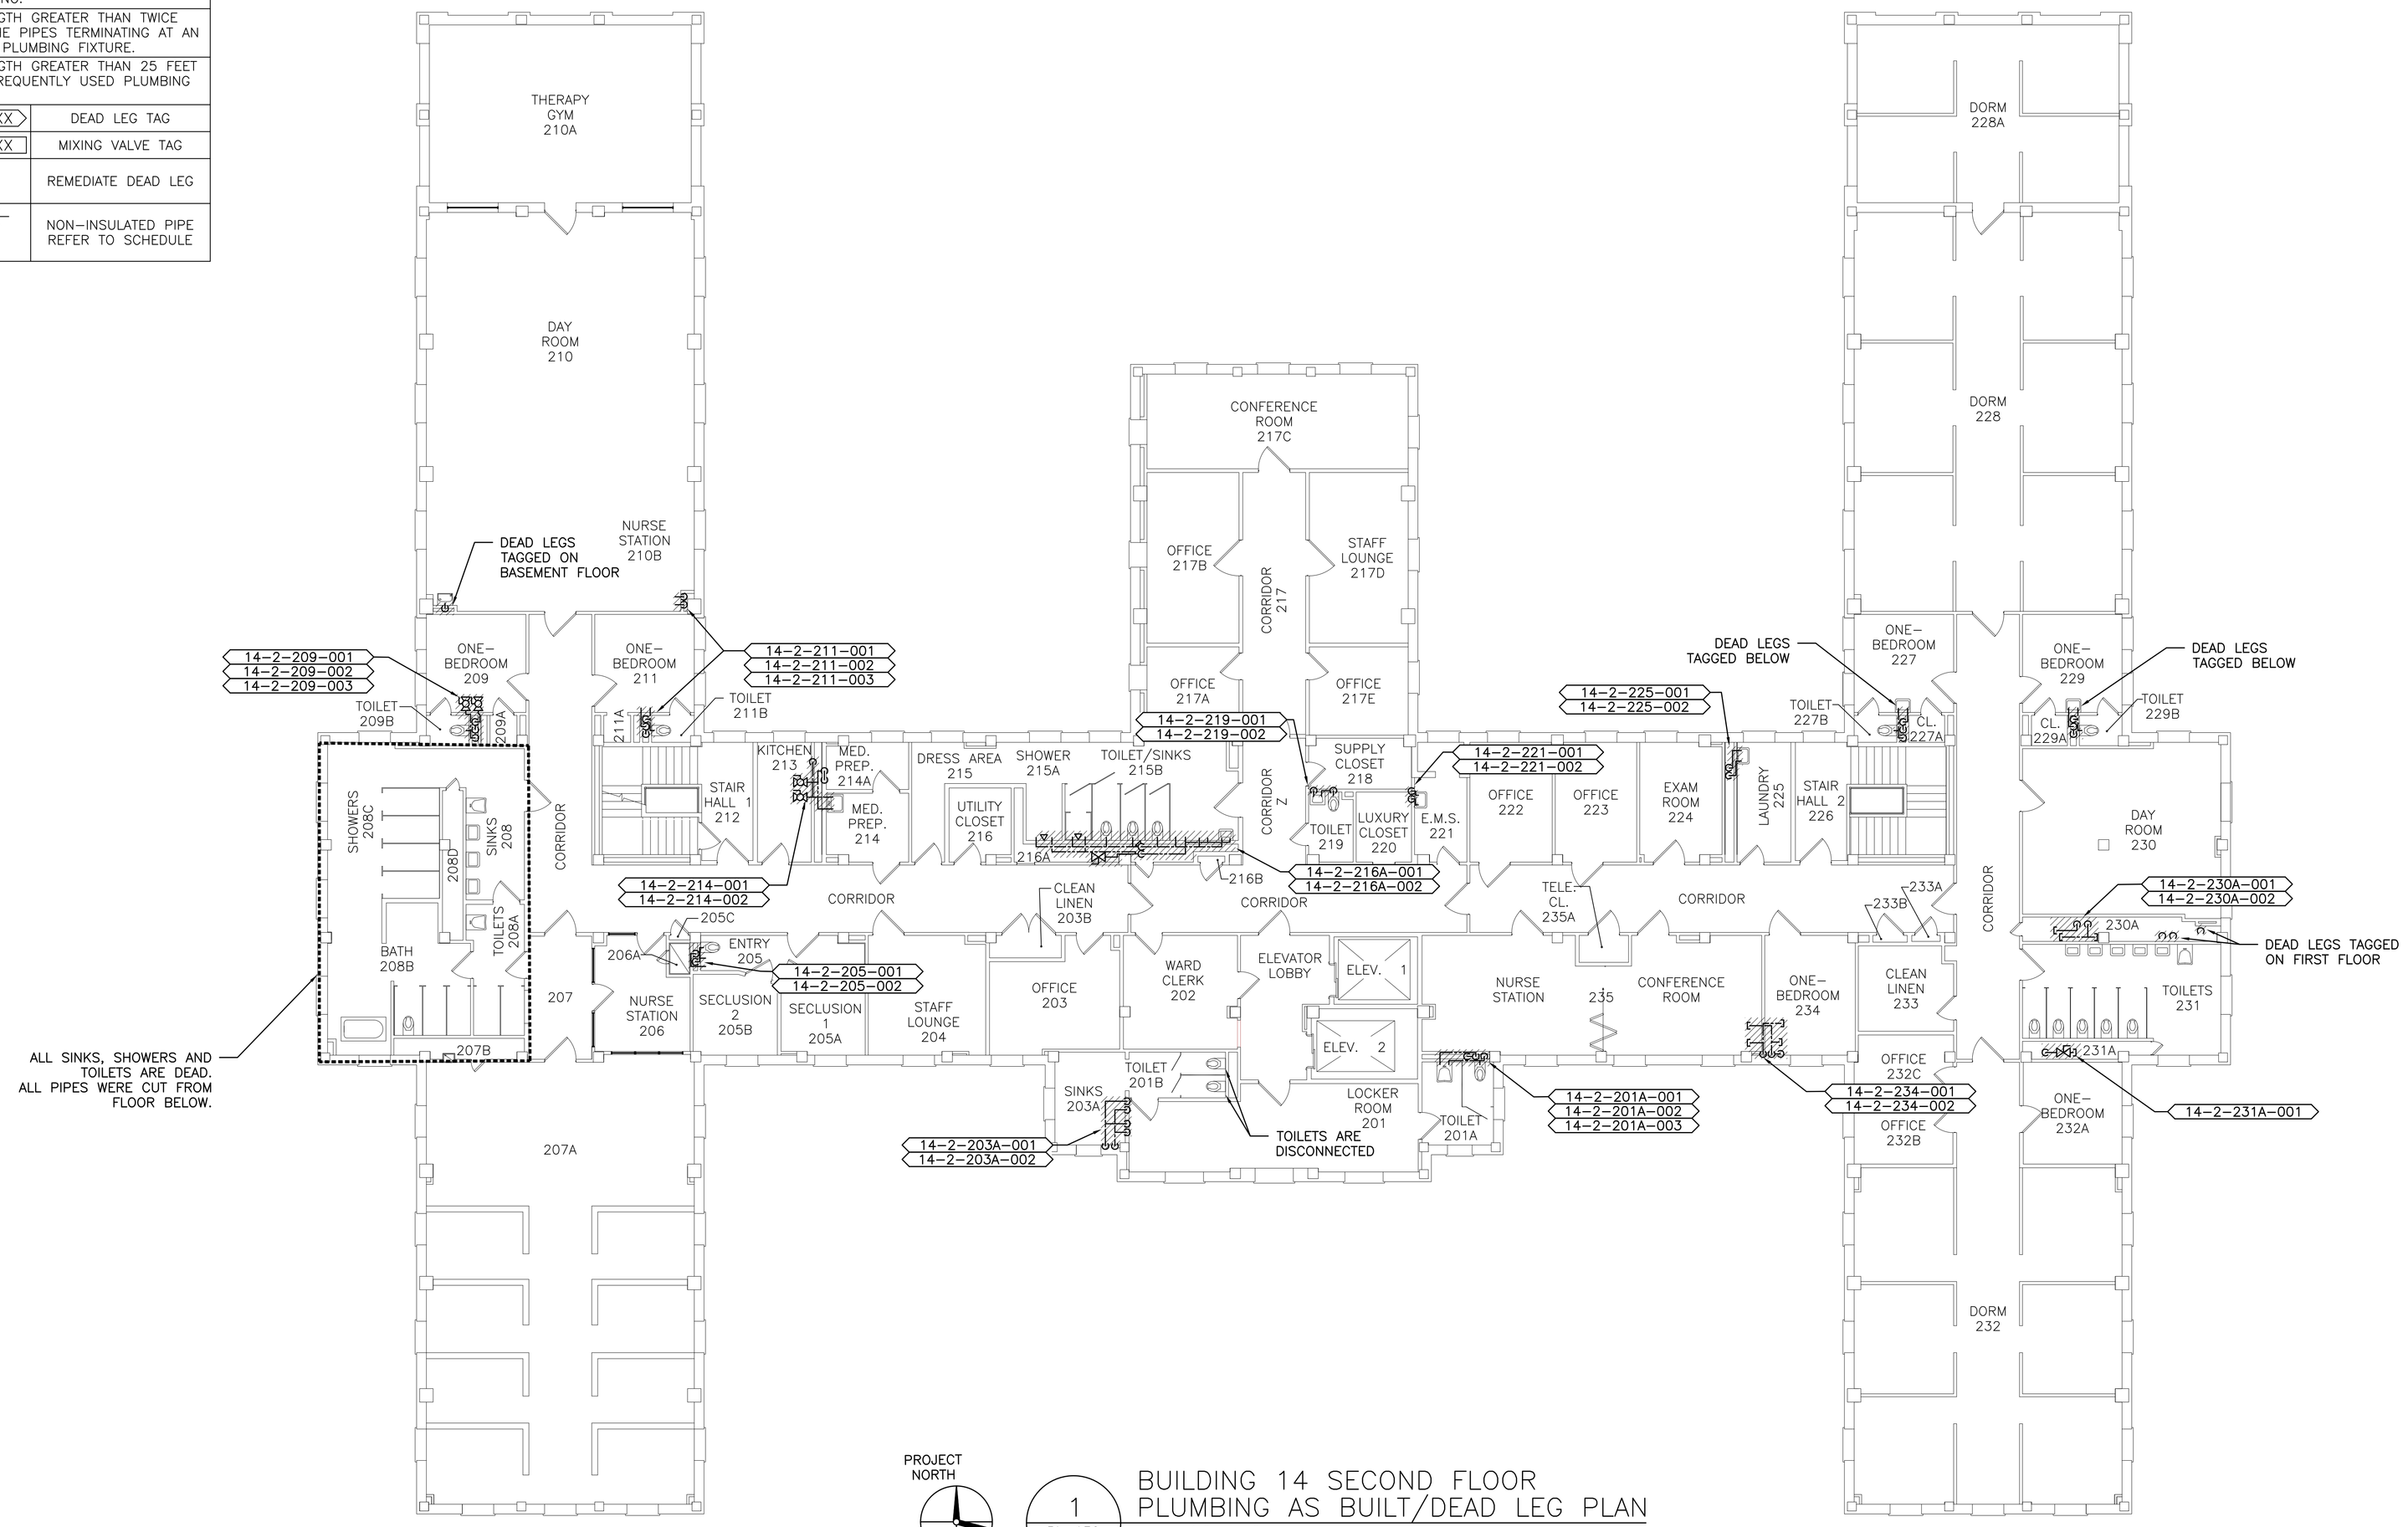


1 PL–130 BUILDING 14 SECOND FLOOR PLUMBING AS BUILT/DEAD LEG PLAN
SCALE: 1/8"=1'–0"

100% WORKING DRAWINGS SUBMISSION

| | |
|---|---|
| 100% Working Drawings Submission | 03-09-2018 |
| Revisions: | Date: |

CONSULTANTS:

ARCHITECT/ENGINEERS:

NORTH:

| | |
|---|---|
| Drawing Title | Building 14 Second Floor Plumbing As-Built / Dead-Leg Plan |
| Project Title | Remove Domestic Dead-Legs at the Montrose Campus |
| Project Number | 620-18-119 |
| Building(s) Number | 14 |
| Location | Montrose, New York |
| Drawing Number | PL 130 |
| Approved: Facility Director , VAHVHCS: | |
| Approved: John Cliffe, Facility Chief of Engineering | |
| Date | 03-08-2018 |
| Checked | MR |
| Drawn | MF |
| Sheet | 52 of 77 |

Engineering Service

Department of Veterans Affairs

VA FORM 08–6231, OCT 1978