




PLUMBING FIELD STUDY KEY SYMBOLS	
TYPE A – PIPE LENGTH GREATER THAN TWICE THE DIAMETER OF THE PIPE SIZE TERMINATING AT CAP, VALVE, OR FITTING.	
TYPE B – PIPE LENGTH GREATER THAN TWICE THE DIAMETER OF THE PIPES TERMINATING AT AN INFREQUENTLY USED PLUMBING FIXTURE.	
TYPE C – PIPE LENGTH GREATER THAN 25 FEET TERMINATING AT A FREQUENTLY USED PLUMBING FIXTURE	
<XXX-XX-XXX-XXX>	DEAD LEG TAG
XXX-XX-XXX-XXX	MIXING VALVE TAG
//////	REMEDiate DEAD LEG
NI-0	NON-INSULATED PIPE REFER TO SCHEDULE

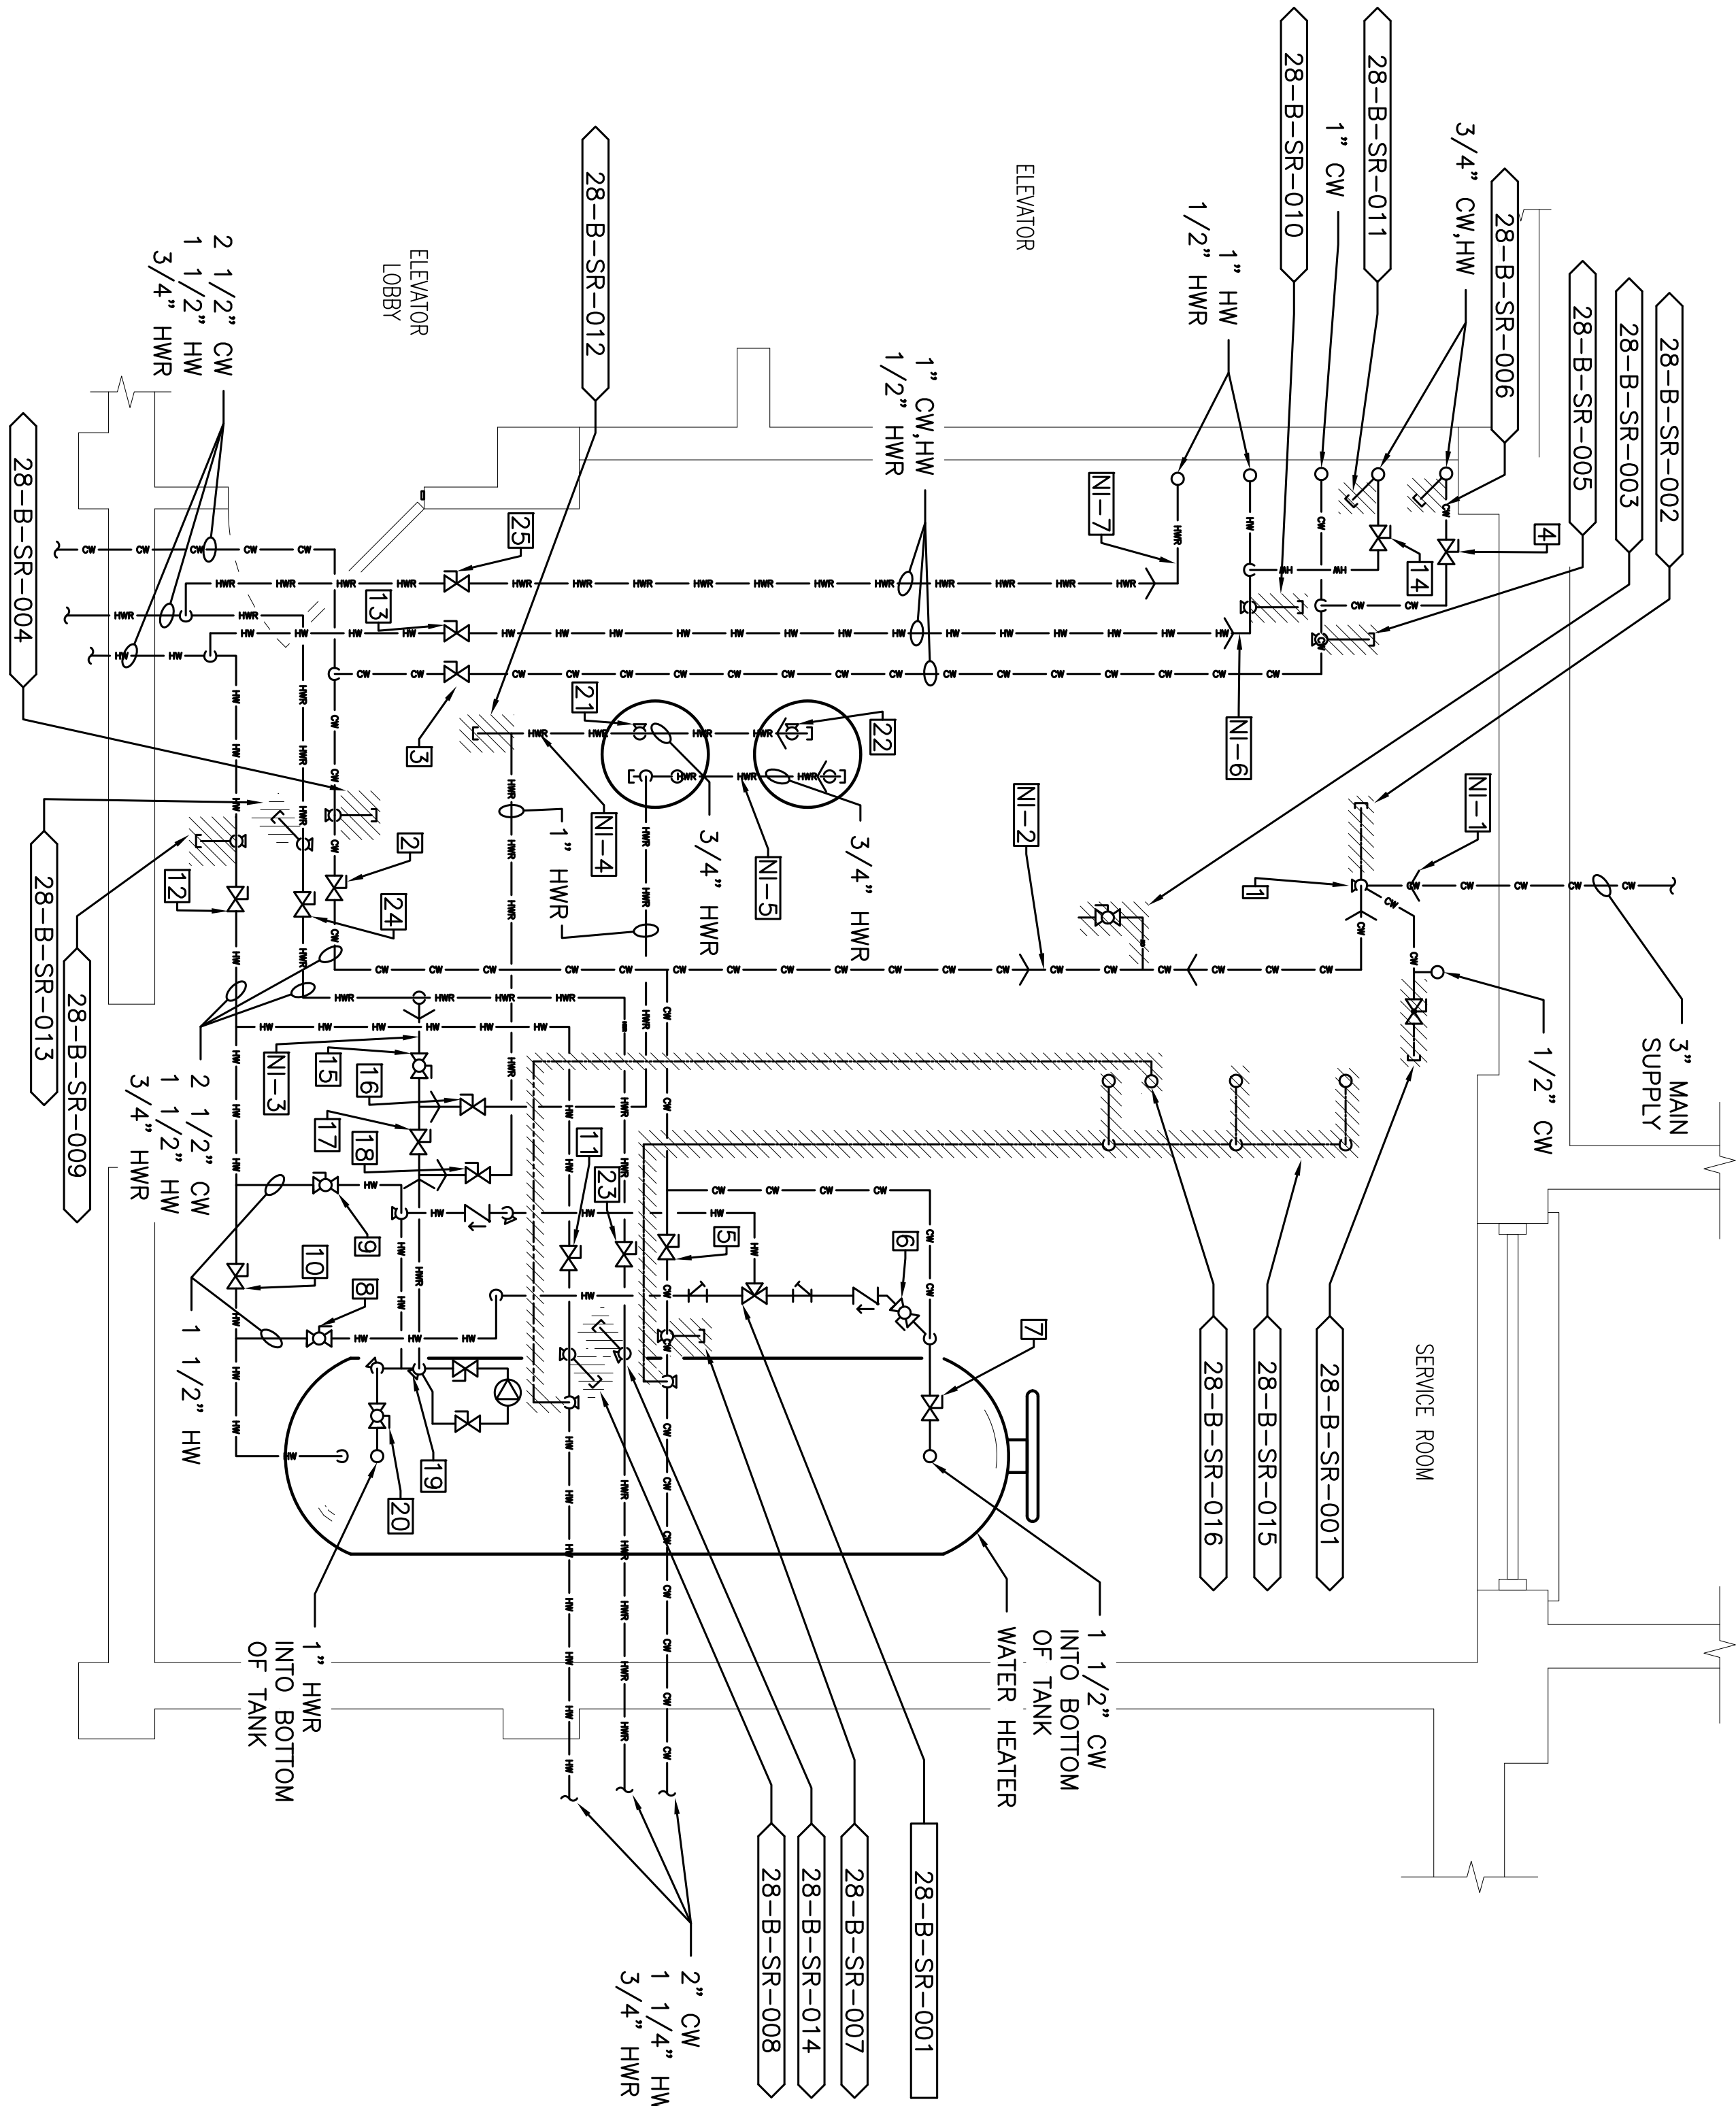


BUILDING 28 BASEMENT SERVICE ROOM ENLARGED PLAN
PL-143
SCALE: 1/2" = 1'-0"

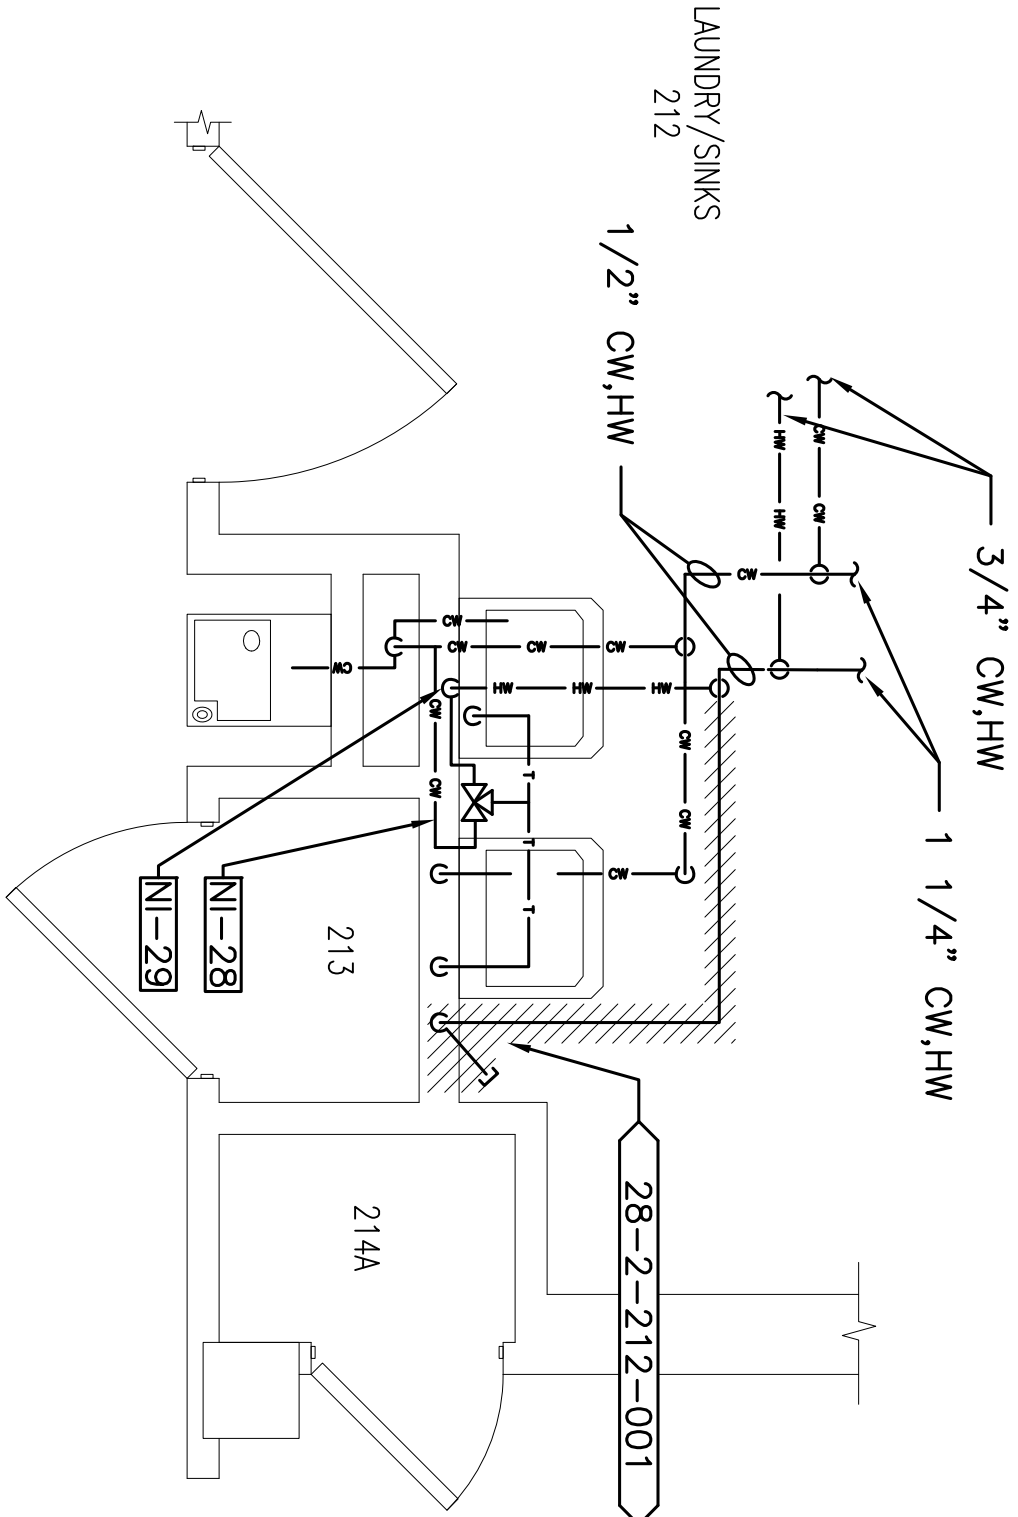


BUILDING 28 SECOND FLOOR ROOM 212 ENLARGED PLAN
PL-143
SCALE: 1/2" = 1'-0"

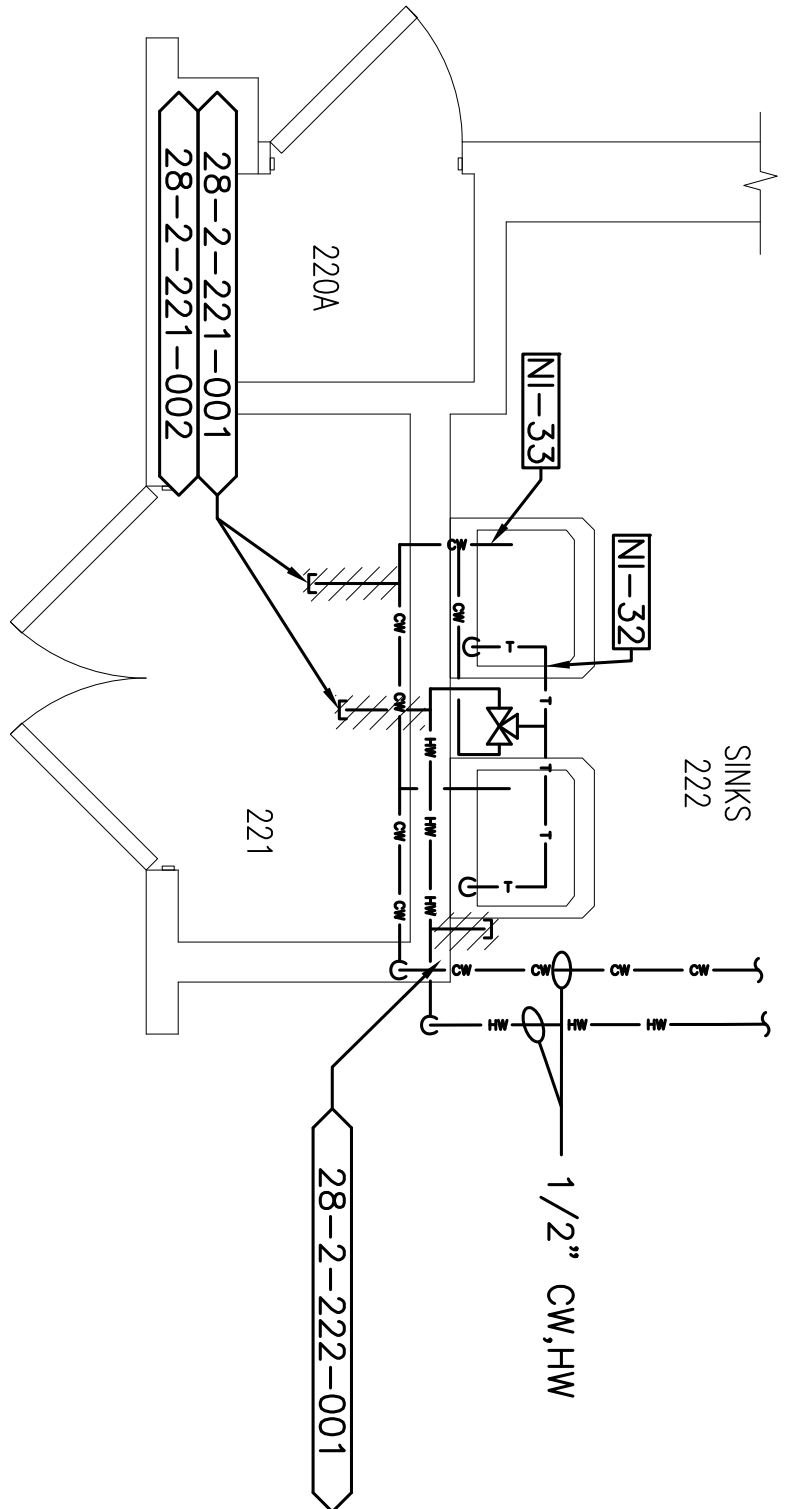


BUILDING 28 SECOND FLOOR ROOM 222 ENLARGED PLAN
PL-143
SCALE: 1/2" = 1'-0"

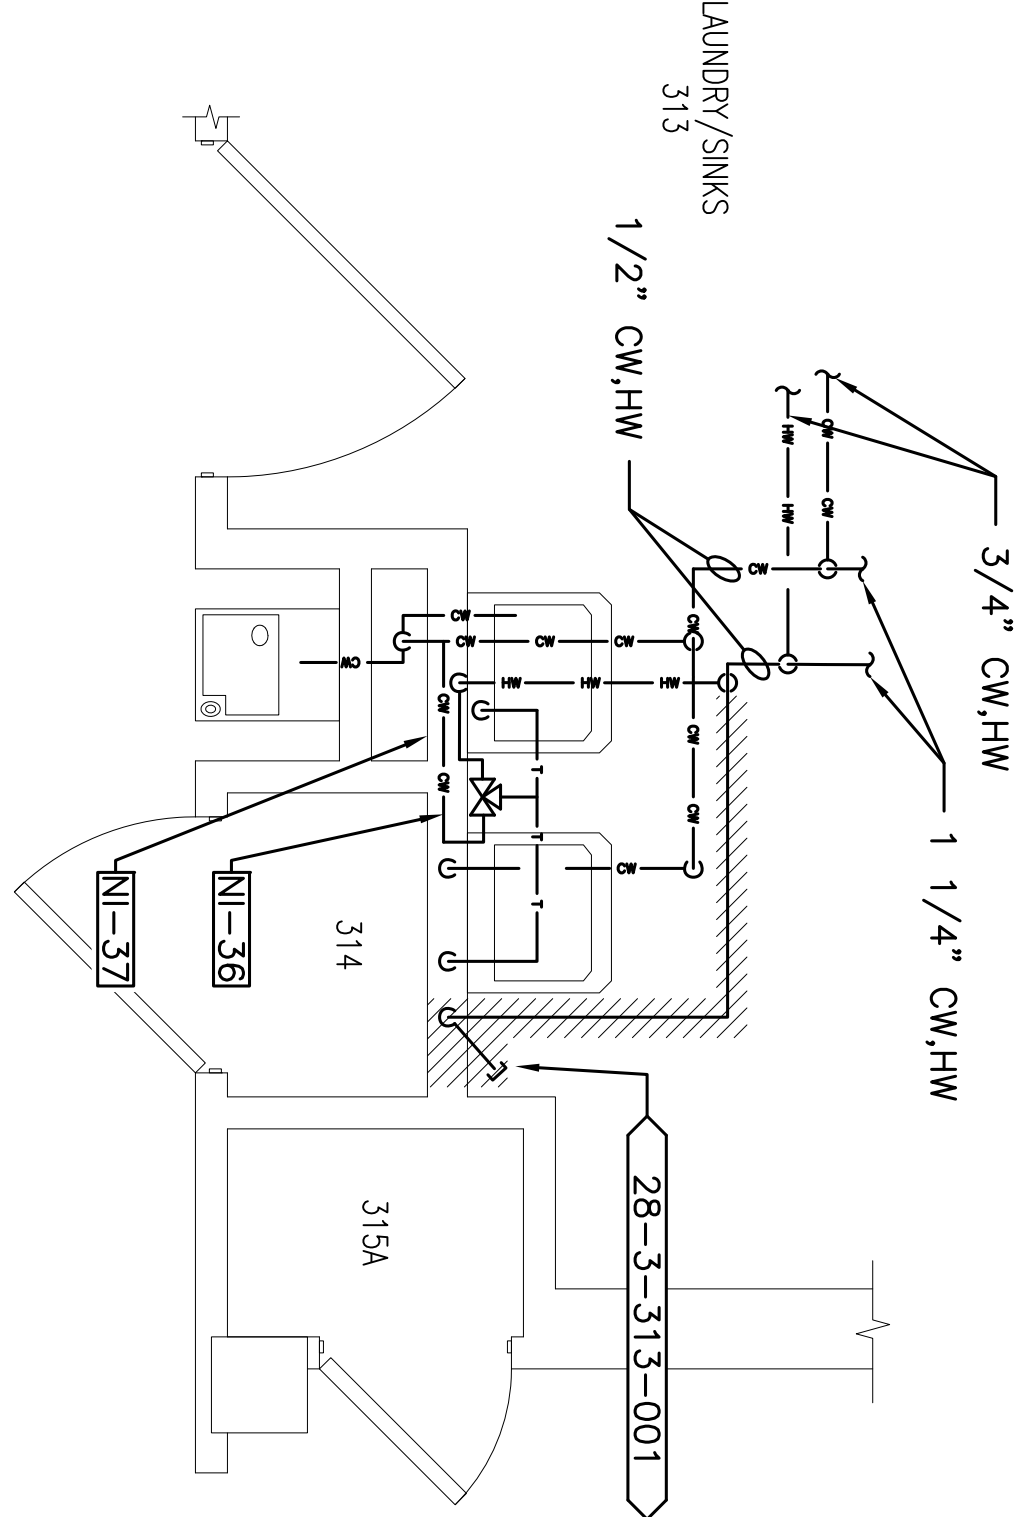









BUILDING 28 THIRD FLOOR ROOM 313 ENLARGED PLAN
PL-143
SCALE: 1/2" = 1'-0"

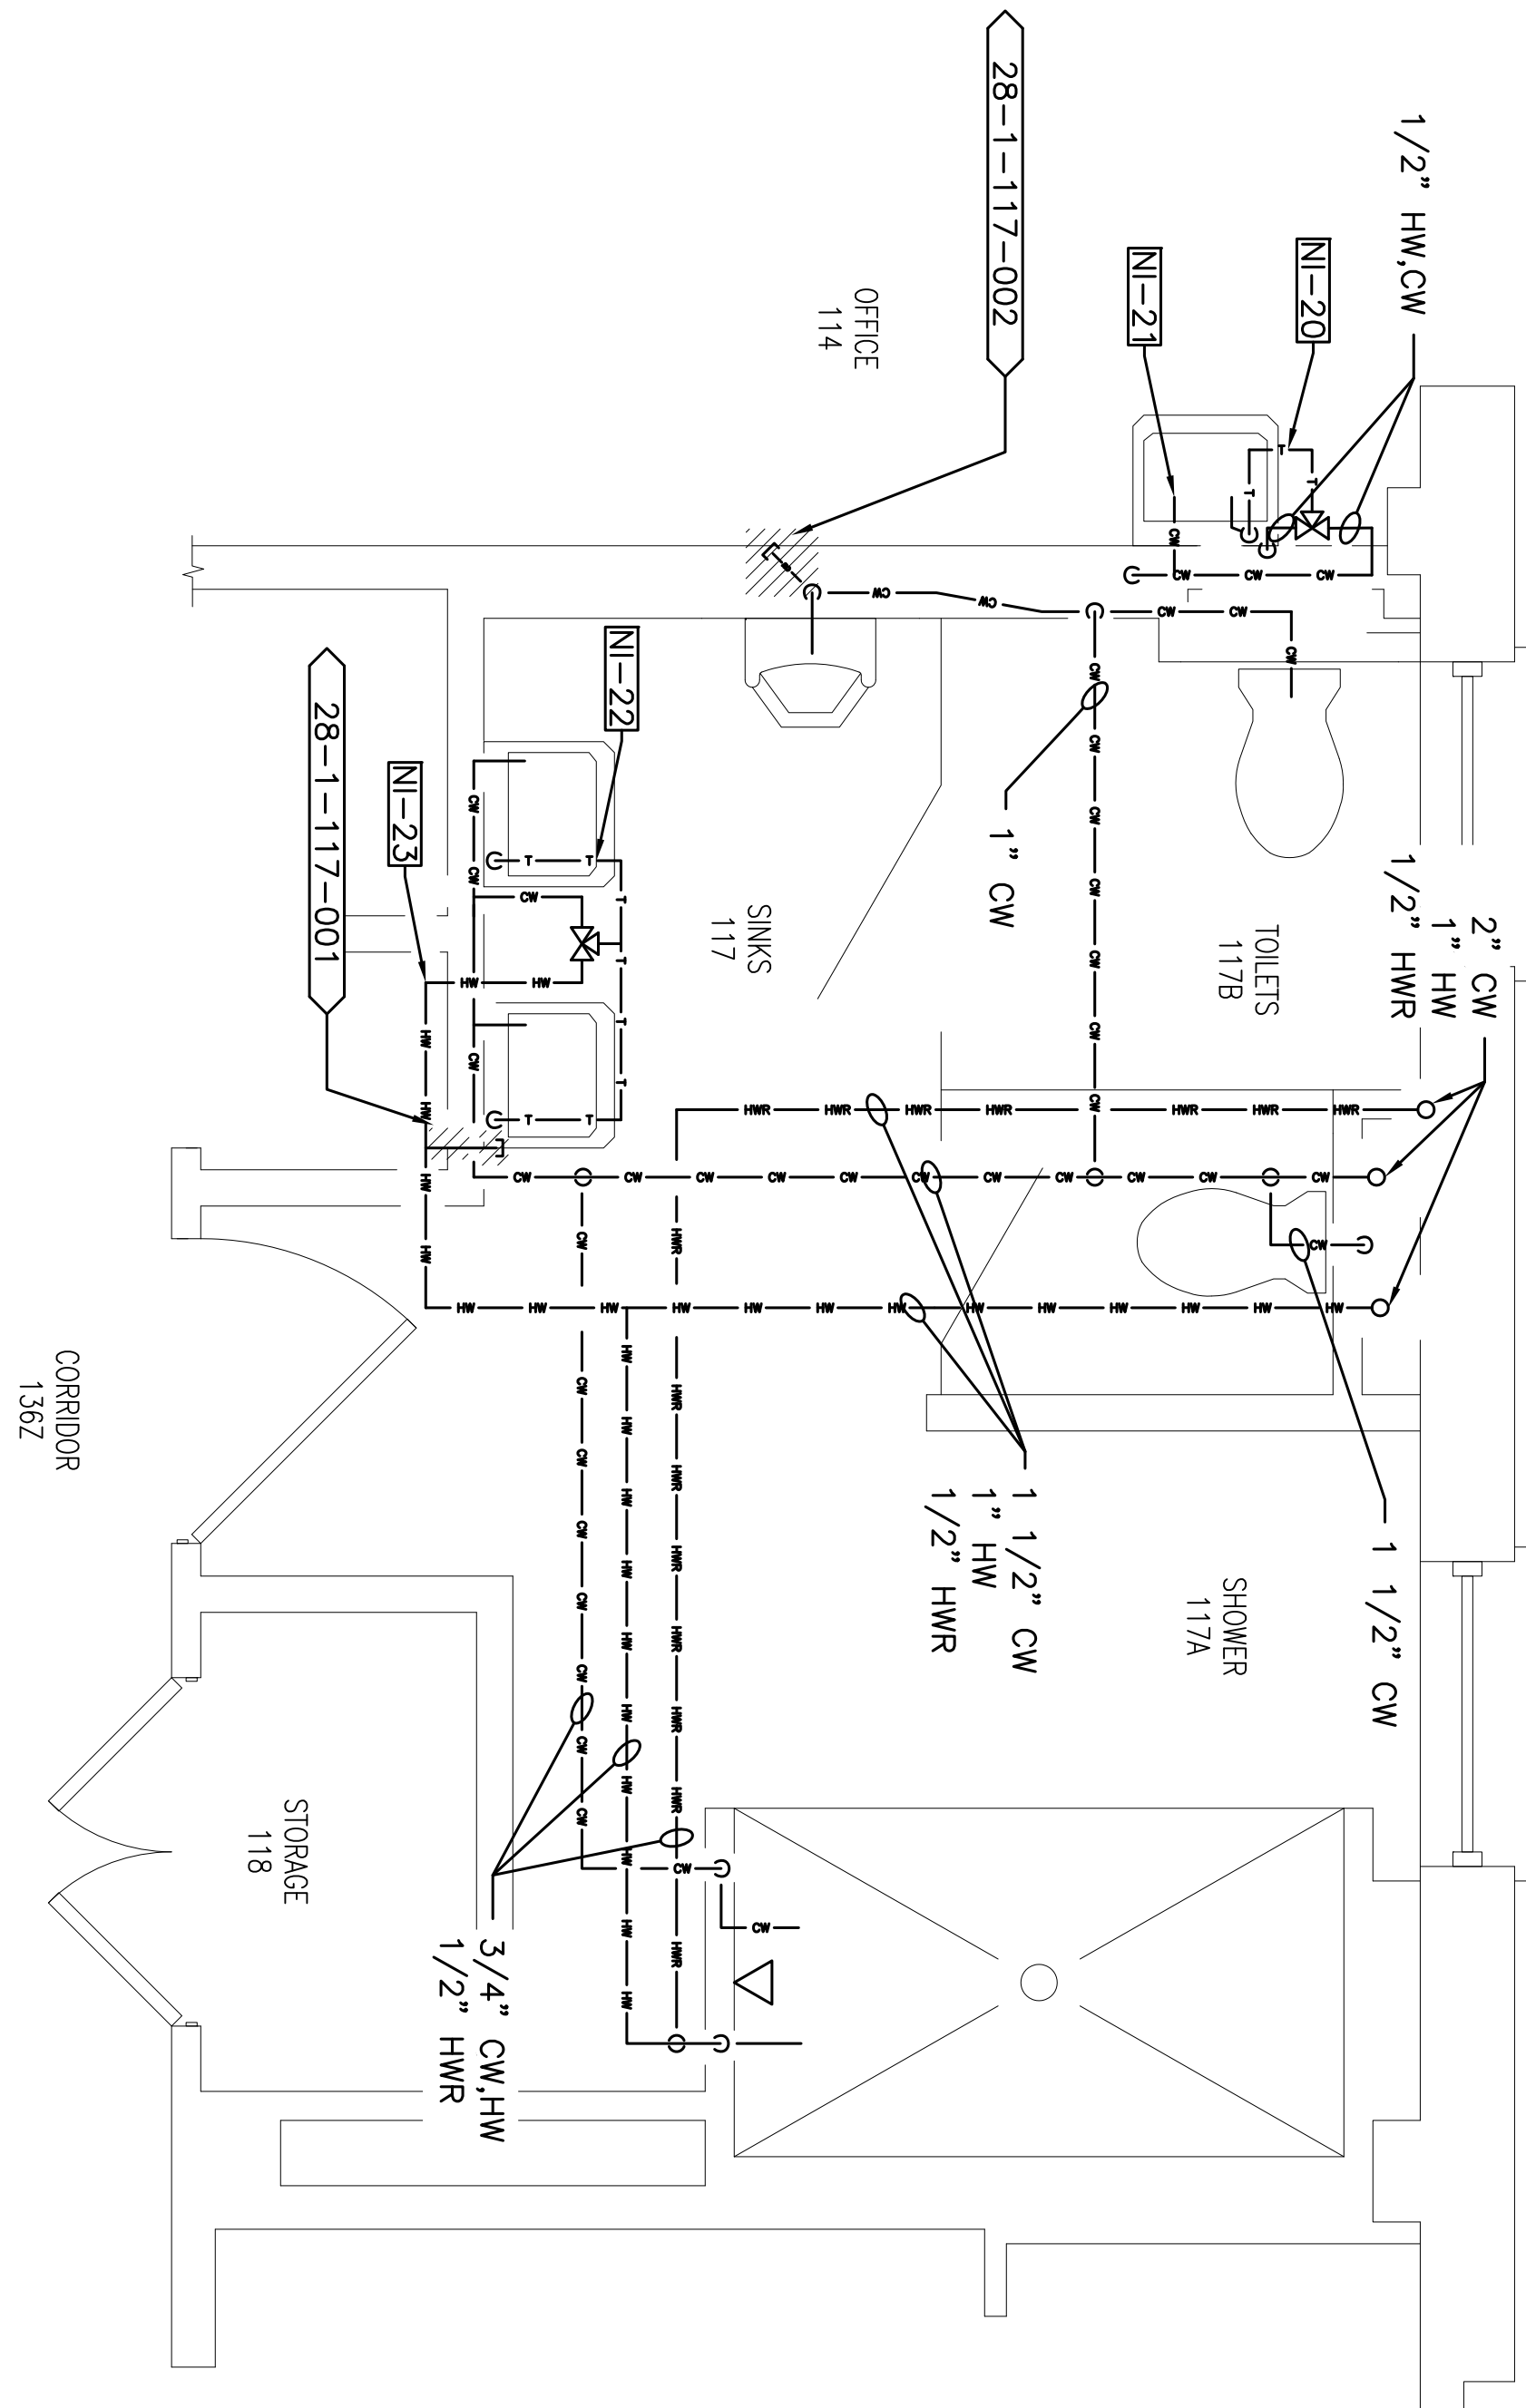

BUILDING 28 FIRST FLOOR ROOM 117 ENLARGED PLAN
PL-143
SCALE: 1/2" = 1'-0"

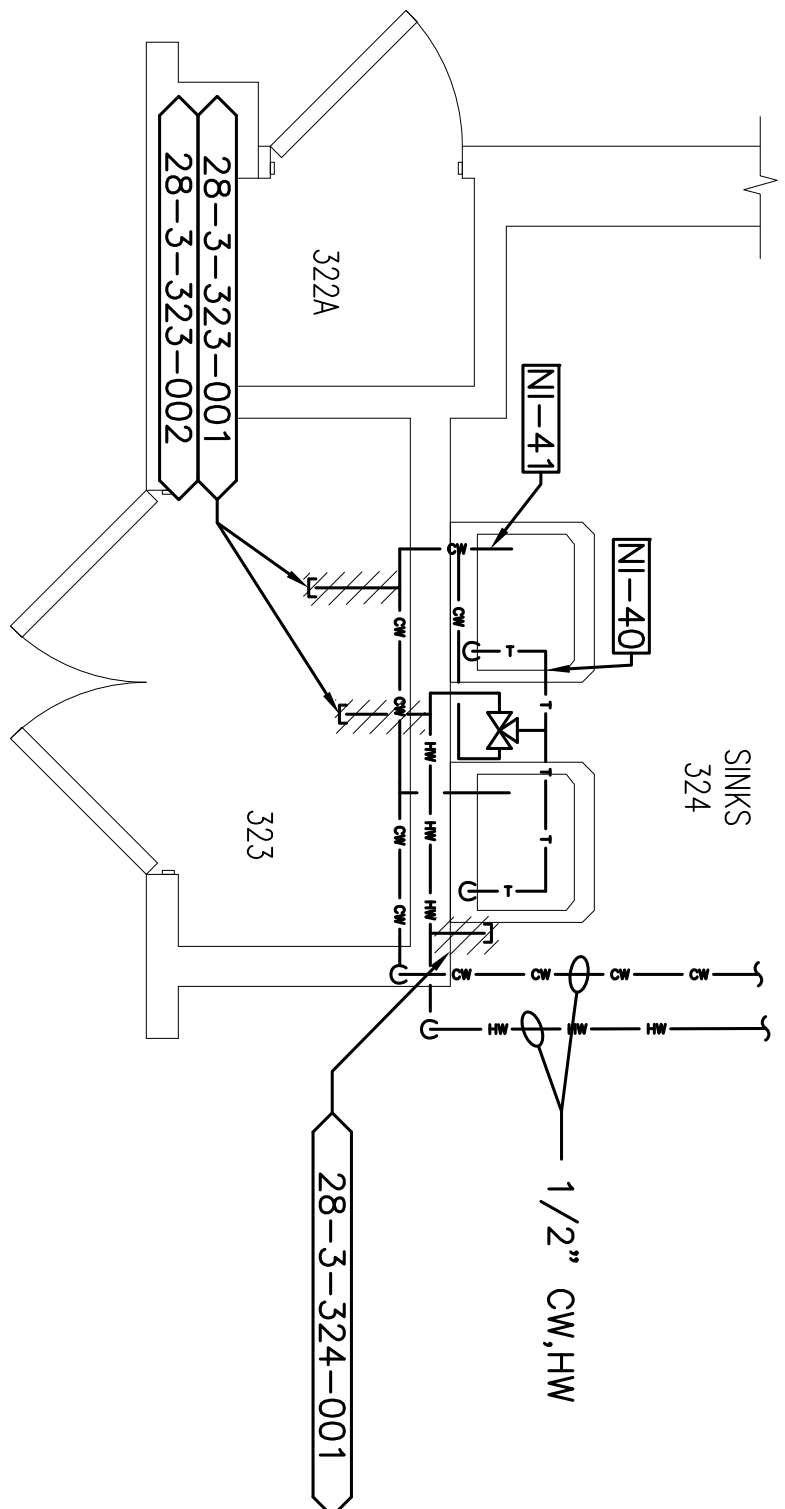

BUILDING 28 THIRD FLOOR ROOM 324 ENLARGED PLAN
PL-143
SCALE: 1/2" = 1'-0"

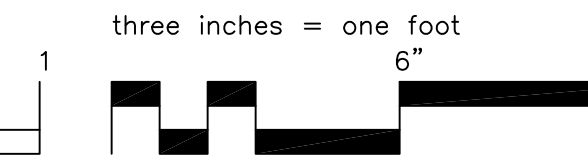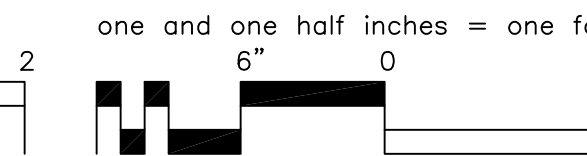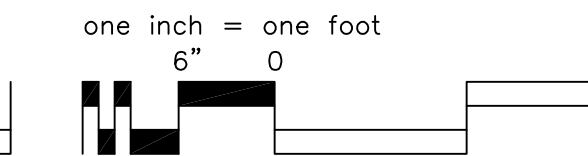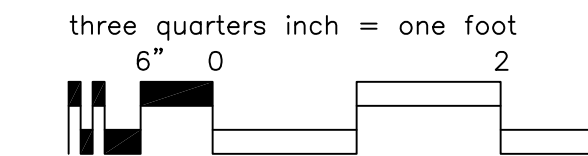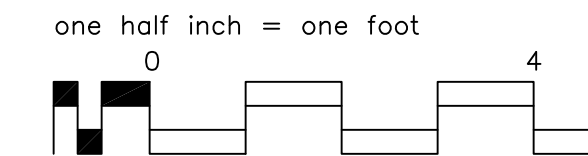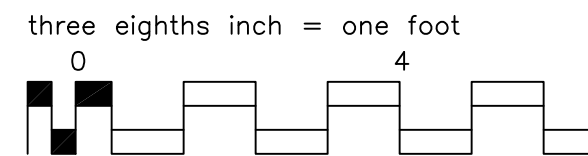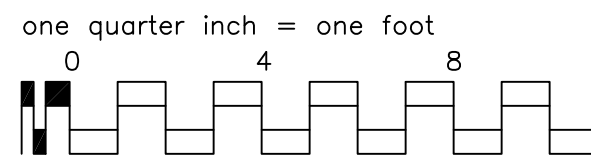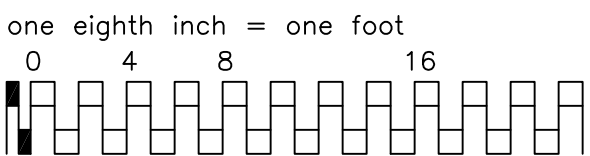

100% Working Drawings Submission	03-09-2018
Revisions:	Date:

CONSULTANTS:

ARCHITECT/ENGINEERS:

NORTH:

Drawing Title
Building 28 Enlarged Plans

Project Title
Remove Domestic Dead-Legs at the Montrose Campus

Project Number
620-18-119
Building(s) Number
28
Drawing Number
PL 143
Sheet 65 of 77

Engineering Service

Department of Veterans Affairs