

FOR 3-FT X 8-FT PLOTS

GAPS ARE


QUADS - 90" x 71"
SUHOR - 91" x 34"
SANNIADI - 90" x 34"

DUE TO 3-TYPE
OF PPCS


GAPS CAN RANGE FROM

5" OR 6"


DRAIN BOARD

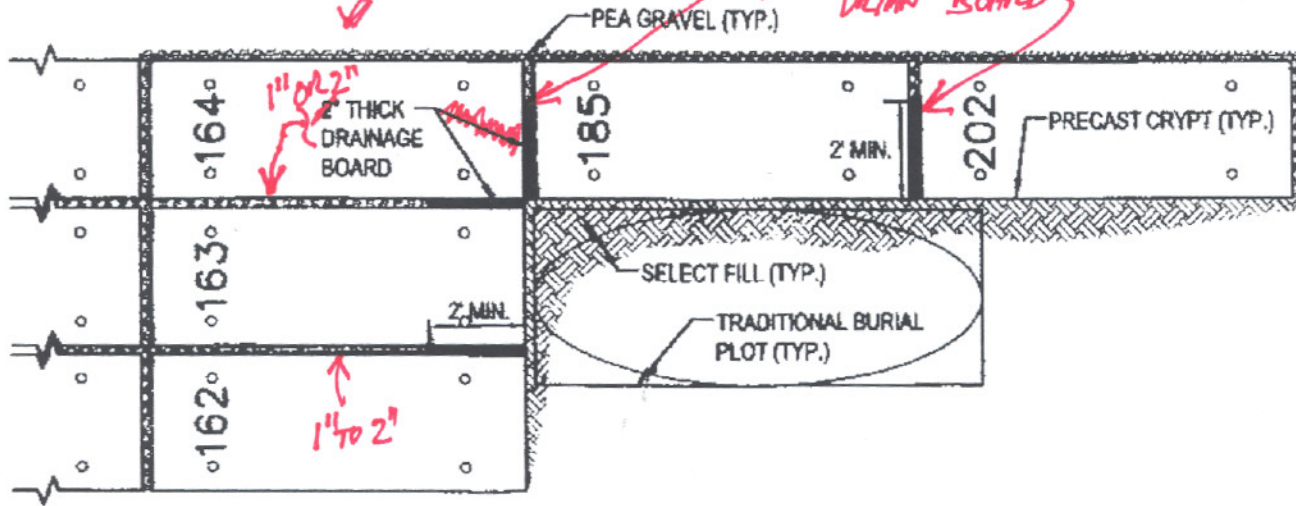

PLAN VIEW - INSIDE CORNER LOCATION

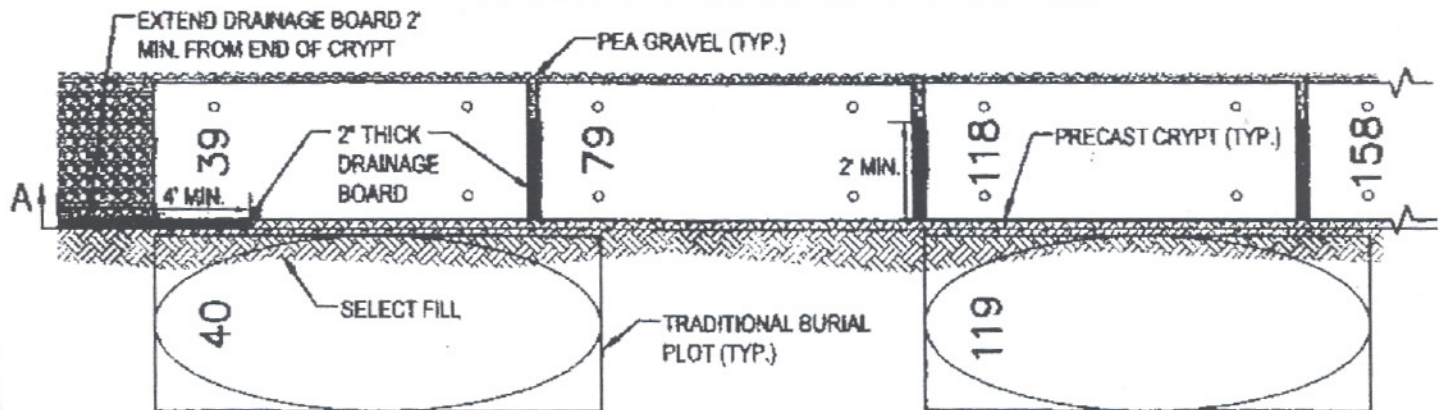

PLAN VIEW - END OF SECTION LOCATION

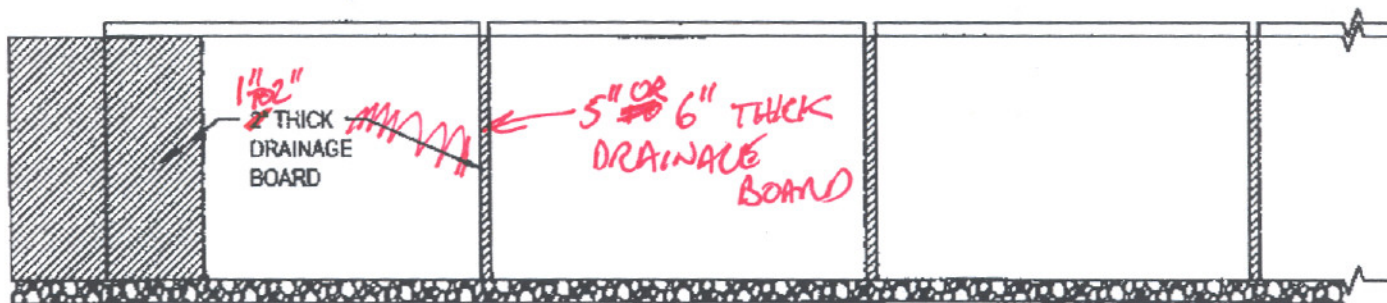

SECTION A-A

DRAINAGE BOARD @ TRADITIONAL SPACE