


three inches = one foot
one and one half inches = one foot
one inch = one foot
three quarters inch = one foot
one half inch = one foot
three eighths inch = one foot
one quarter inch = one foot
one eighth inch = one foot

KEY

- A 111 REPAIR 119 PHARMACY IV HOOD/11NRM||ARCH/MEP CHANGES||695-11-111||C10469, C10917
- B 111 REPLACE FLOORING IIB/12NRM/||FLOORING||695-12-201||C20465
- C 111 INSTALL NEUROLOGY CLINIC RECEPTION WINDOW/12MINOR||RECEPTION WINDOW||695-12-177||
- D 111 ACUTE CARE MODIFICATIONS 4C/04MINORS||WARD REMODEL||695-218||Z3001
- E 111 UPGRADE PUBLIC RESTROOMS/11NRM||FY11 JOC||111 UPGRADE PUBLIC RESTROOMS

ENTIRE FLOOR: REPLACE FIRE ALARM SYSTEM/09NRM||695-09-151||C90855
111 REKEY BLDG/12NRM/695-12-124

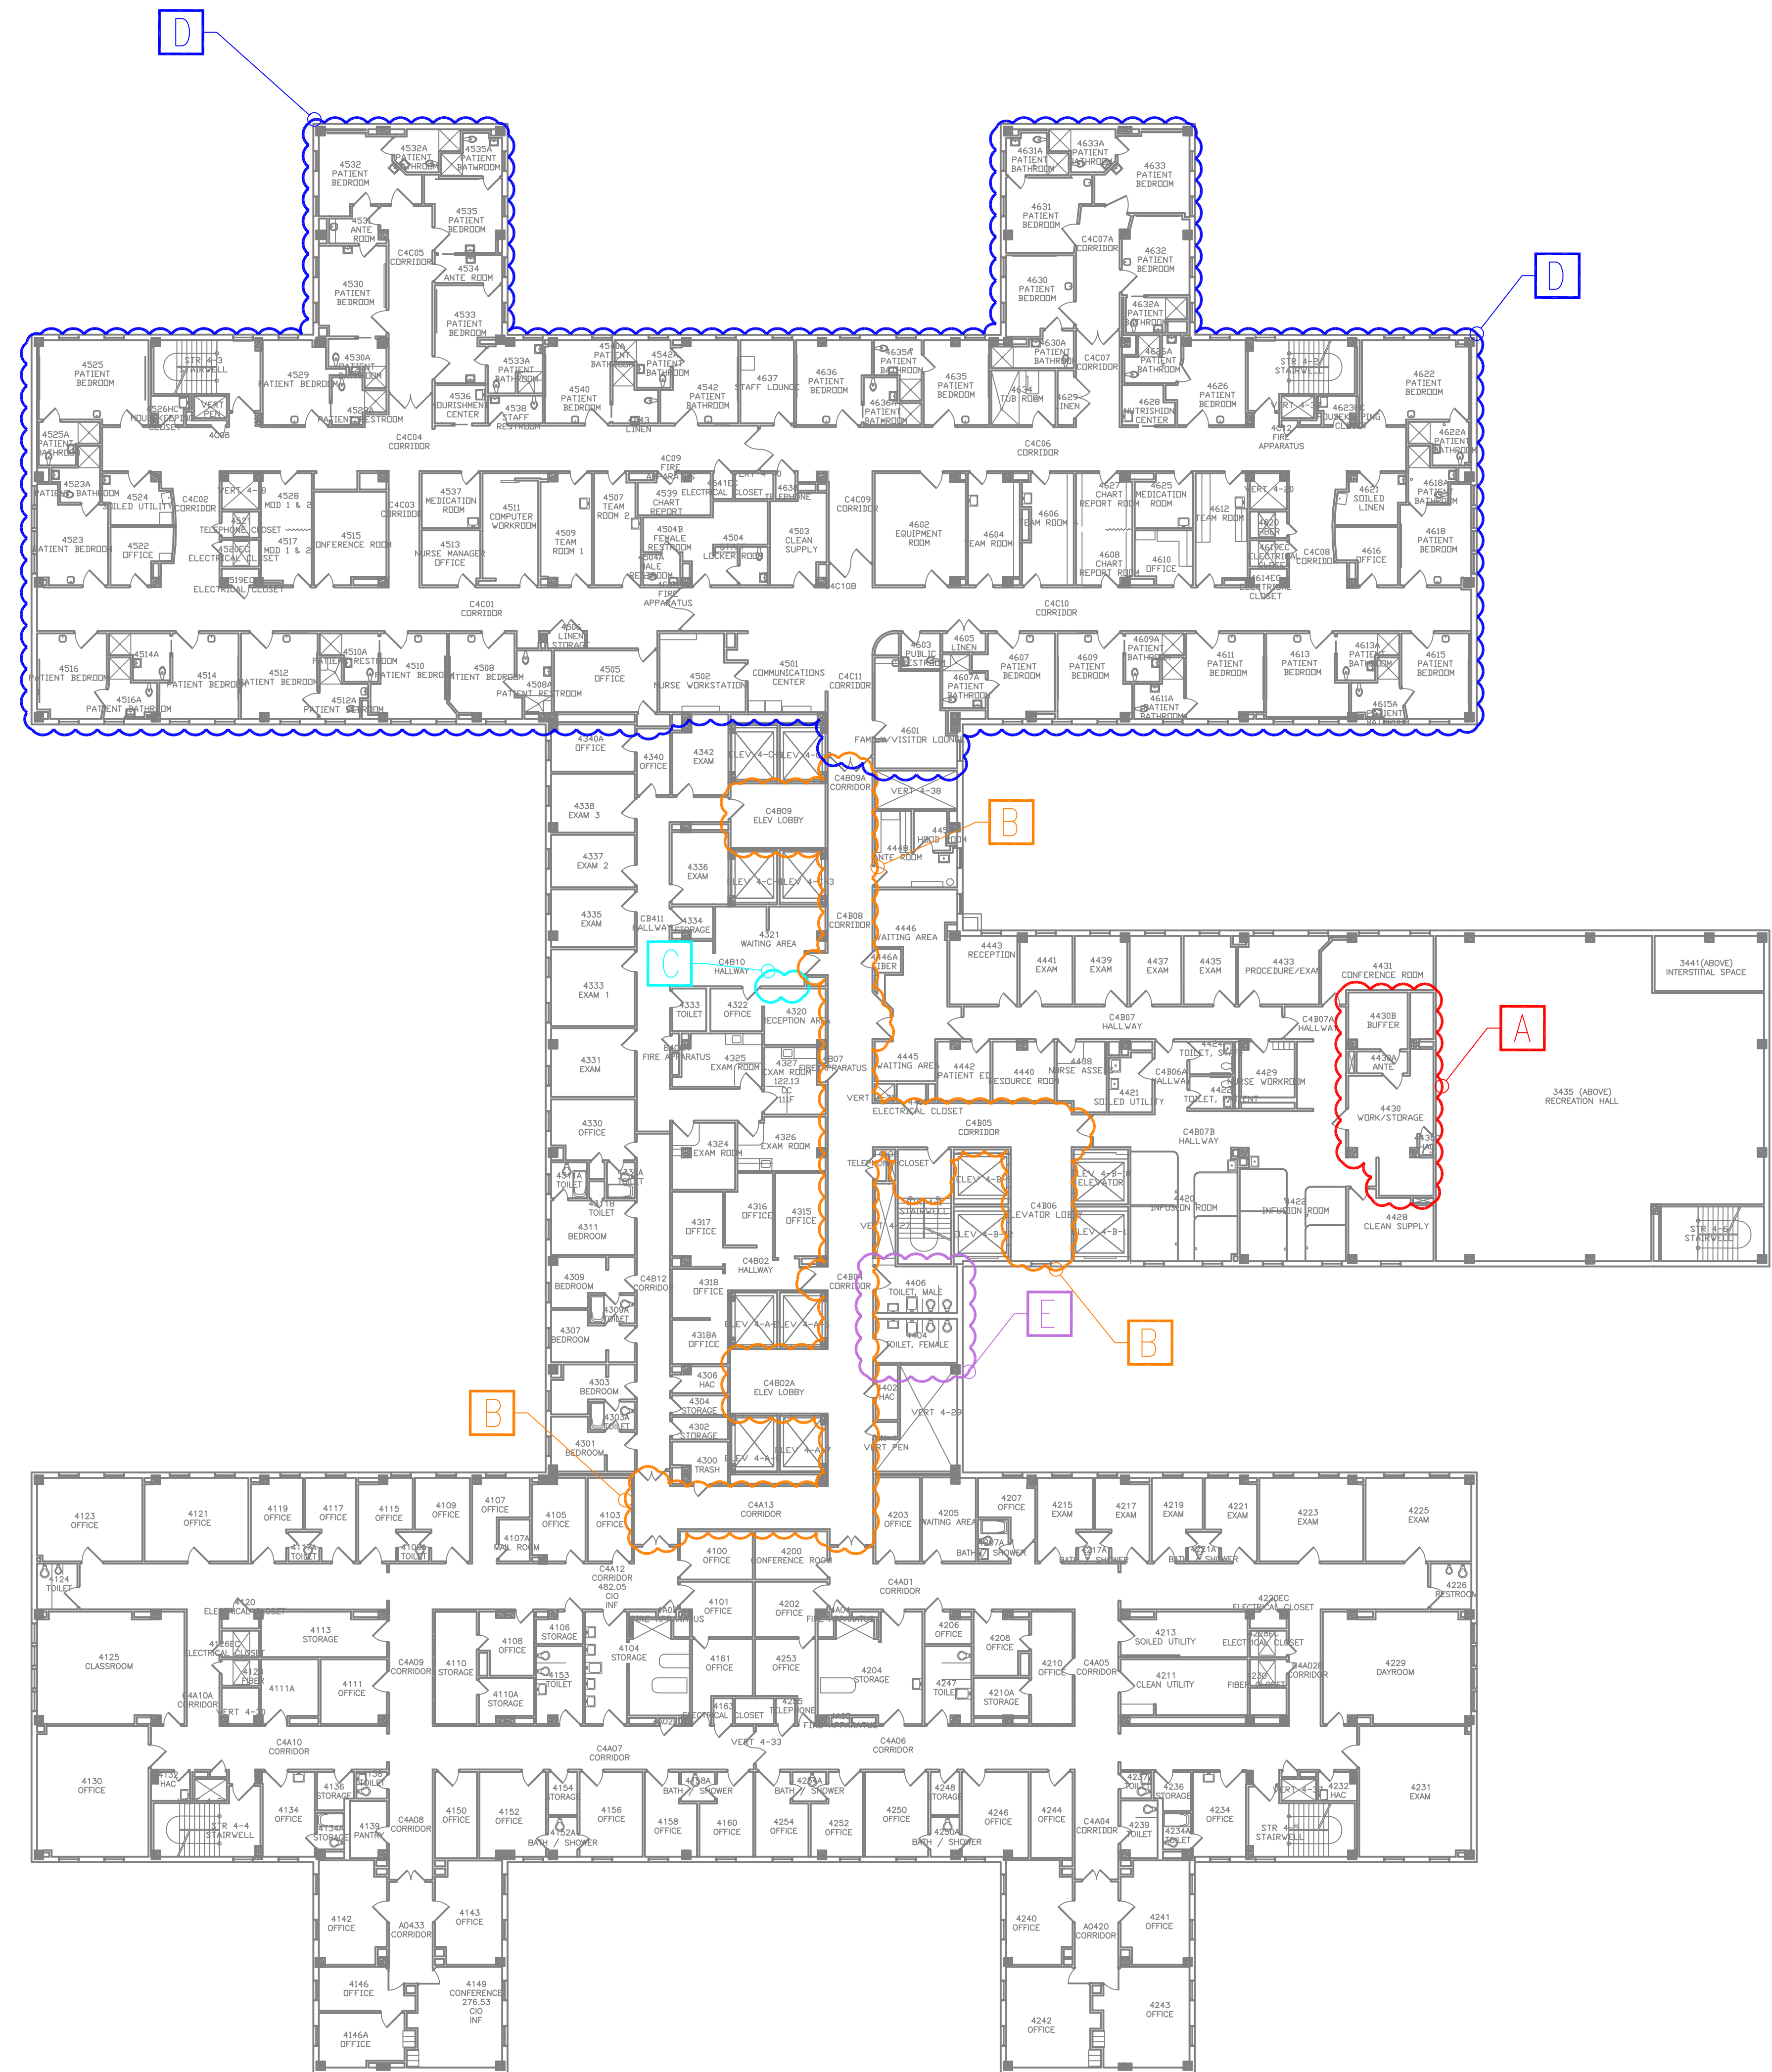

FOURTH FLOOR PLAN
N.T.S.

--	--	