

GENERAL NOTES

- REFER TO SHEET 0201 FOR TYPICAL SYMBOLS AND ABBREVIATIONS
- ACCESSIBLE PATH OF TRAVEL AS INDICATED ON PLAN IS A BARRIER FREE ACCESS ROUTE WITHOUT ANY ABRUPT LEVEL CHANGES EXCEEDING 1/4" IN 1' MAX. SLOPE OR VERTICAL LEVEL CHANGES NOT EXCEEDING 1/4" MAX AND AT LEAST 48" WIDE. SURFACE IS SLIP RESISTANT. STAIRS AND SLOPE CROSS SLOPE DOES NOT EXCEED 1% AND SLOPE IN THE DIRECTION OF TRAVEL IS LESS THAN 1% UNLESS OTHERWISE INDICATED. ACCESSIBLE PATH OF TRAVEL TO BE FREE OF OBSTRUCTING OBSTRUCTIONS TO 66" MINIMUM AND PROTRUDING OBJECTS GREATER THAN 4" PROTRUSION FROM WALL AND ABOVE 27" AND LESS THAN 27" BY ARCHITECT AND CONTRACTOR TO VERIFY THAT ALL BARRIERS IN THE PATH OF TRAVEL HAVE BEEN REMOVED OR WILL BE REMOVED UNDER THIS PROJECT, AND PATH OF TRAVEL COMPLIES WITH WC 119.


LEGEND

- PROPERTY LINE
- ACCESSIBLE PATH OF TRAVEL
- CHAINLINK FENCE DETAILS, SEE SHEET 0203
- CONCRETE WALK, SEE CIVIL DRAWINGS
- AREA OF PAVERS, SEE CIVIL DRAWINGS
- NEW BUILDING
- AREA OF ASPHALT CONCRETE, SEE CIVIL DRAWINGS
- AREA OF ASPHALT SEAL COAT, SEE CIVIL DRAWINGS


LIST OF ALTERNATES

ALT #	PRIORITY	DESCRIPTION
2	11	EPDS INLET OF CENTRA
3	10	EPDS INLET OF PLASTIC
4	9	CEILING SOFFIT FINISHES & QUARTZ SURFACE
5	8	REMOVE WING WALL @ ENTRY
6	7	REMOVE SUN SHADES
7	6	REMOVE ECO SCREENS
8	5	REMOVE TRELLIS
9	1	REMOVE HARDSCAPING
10	3	REDUCED AMOUNT FOR FIXED FURNISHING CASEWORK
11	4	CHANGE GLASS GLAZING @ INTERIOR STAIR TO STEEL GLAZING
12	10	REDUCE EXTERIOR GLAZING AND CHANGE EXTERIOR WALL FINISHES TO PAINTED CEMENT PLASTER
13	2	PORTION OF ST AND ONE LOCK AS UNFINISHED SPACE


NOTE: REFER TO SHEET 0201 FOR DESCRIPTIVE INFORMATION REGARDING EACH ALTERNATIVE

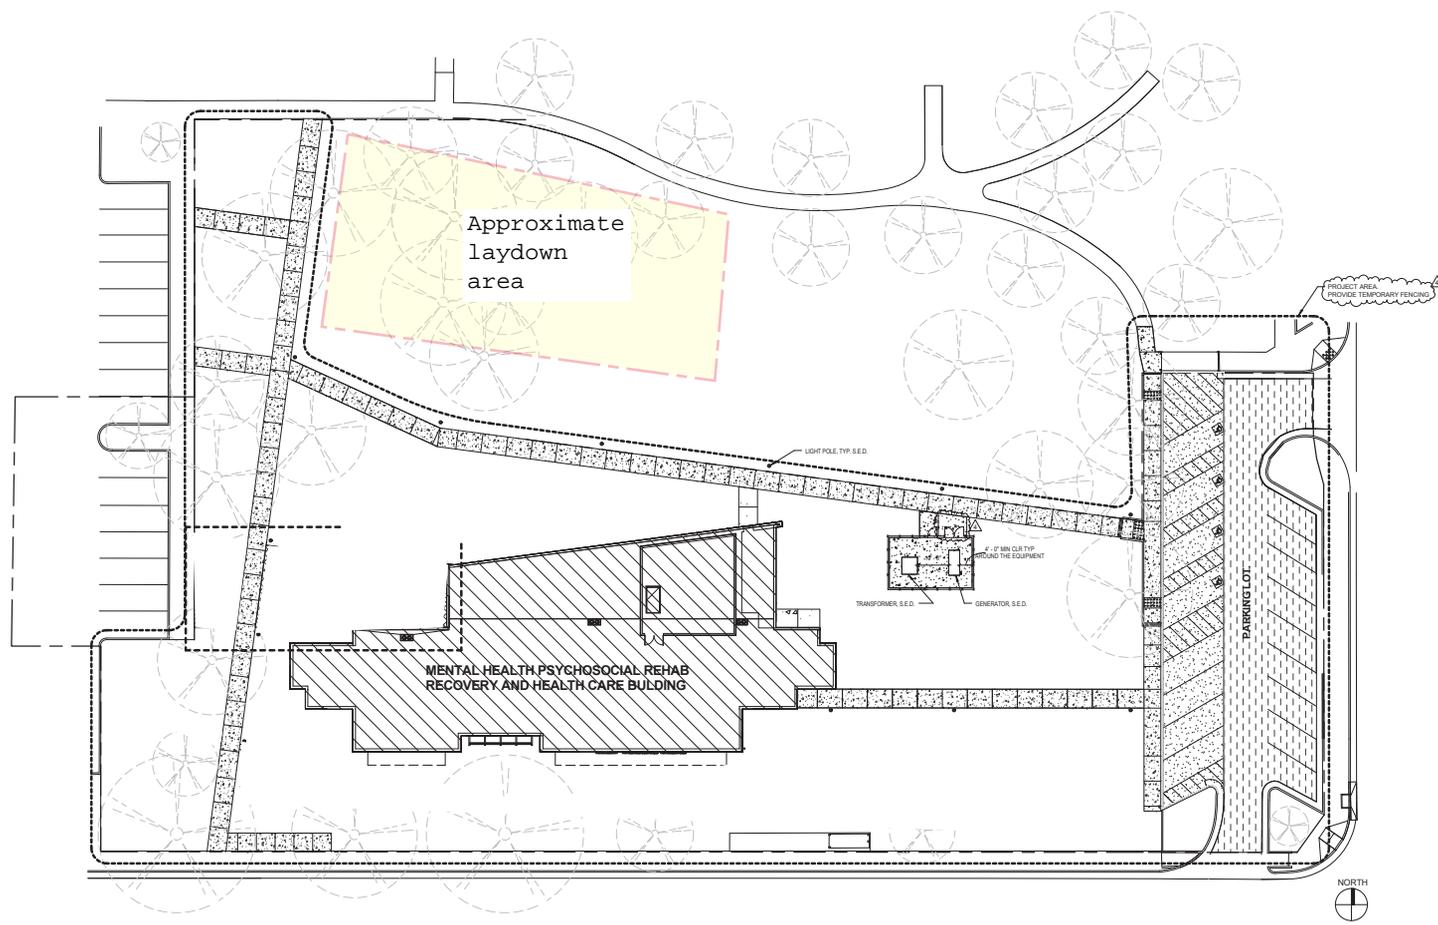

1 SITE PLAN
1/16" = 1'-0"

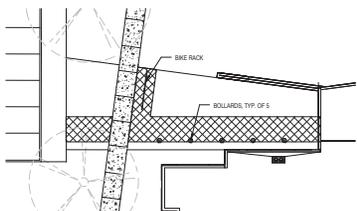

2 DEDUCTIVE ALTERNATE #9 ITEM #1
1/16" = 1'-0"

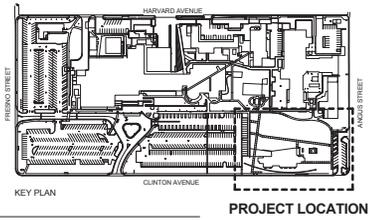

KEY PLAN
PROJECT LOCATION

Revision No.	Description	Date
1	ADDED	08/11/2014
2	ADDED	08/11/2014

CONSULTANTS:



ARCHITECT/ENGINEERS:
HMC Architects
2327 E. River Avenue | Suite 303 | Fresno, CA 93720
T 509 322 2444 | www.hmcarchitects.com
HMC PROJECT #1830002-000

Drawing Title
SITE PLAN

Approved: Project Director

Project Title
Mental Health Psychosocial Rehab Recovery and Health Care for Homeless Veteran Center

Location
2615 E. CLINTON AVE, FRESNO, CA 93703

Date
08/11/2014

Checked
Author

Drawing Number
570-217

Sheet Number
37

Drawing Number
AS101

Office of Construction and Facilities Management

