CAT6 JACKS ARE WIRED TO 12 PORT PATCH PANEL IN RM 111

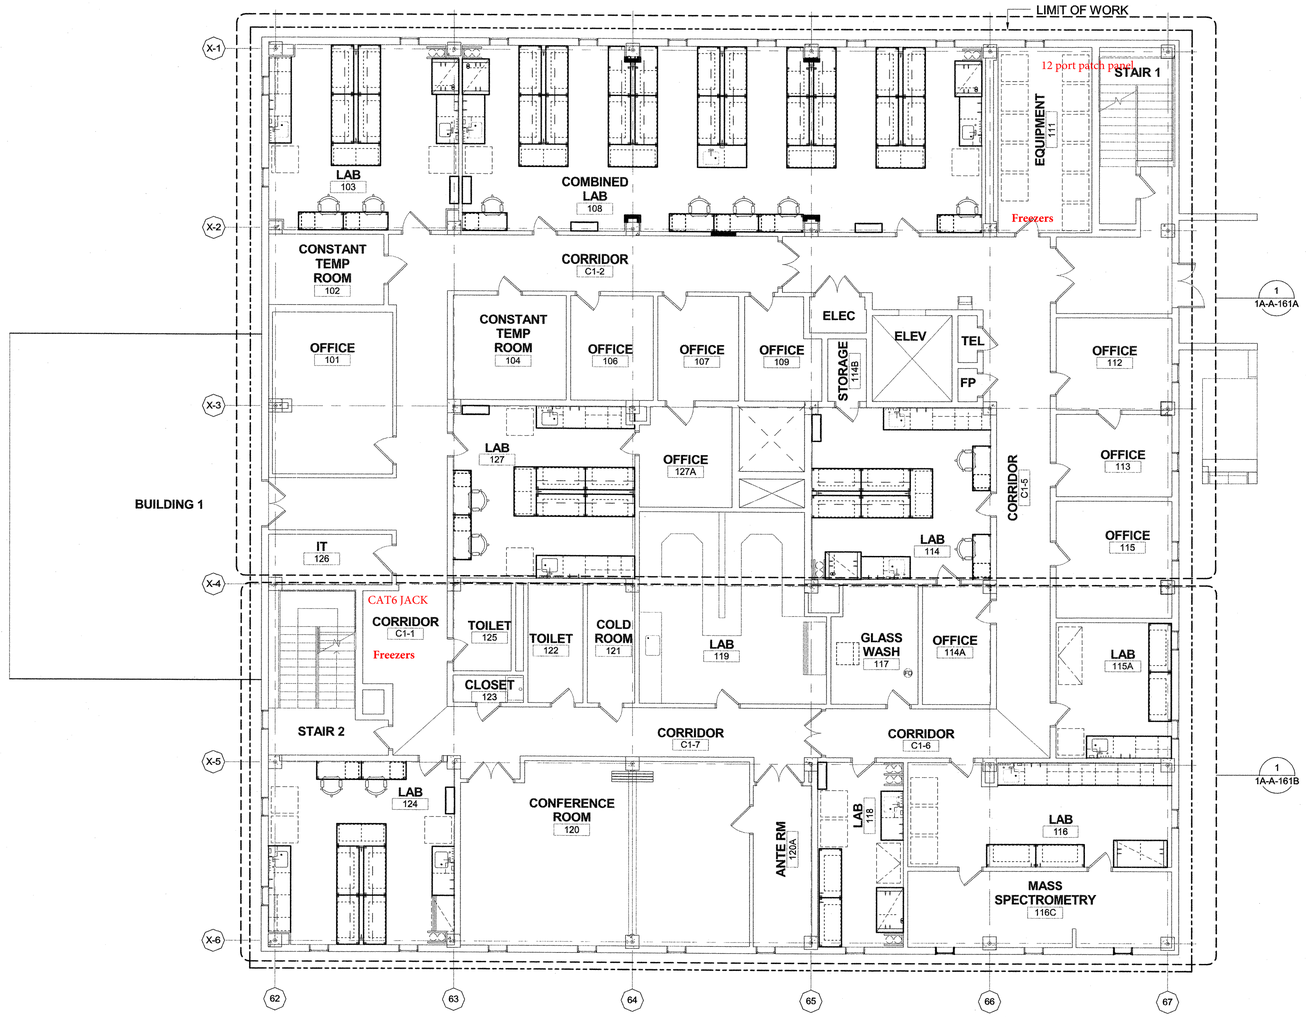

1 LEVEL 1 - NEW CASEWORK & EQUIPMENT

1/8" = 1'-0"

NOTE: REFER TO DWG 1A-A-161A AND 1A-A-161B FOR ENLARGED PLANS.

PROJECT/ NORTH TRUE NORTH

100% BID [FINAL] DOCUMENTS SUBMISSION

NO	REVISIONS	DATE

PROJECT TEAM

MECHANICAL/ELECTRICAL/PLUMBING:
Thompson Consultants, Inc.
525 Mill Street
Marion, MA 02738

STRUCTURAL:
Souza, True & Partners, Inc.
653 Mt. Auburn St.
Watertown, MA 02472

HAZARDOUS MATERIALS CONSULTANTS:
CDW Consultants, Inc.
40 Speen Street
Framingham, MA 01701

FIRE/LIFE SAFETY PLAN REVIEW:
FP&C Consultants, Inc.
1520 Main Street
Indianapolis, IN 46224

ARCHITECT/ LABORATORY PLANNER:

REGISTERED ARCHITECT THOMAS G. HESS No. 7559 BOSTON, MASS.

HDR Architecture, Inc.
695 Atlantic Ave. Boston, MA 02111-3823

Drawing Title: ARCHITECTURE LAB NEW LEVEL 1
Building Number: 1A
Approved : Project Engineer: James E Vickers – VA Project Engineer; Tom Loos – Project Technician

Project Title: DVA - JAMAICA PLAIN
Location: 150 S. HUNTINGTON AVE. JAMAICA PLAIN, MA 02130
Date: JULY 12, 2011
Checked by: JH
Drawn: ARG

Project Number: 523-10-401
Building Number: 1A
Drawing Number: 1A-A-151

Office of Construction and Facilities Management
Department of Veterans Affairs

C:\RVT\152861 \VA HOSPITAL_IP - BLDG1A_OL MODEL_agullejani.rvt
6/27/2011 10:55:08 AM

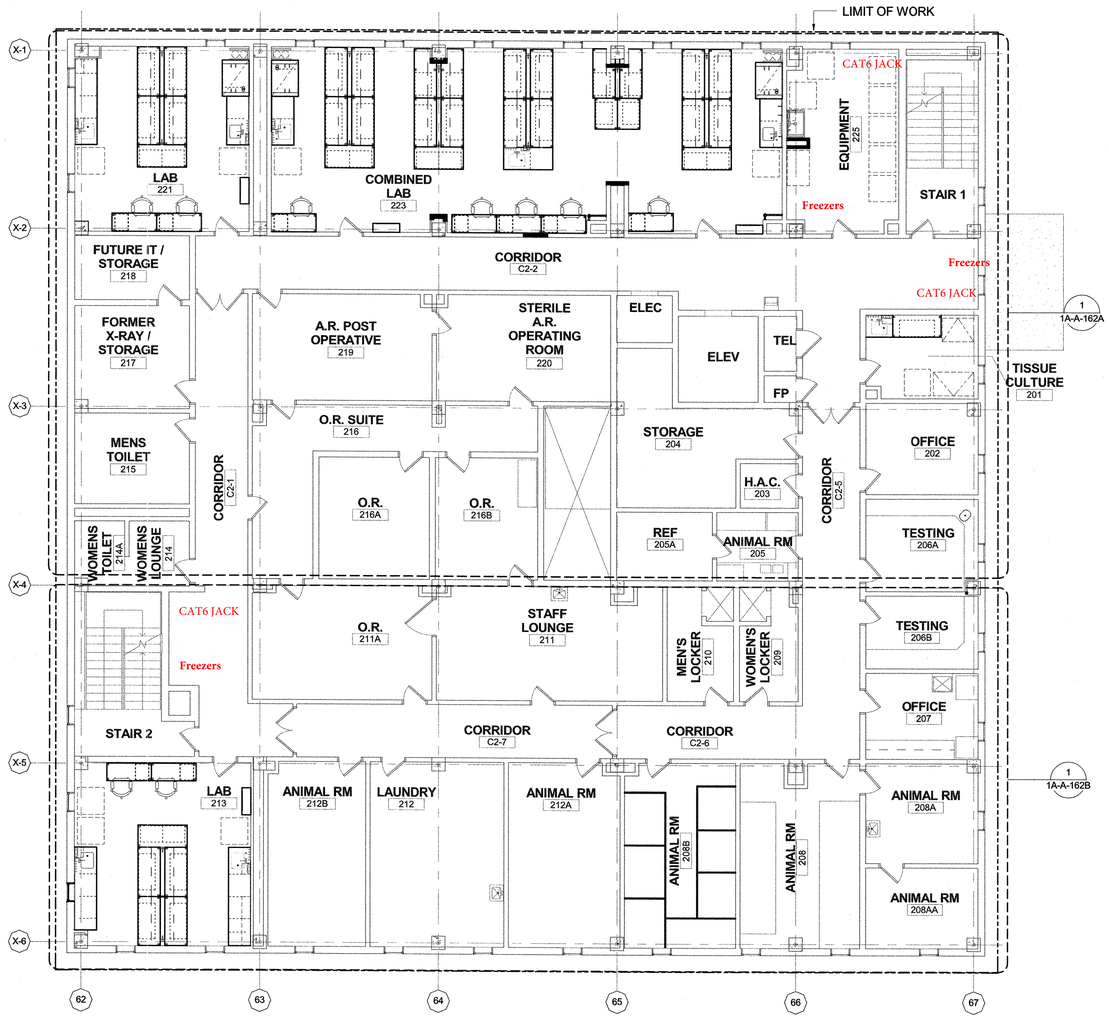

1 LEVEL 2 - NEW CASEWORK & EQUIPMENT

1/8" = 1'-0"

NOTE: REFER TO DWG 1A-A-162A AND 1A-A-162B FOR ENLARGED PLANS.

PROJECT NORTH
TRUE NORTH

100% BID [FINAL] DOCUMENTS SUBMISSION

NO	REVISIONS	DATE

PROJECT TEAM

MECHANICAL/ELECTRICAL/PLUMBING:
Thompson Consultants, Inc.
525 Mill Street
Marion, MA 02738

STRUCTURAL:
Souza, True & Partners, Inc.
653 Mt. Auburn St.
Watertown, MA 02472

HAZARDOUS MATERIALS CONSULTANTS:
CDW Consultants, Inc.
40 Speen Street
Framingham, MA 01701

FIRE/LIFE SAFETY PLAN REVIEW:
FP&C Consultants, Inc.
1520 Main Street
Indianapolis, IN 46224

ARCHITECT/ LABORATORY PLANNER:

REGISTERED ARCHITECTS — THOMAS G. HEBB — No. 7559 — BOSTON, MASS.

HDR Architecture, Inc.
695 Atlantic Ave.
Boston, MA 02111-2023

Drawing Title: ARCHITECTURE LAB NEW LEVEL 2
Building Number: 1A

Approved : Project Engineer
James E Vickers – VA Project Engineer
Tom Loos – Project Technician

Project Title: DVA - JAMAICA PLAIN
Location: 150 S. HUNTINGTON AVE. JAMAICA PLAIN, MA 02130
Date: JULY 12, 2011
Checked by: JH
Drawn: ARG

Project Number: 523-10-401
Building Number: 1A
Drawing Number: 1A-A-152

Office of Construction and Facilities Management
Department of Veterans Affairs

C:\R\VT\162861\VA HOSPITAL_JP - BLDG1A_OL MODEL_agahigian.rvt
6/27/2011 10:55:10 AM

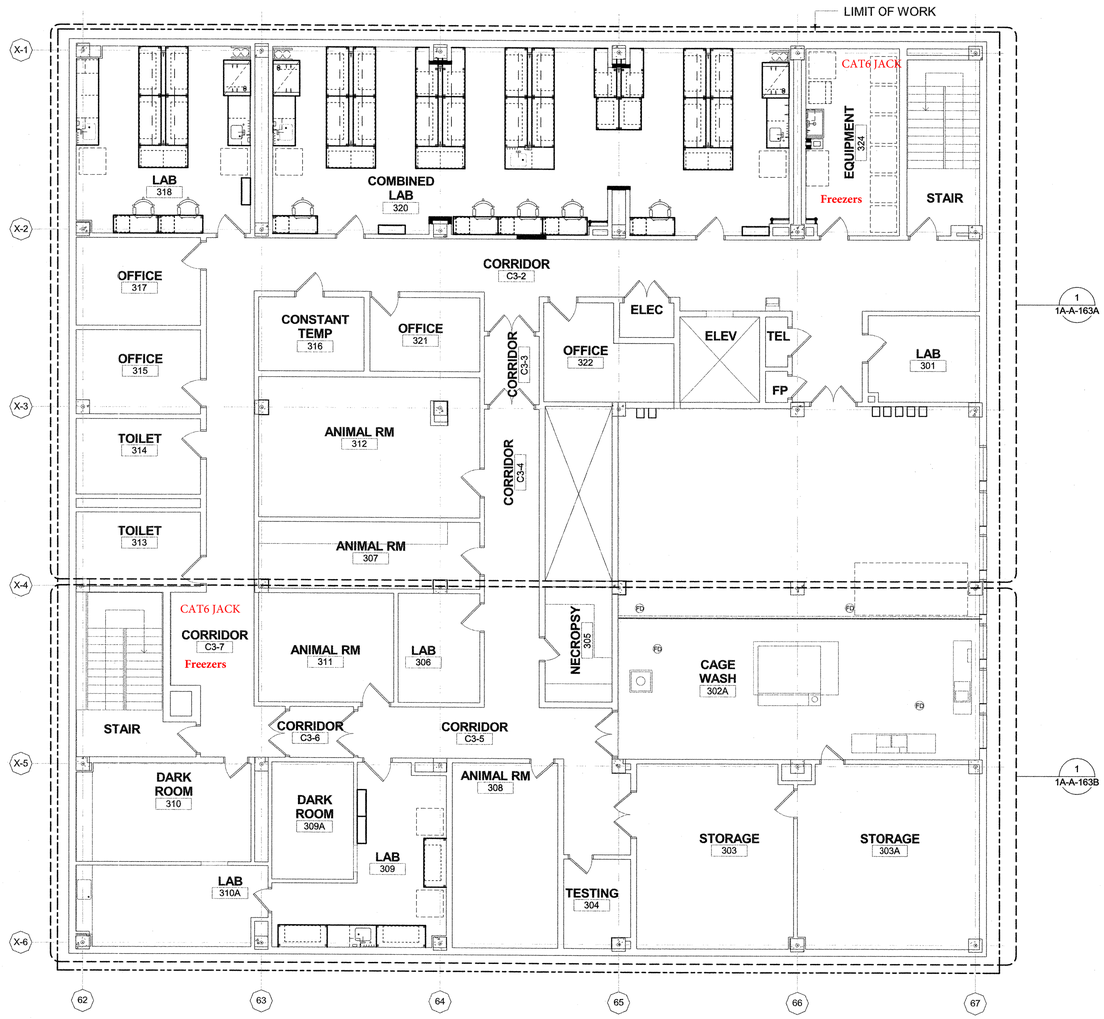

1 LEVEL 3 - NEW CASEWORK & EQUIPMENT

1/8" = 1'-0"

NOTE: REFER TO DWG 1A-A-163A AND 1A-A-163B FOR ENLARGED PLANS.

PROJECT NORTH
TRUE NORTH

100% BID [FINAL] DOCUMENTS SUBMISSION

NO	REVISIONS	DATE

PROJECT TEAM

MECHANICAL/ELECTRICAL/PLUMBING:
Thompson Consultants, Inc.
525 Mill Street
Marion, MA 02738

STRUCTURAL:
Souza, True & Partners, Inc.
653 Mt. Auburn St.
Watertown, MA 02472

HAZARDOUS MATERIALS CONSULTANTS:
CDW Consultants, Inc.
40 Speen Street
Framingham, MA 01701

FIRE/LIFE SAFETY PLAN REVIEW:
FP&C Consultants, Inc.
1520 Main Street
Indianapolis, IN 46224

ARCHITECT/ LABORATORY PLANNER:

REGISTERED ARCHITECTS COMMONWEALTH OF MASSACHUSETTS THOMAS G. ROSS No. 7559 BOSTON, MASS.

HDR Architecture, Inc.
699 Atlantic Ave. Boston, MA 02111-2023

Drawing Title: ARCHITECTURE LAB NEW LEVEL 3
Building Number: 1A

Approved : Project Engineer
James E Vickers – VA Project Engineer
Tom Loos – Project Technician

Project Title: DVA - JAMAICA PLAIN
Location: 150 S. HUNTINGTON AVE. JAMAICA PLAIN, MA 02130
Date: JULY 12, 2011
Checked by: JH
Drawn: ARG

Project Number: 523-10-401
Building Number: 1A
Drawing Number: 1A-A-153

Office of Construction and Facilities Management
Department of Veterans Affairs

C:\RVT\152861 VA HOSPITAL_JP - BLDG1A_OL MODEL_dgutrejan.rvt
6/27/2011 10:55:11 AM