

Power Source


BUILDING 100 - FL3

Data Source


Power Source

Doors to Corridor F3-C21

High Priority Location

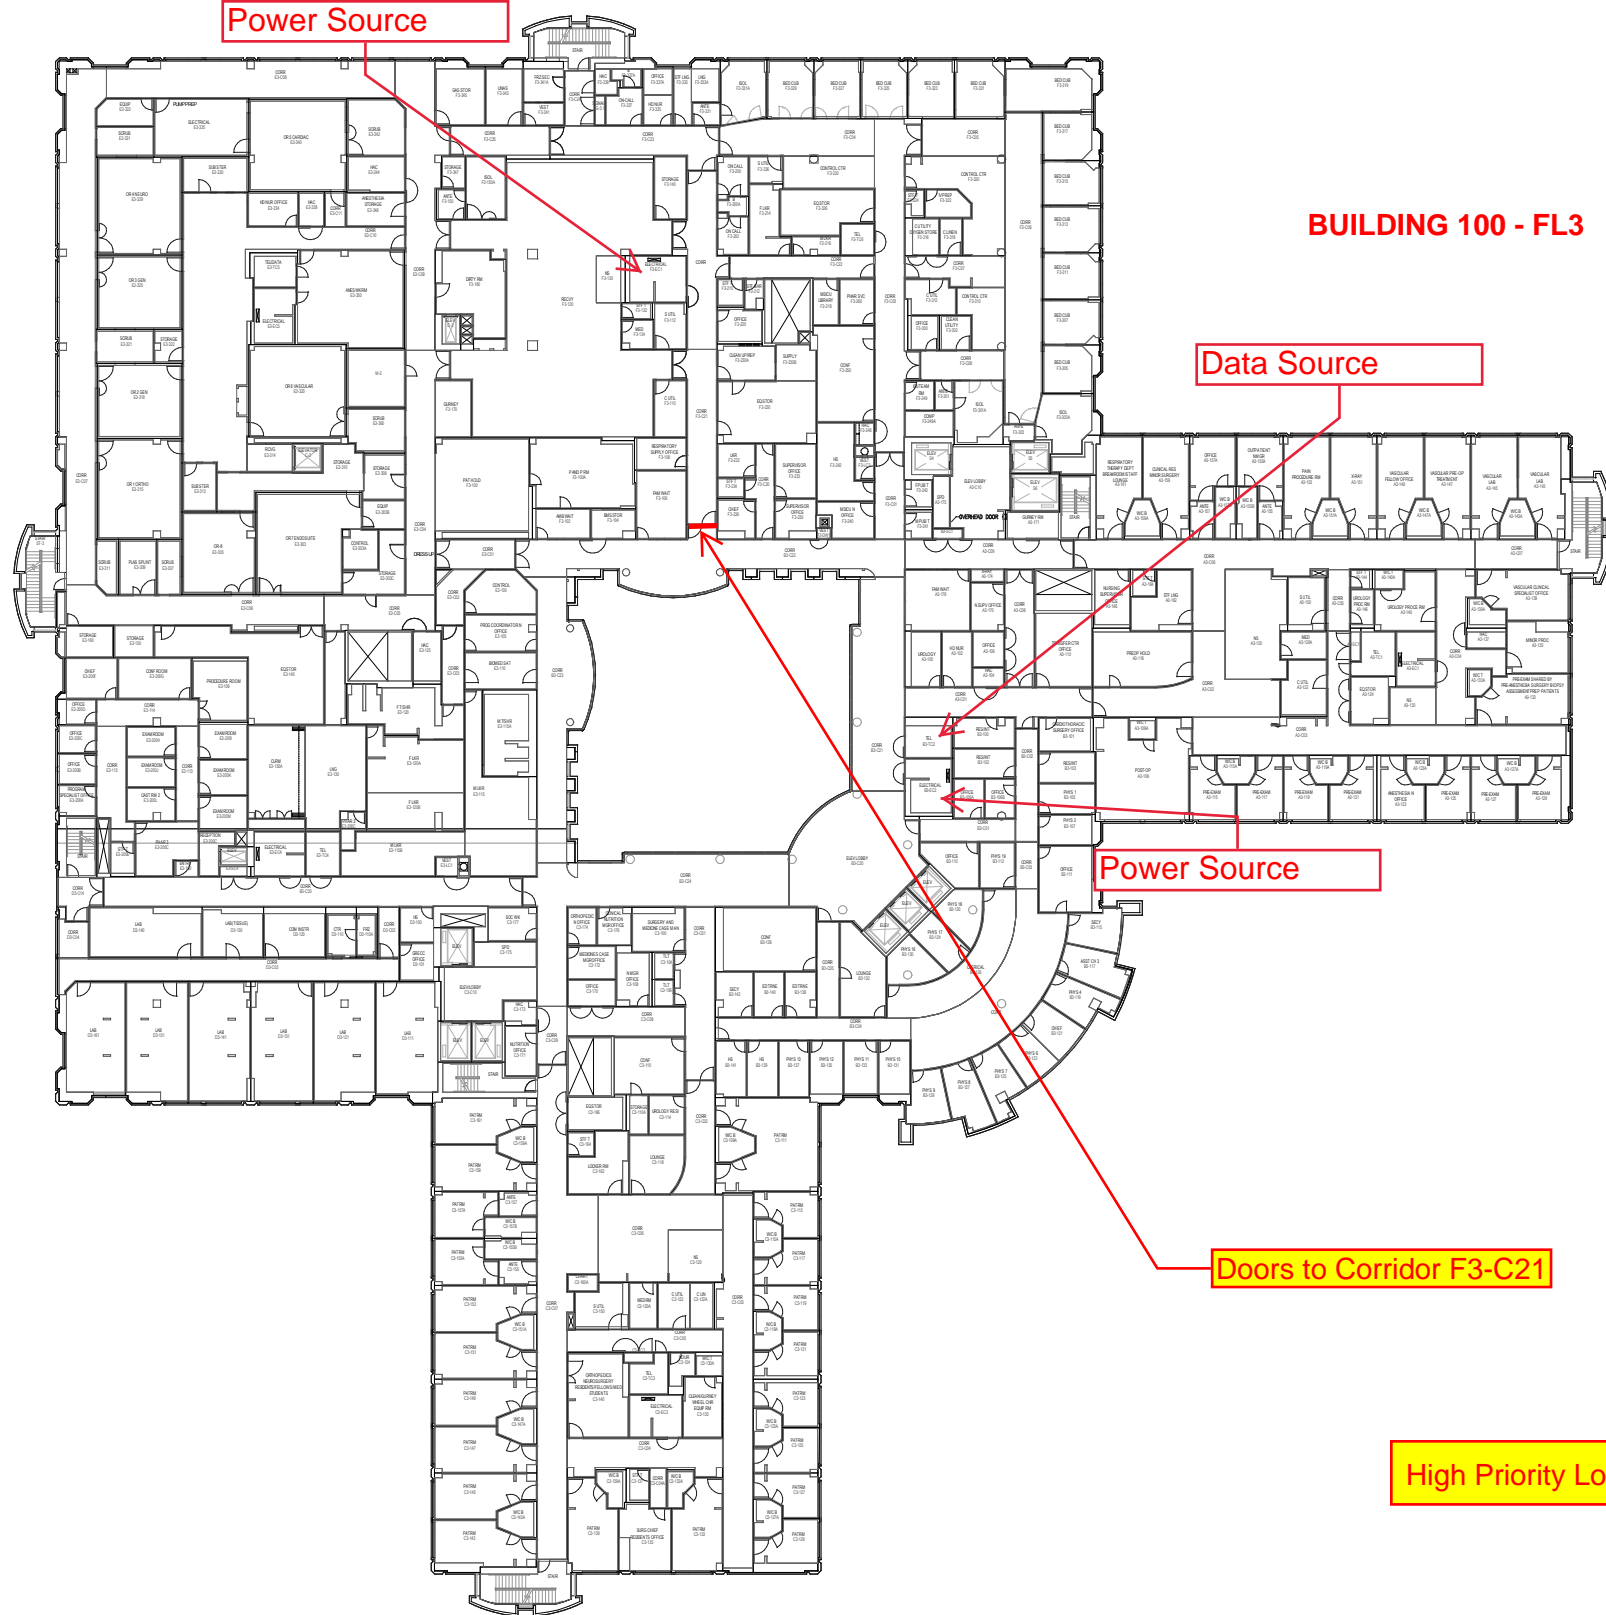

BUILDING 7 - FL1:
Confirm exact location of openers with
SCI AO (Gail Earley) prior to installation.

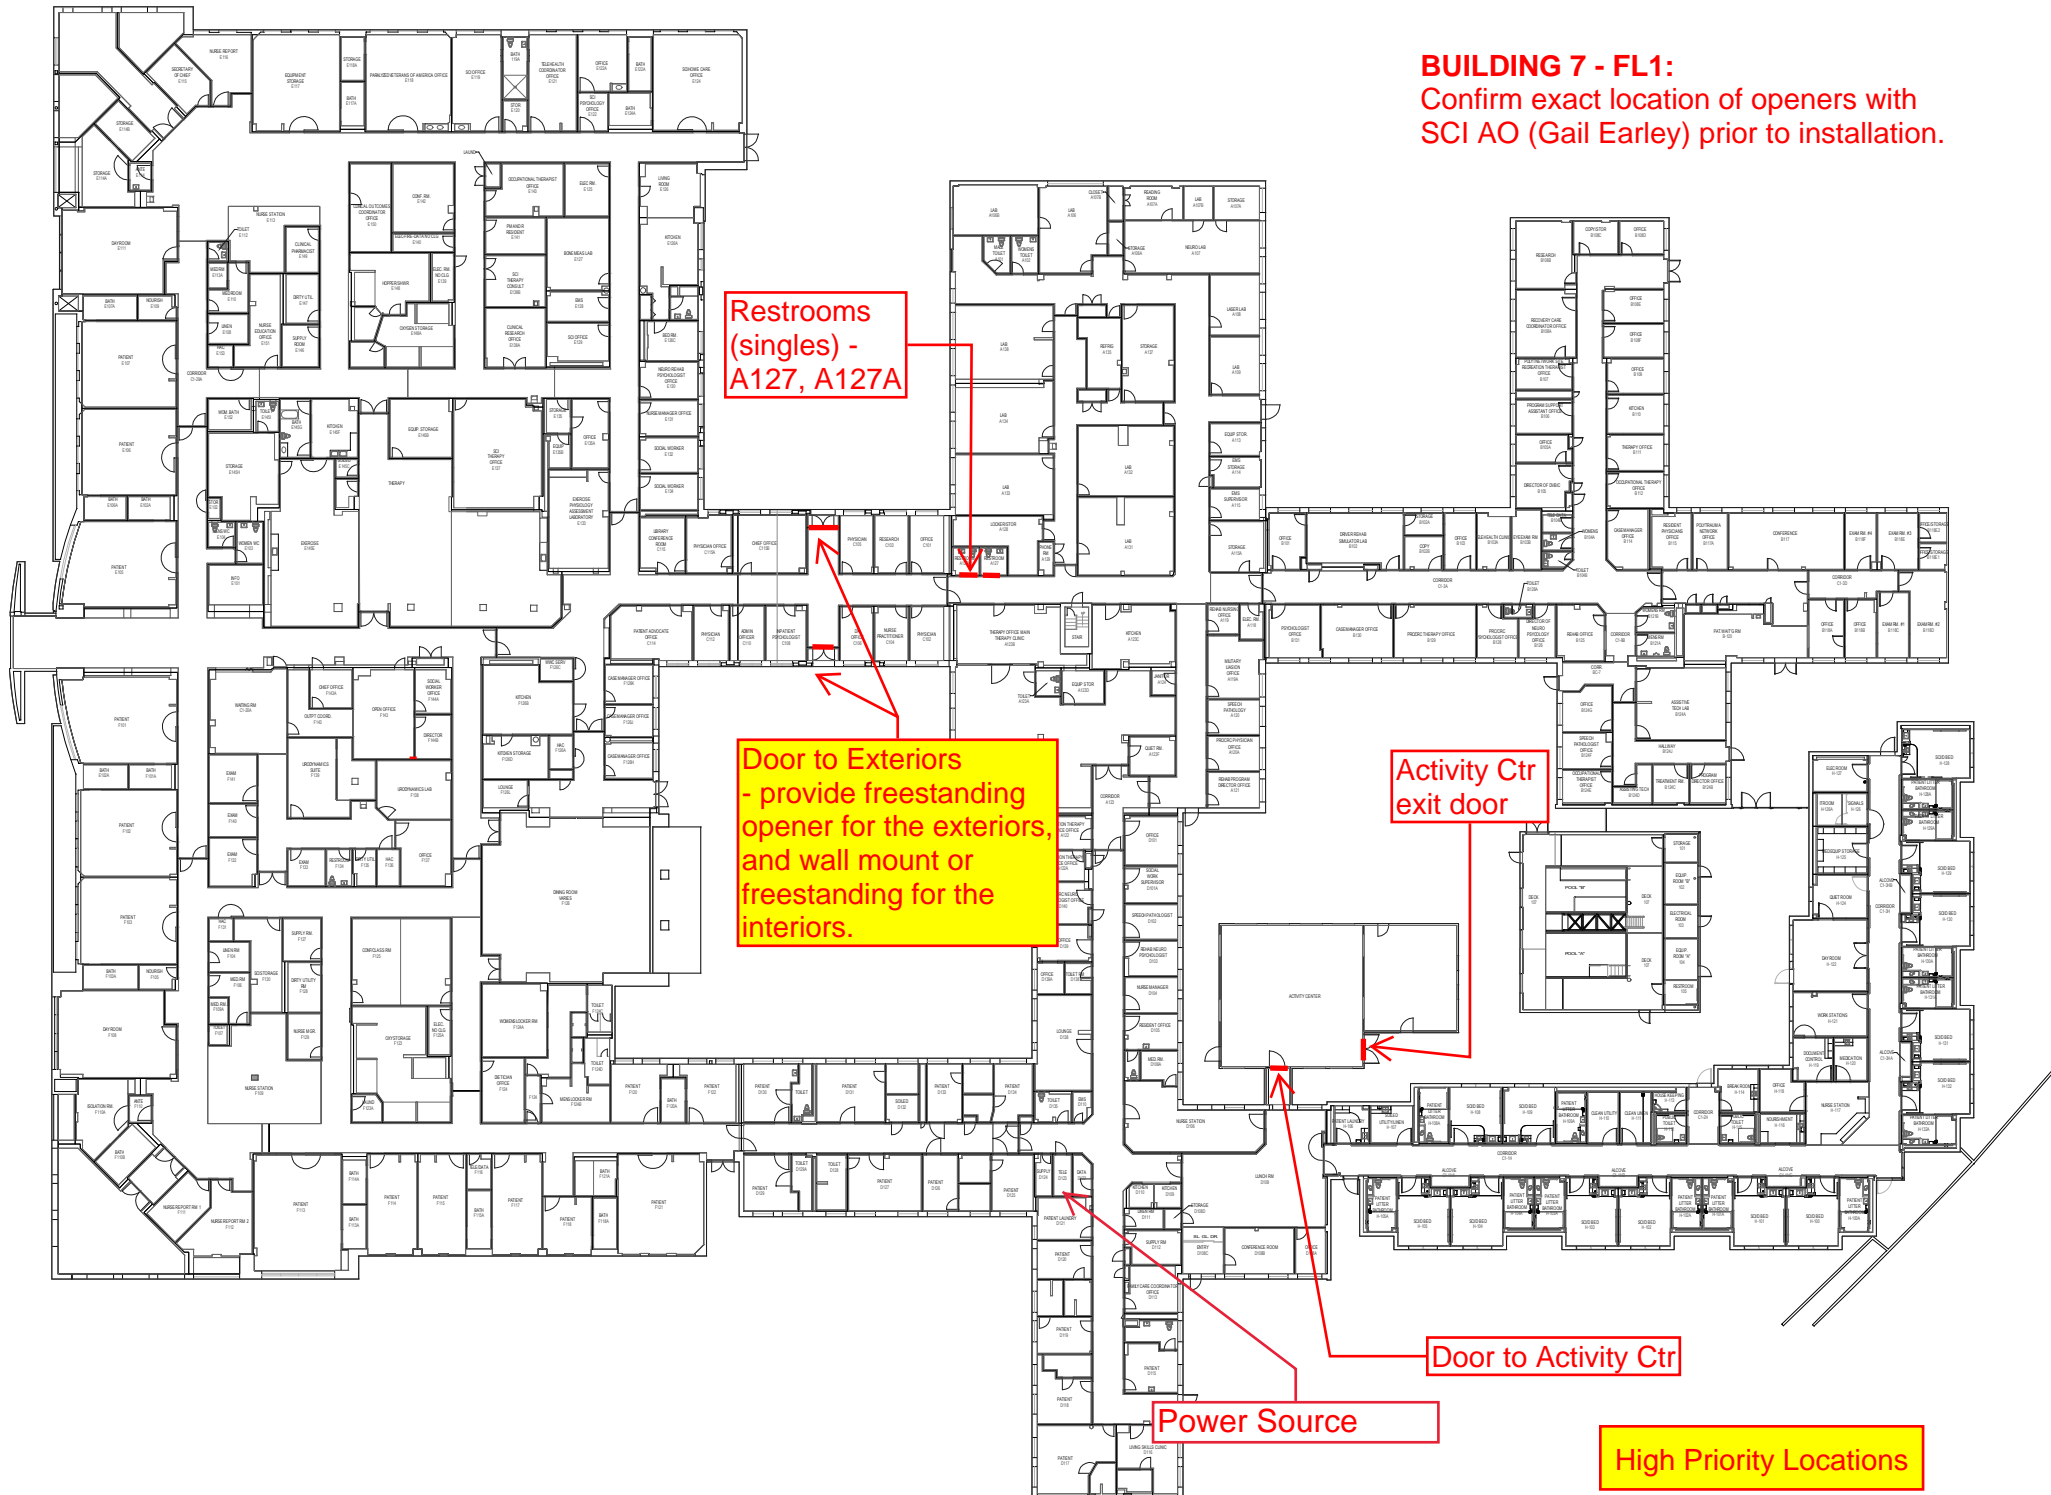

Scale 1 : 635.712489 (Inches).

Printed from: iDrawings on 05 April 2017 10:12:07