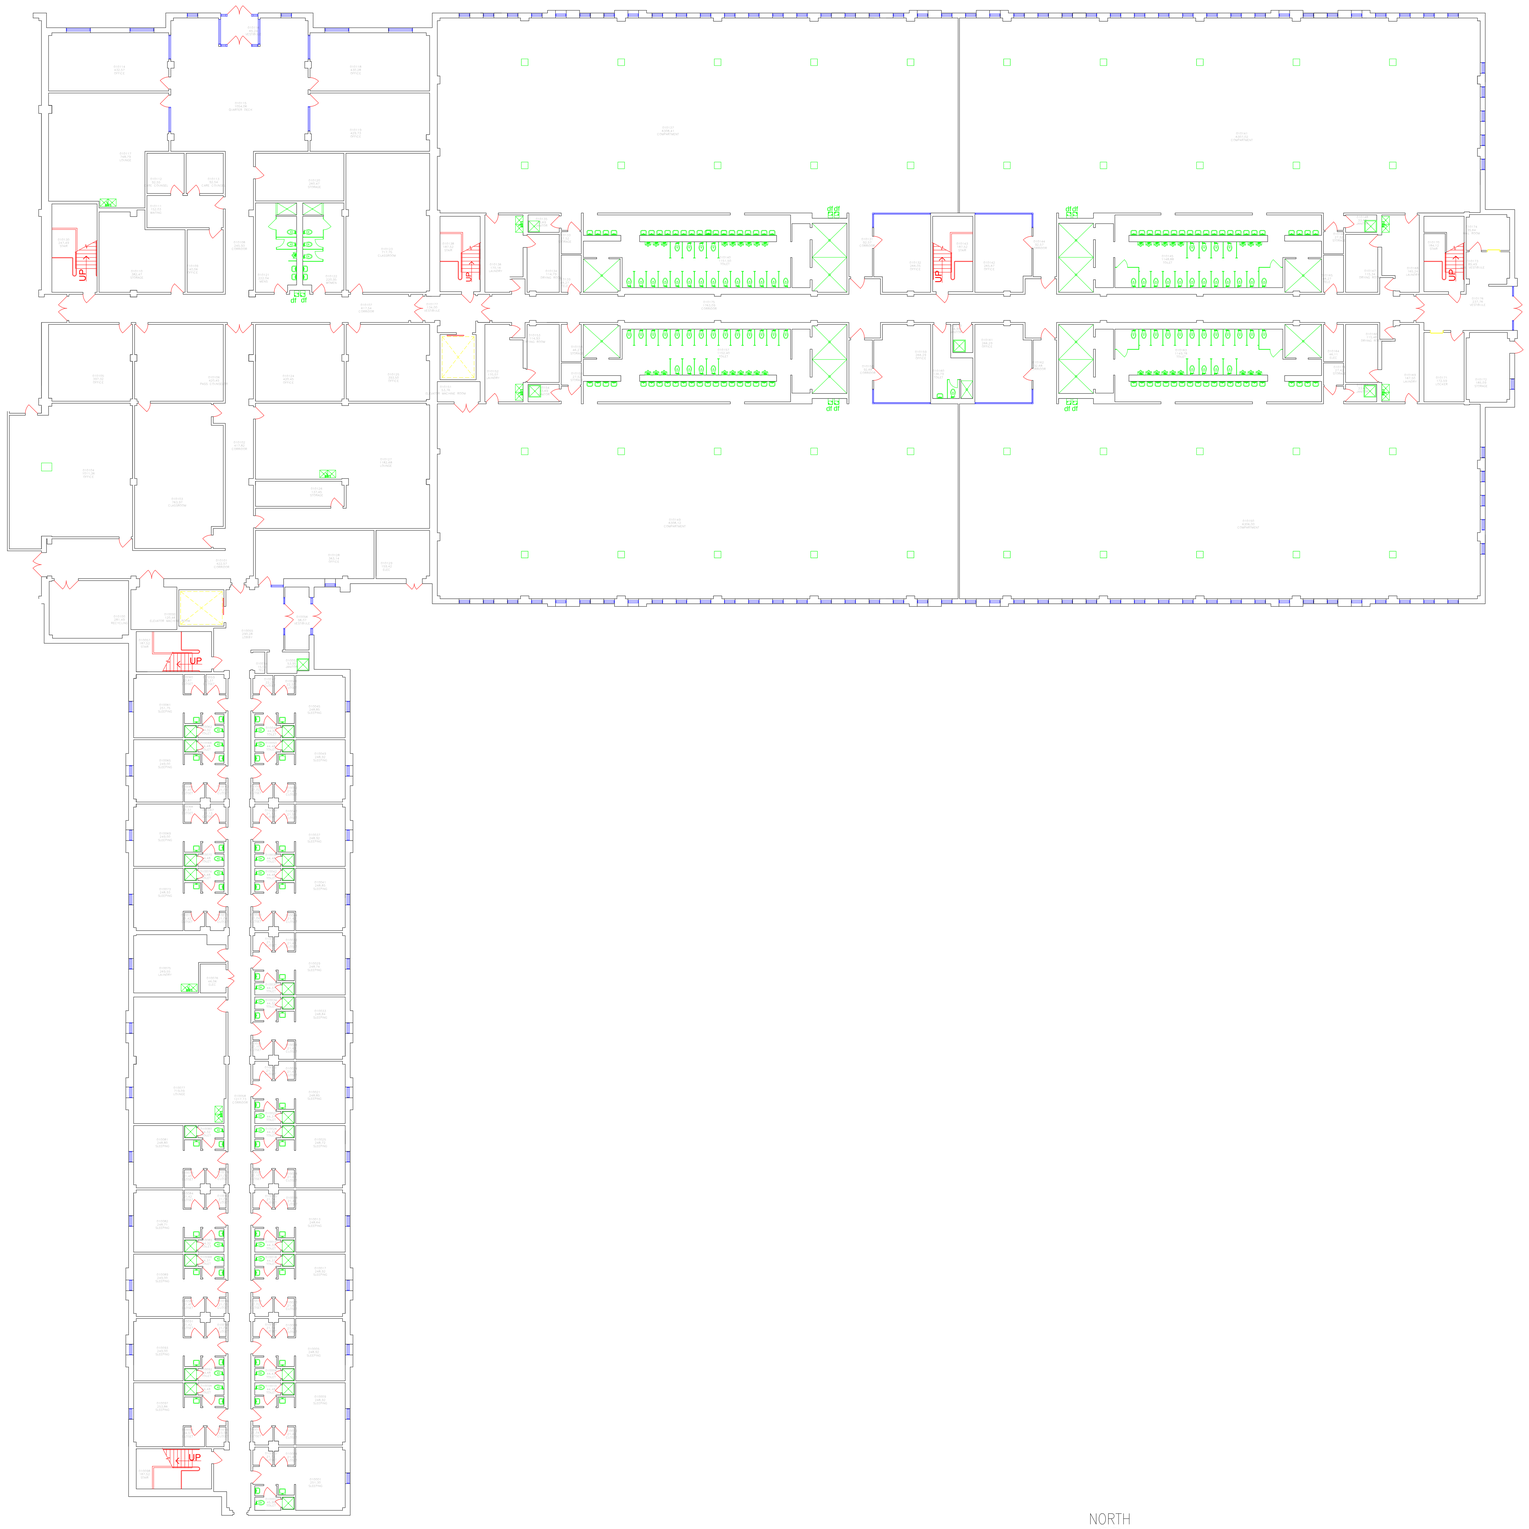


1 BUILDING 7105 - FIRST FLOOR PLAN

Scale: GRAPHIC 0 20' 40'

NORTH

**VERIFIED FLOOR PLAN** 2011 - SAIC

Note: UOM is INCH for Adobe measuring tool

**NAVFAC MIDLANT GeoReadiness Center**

NFA200000893785_7105_01_fp.dwg 28 MAY 2015

This plan belongs to the CRNMA GeoReadiness Center (GRC). Plans and maps from the GRC are believed to be accurate but this is not guaranteed and the burden for determining accuracy, completeness and appropriateness for use rests solely on the user accessing this information. Data owners should be consulted if field verification or additional information is needed. This material is For Official Use Only. Reproduction, distribution, publication, or exhibition of this data is strictly prohibited without the written consent of the CNRMA GRC.

# Building 7105
# First Floor

BD-GIS Mid-Atlantic
Norfolk, VA 23511
(757) 444-4716
PWCNORVA_GIS_WEB@nmci-isf.com