



1

BUILDING 7105 - SECOND FLOOR PLAN


Scale: GRAPHIC
0 20' 40'



VERIFIED FLOOR PLAN

2011 - SAIC

Note: UOM is INCH for Adobe measuring tool

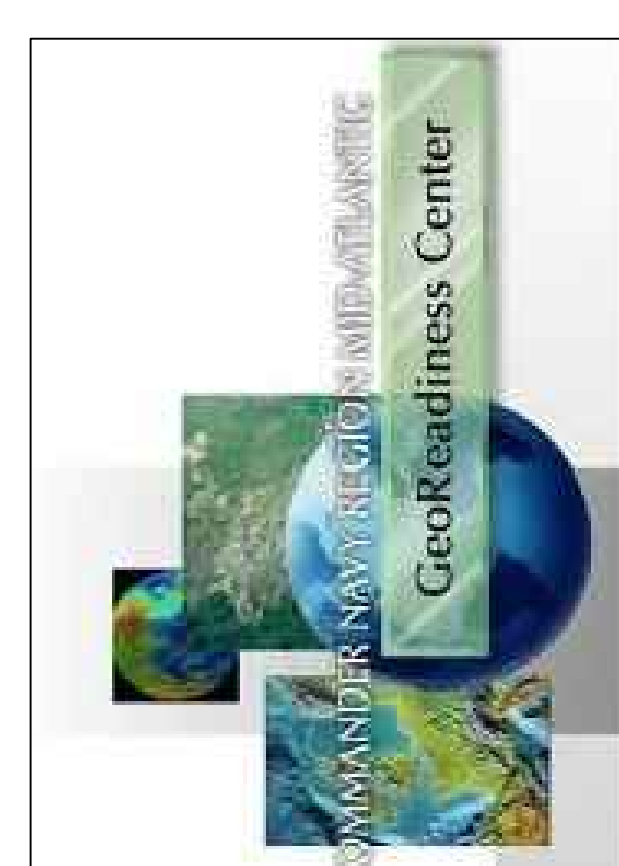

BD-GIS Mid-Atlantic
Norfolk, VA 23511
(757) 444-4716
PWCNORVA_GIS_WEB@nmc-hsf.com

**Building 7105
Second Floor**

NAVFAC MIDLANT GeoReadiness Center

NFA200000892785_7105_02_ip.dwg 28 MAY 2015
This plan belongs to the CNRMA GeoReadiness Center (GRC). Plans and maps from the GRC are believed to be accurate but this is not guaranteed and the burden for determining accuracy, completeness and appropriateness for use rests solely on the user accessing this information. Data owners should be consulted if field verification or additional information is needed. This material is For Official Use Only. Reproduction, distribution, publication, or exhibition of this data is strictly prohibited without the written consent of the CNRMA GRC.