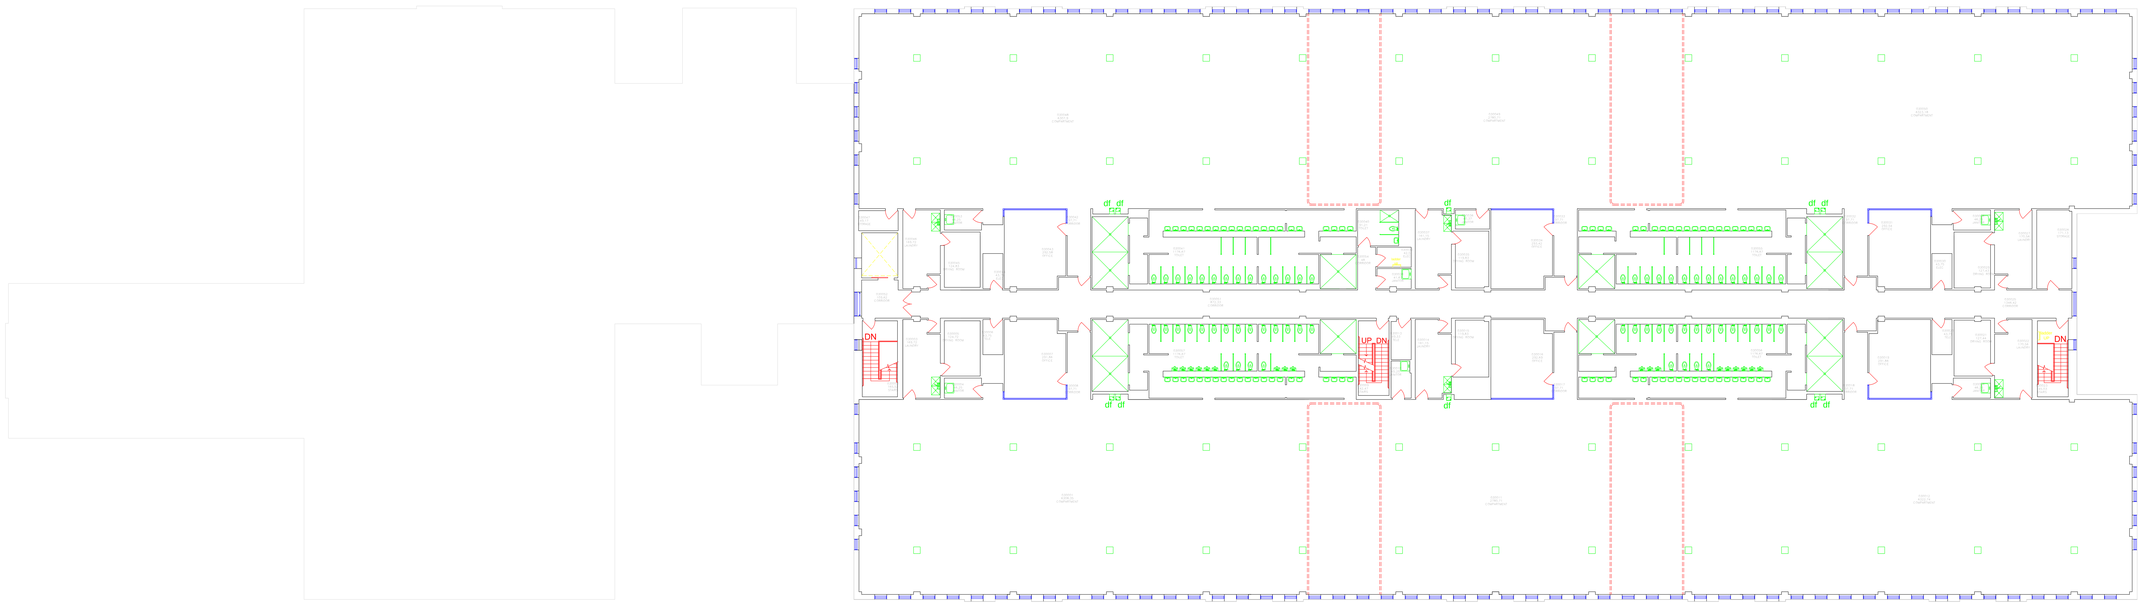

1 BUILDING 7114 - THIRD FLOOR PLAN

Scale: GRAPHIC 0 20' 40'

NORTH

VERIFIED FLOOR PLAN 2011 - SAIC

Note: UOM is INCH for Adobe measuring tool

NAVFAC MIDLANT GeoReadiness Center

NFA200000445957_7114_03_fp.dwg 26 MAY 2015

This plan belongs to the CRNMA GeoReadiness Center (GRC). Plans and maps from the GRC are believed to be accurate but this is not guaranteed and the burden for determining accuracy, completeness and appropriateness for use rests solely on the user accessing this information. Data owners should be consulted if field verification or additional information is needed. This material is For Official Use Only. Reproduction, distribution, publication, or exhibition of this data is strictly prohibited without the written consent of the CNRMA GRC.

Building 7114
Third Floor

BD-GIS Mid-Atlantic
Norfolk, VA 23511
(757) 444-4716
PWCNORVA_GIS_WEB@nmci-isf.com