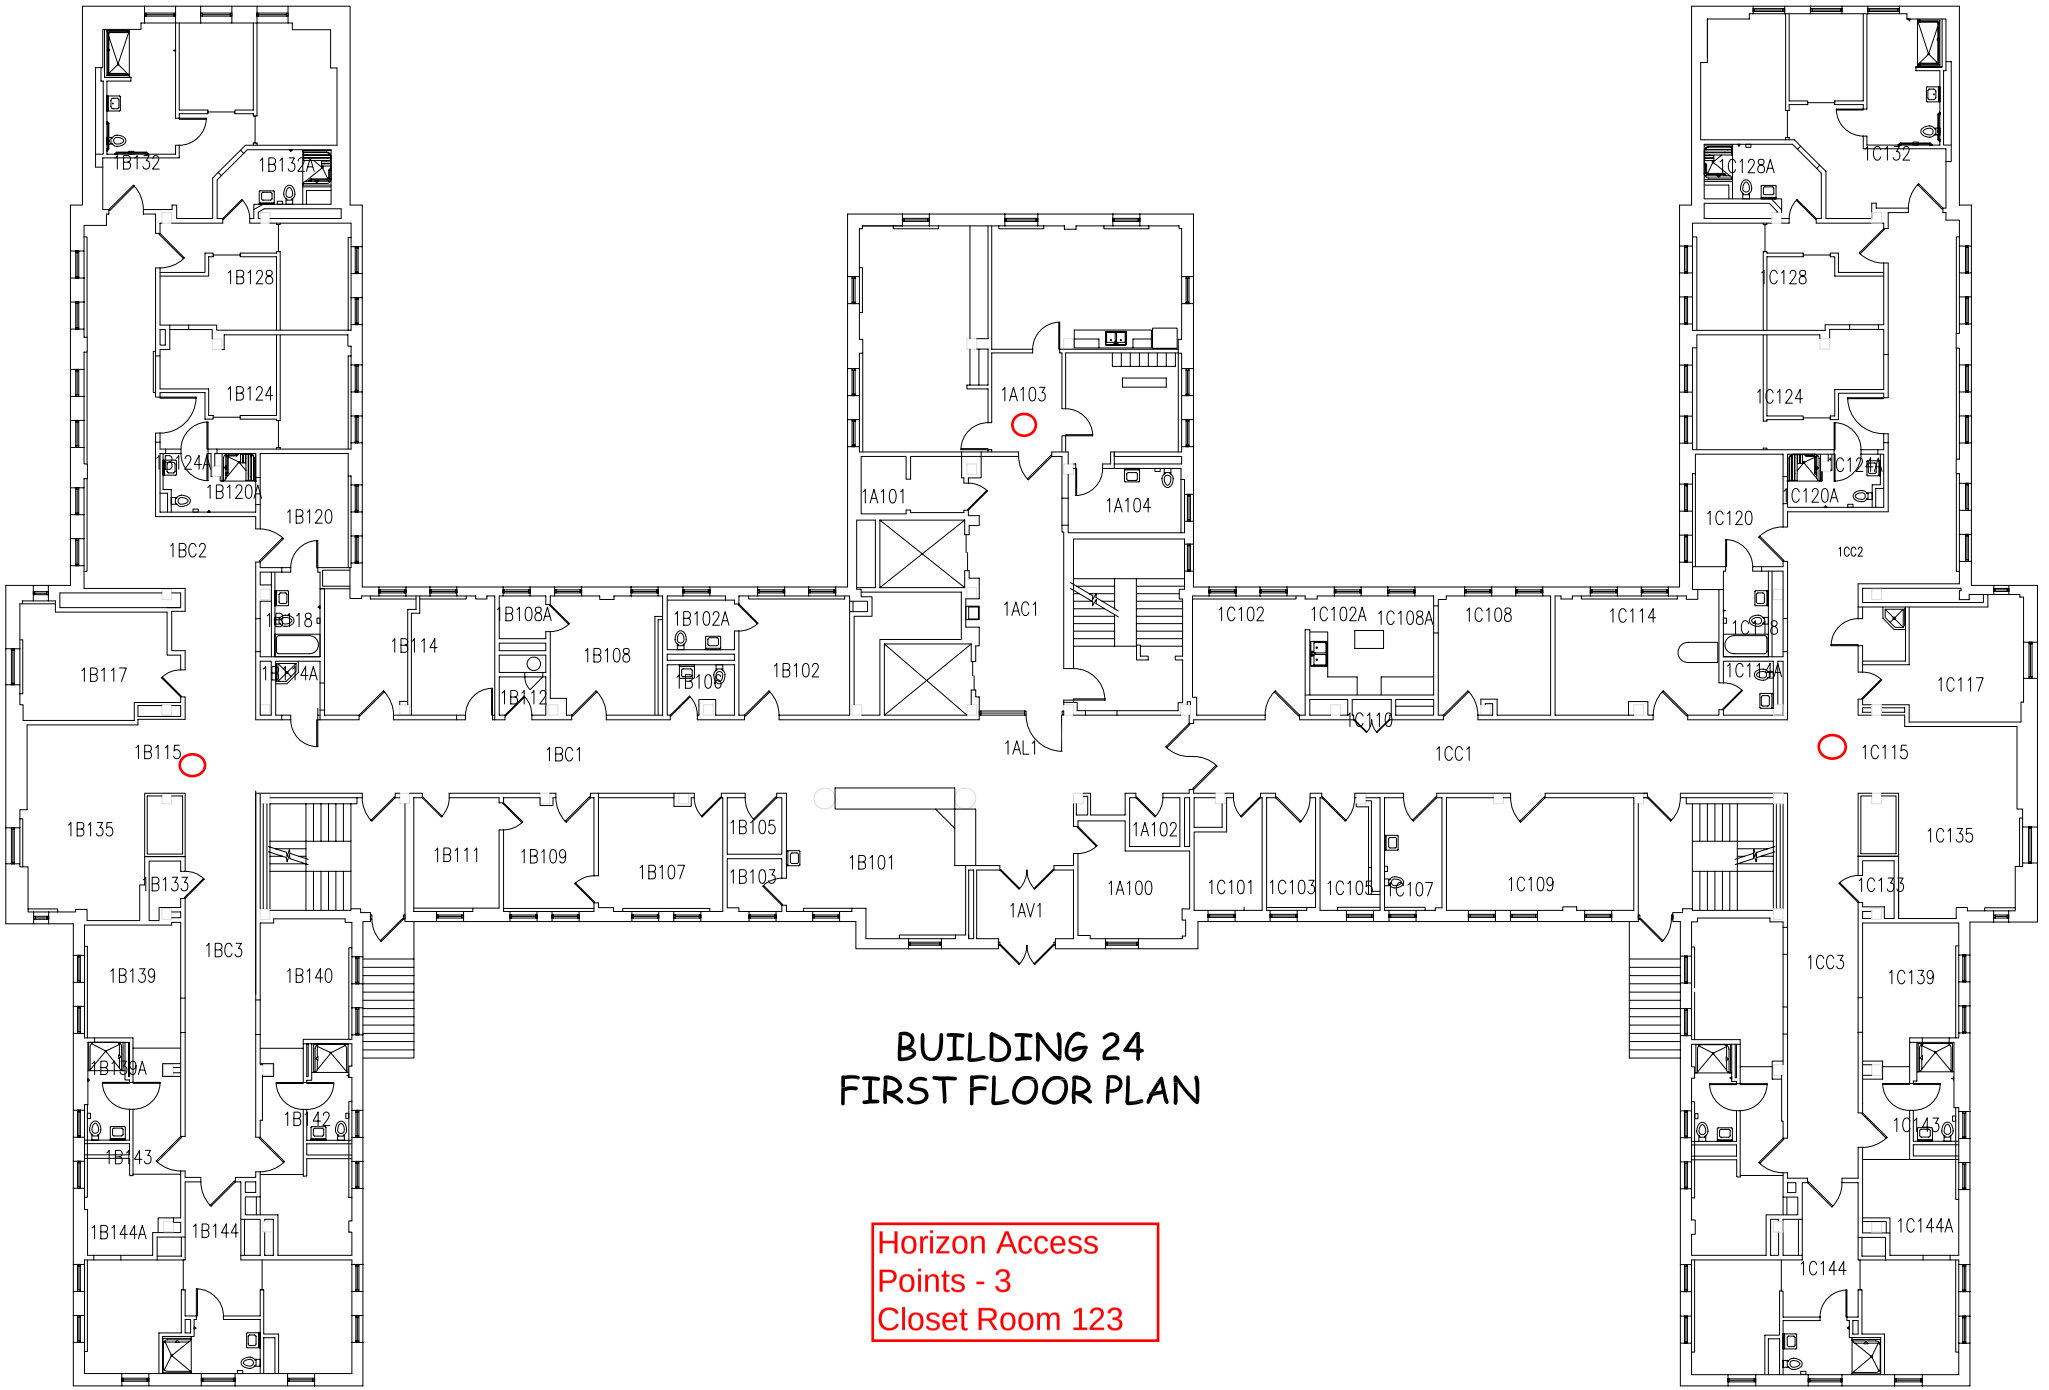

BUILDING 24
FIRST FLOOR PLAN

Horizon Access
Points - 3
Closet Room 123