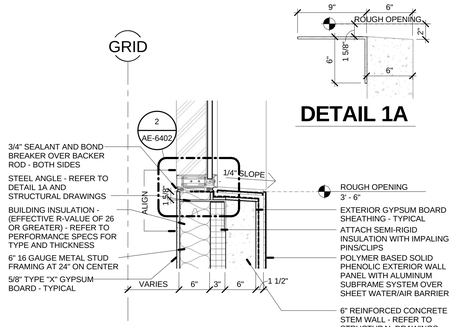

DETAIL 1A

1 SLOT WINDOW SILL

1" = 1'-0"

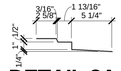

DETAIL 2A

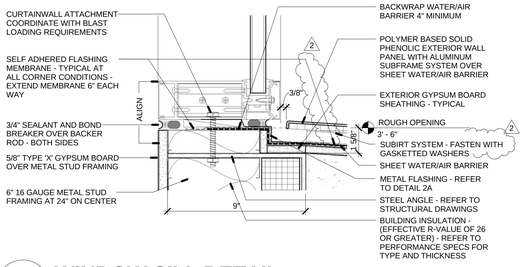

2 WINDOW SILL DETAIL

3" = 1'-0"

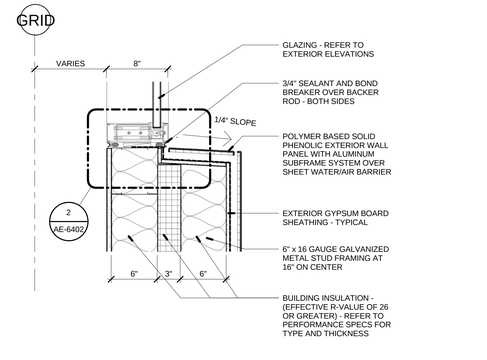

3 WINDOW AT SILL

1 1/2" = 1'-0"

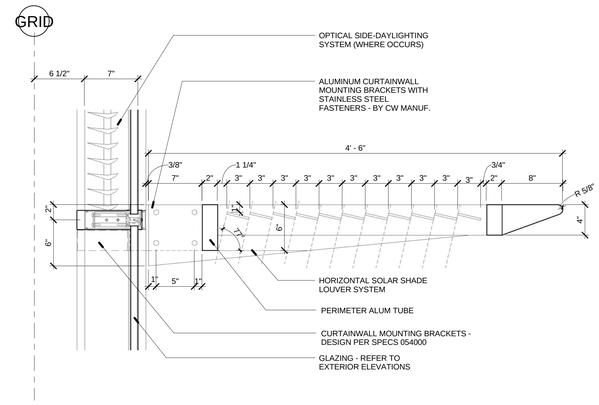

4 TYP. WINDOW SHADE DETAIL

1 1/2" = 1'-0"

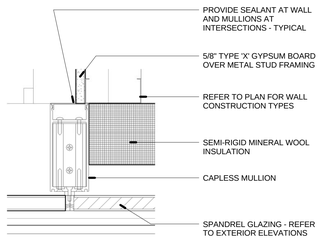

5 TYPICAL WALL DETAIL AT MULLION

3" = 1'-0"

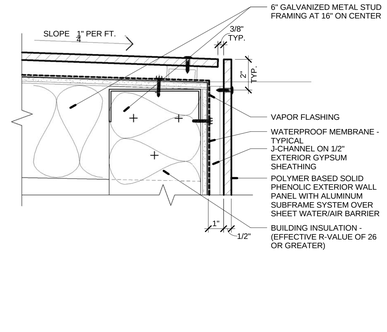

6 EXTERIOR SILL DETAIL

3" = 1'-0"

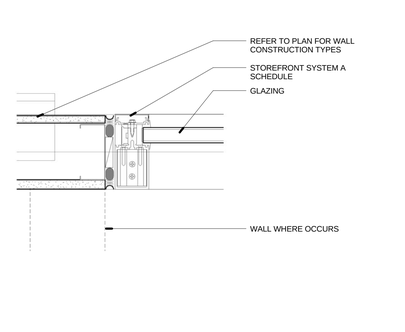

7 INTERIOR STOREFRONT JAMB DETAIL

3" = 1'-0"

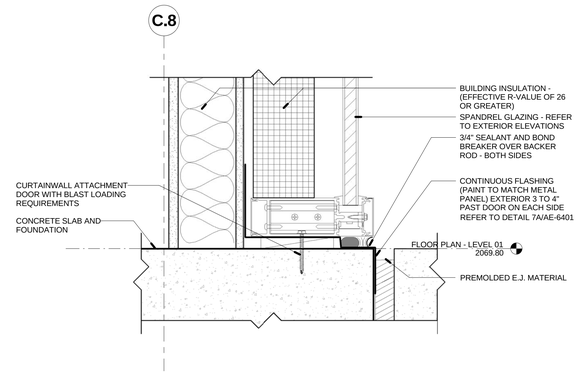

8 CURTAIN WALL SILL ENLARGED DETAIL

3" = 1'-0"

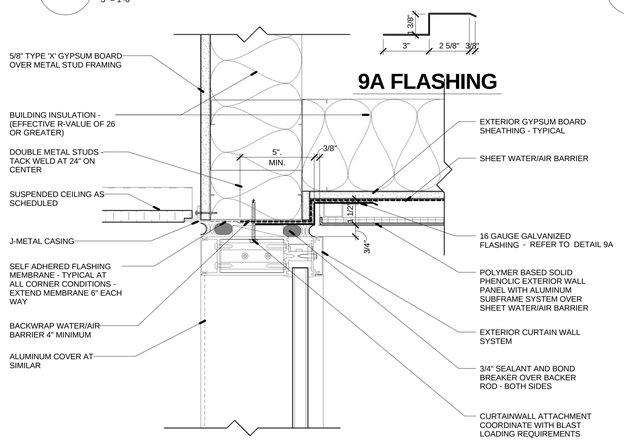

9 SLOT WINDOW HEAD DETAIL (JAMB SIMILAR)

3" = 1'-0"

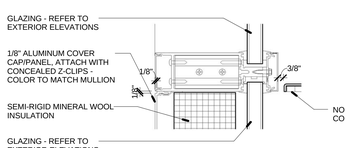

10 MULLION DETAIL AT ALUM COVER

3" = 1'-0"

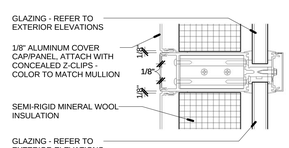

11 MULLION DETAIL AT ALUM COVER

3" = 1'-0"

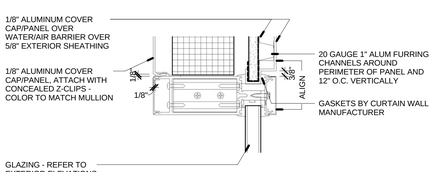

12 MULLION DETAIL AT ALUM COVER

3" = 1'-0"

CONSTRUCTION DOCUMENTS

BUILDING IS FULLY SPRINKLERED

Revisions:	Date:
1 Addendum #01	08/15/2012
2 Addendum #02	08/22/2012

CONSULTANTS:

CIVIL:	SLATER HANIFAN GROUP, 5740 S. ARVILLE ST. #216, LAS VEGAS, NV 89118
LANDSCAPE:	J W ZUNINO LANDSCAPE ARCHITECTURE, 3191 S. JONES BLVD., LAS VEGAS, NV 89146
MEP:	JBA CONSULTING ENGINEERING, 5155 WEST PATRICK LANE, LAS VEGAS, NV 89118
STRUCTURAL:	DEGENKOLB ENGINEERING, 235 MONTGOMERY STREET, SUITE 500, SAN FRANSISCO CA 94104
GEOTECHNICAL:	NINYO AND MOORE, 6700 PARADISE ROAD, SUITE E, LAS VEGAS, NV 89119
FIRE & LIFE SAFETY:	LASALLE ENGINEERING, 1000 YORK ROAD, WILLOW GROVE, PA 19090

KEY PLAN

ARCHITECT/ENGINEERS:

RTKL JMA ARCHITECTURE STUDIOS
A Joint Venture

SYLVIA J. KIM REGISTERED No. 5207 ARCHITECT STATE OF NEVADA

Drawing Title: **Window Details**

Scale: **As indicated**

Approved: Project Director

Project Title: **VA Medical Center - PHASE V, Administration Bldg. & Education Ctr. Addition**

Location: North Las Vegas, NV

Date: June 15, 2012 | Checked: Checker | Drawn: Author

Project Number: **593CA2202**

Building Number: 6

Drawing Number: AE-6402

203 of 512

Office of Construction and Facilities Management

Department of Veterans Affairs

VA FORM 08-6231