

N1-80

PARTITION WALL

N1-79

STORAGE
C1-78A

STORAGE
C1-78

New 2-hour rated
mechanical room.
Replace existing
frame and door with
rated assembly.
Remove existing
floor finish down to
concrete. Current
floor tile mastic has
ACM. Demo interior
partition and door.

DN
STAIR-3

UP

PIV/ID
C1-77

C1-76

C1-56C

ELEVATOR
4

ELEVATOR
3

ELEVATOR
2

ELEVATOR
1

CORRIDOR
C1-75

CORRIDOR
C1-56B

C1-59

58

C1-60

FEMALE
TOILET

N2-48

maintain existing
rated shaft

MECH
N2-47A

C2-47

DN

STAIR-3

UP

C2-46

MECH
C2-106C

ELEVATOR

4

C2-44B


ELEV/


ELEV/

ELEVATOR

3

New 2-hour rated
mechanical room.
Replace existing
door and frame with
rated assembly.
Close shaft wall
inside old SPD.
Remove existing
floor down to
concrete. Current
floor tile mastic has
ACM.

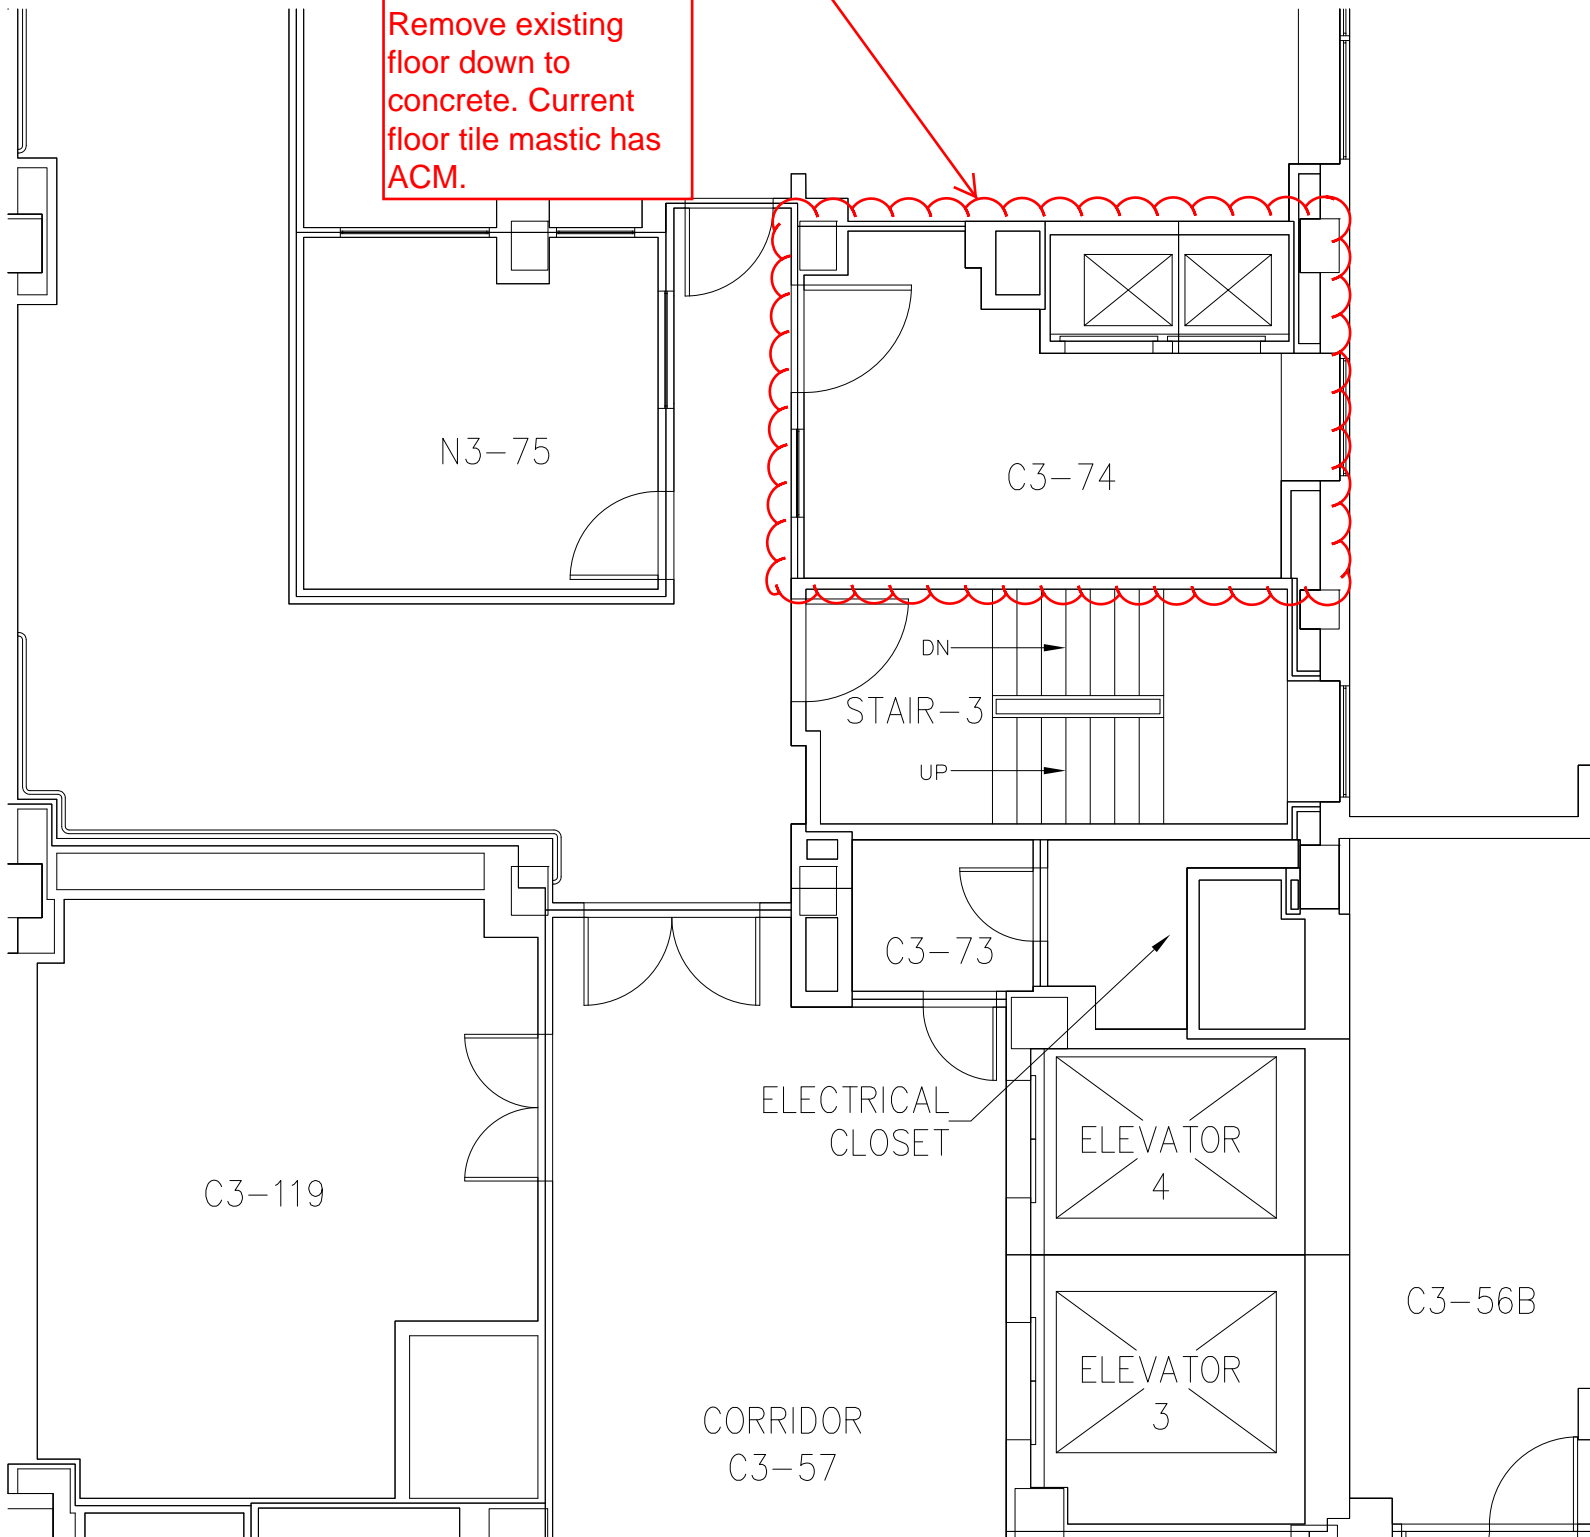

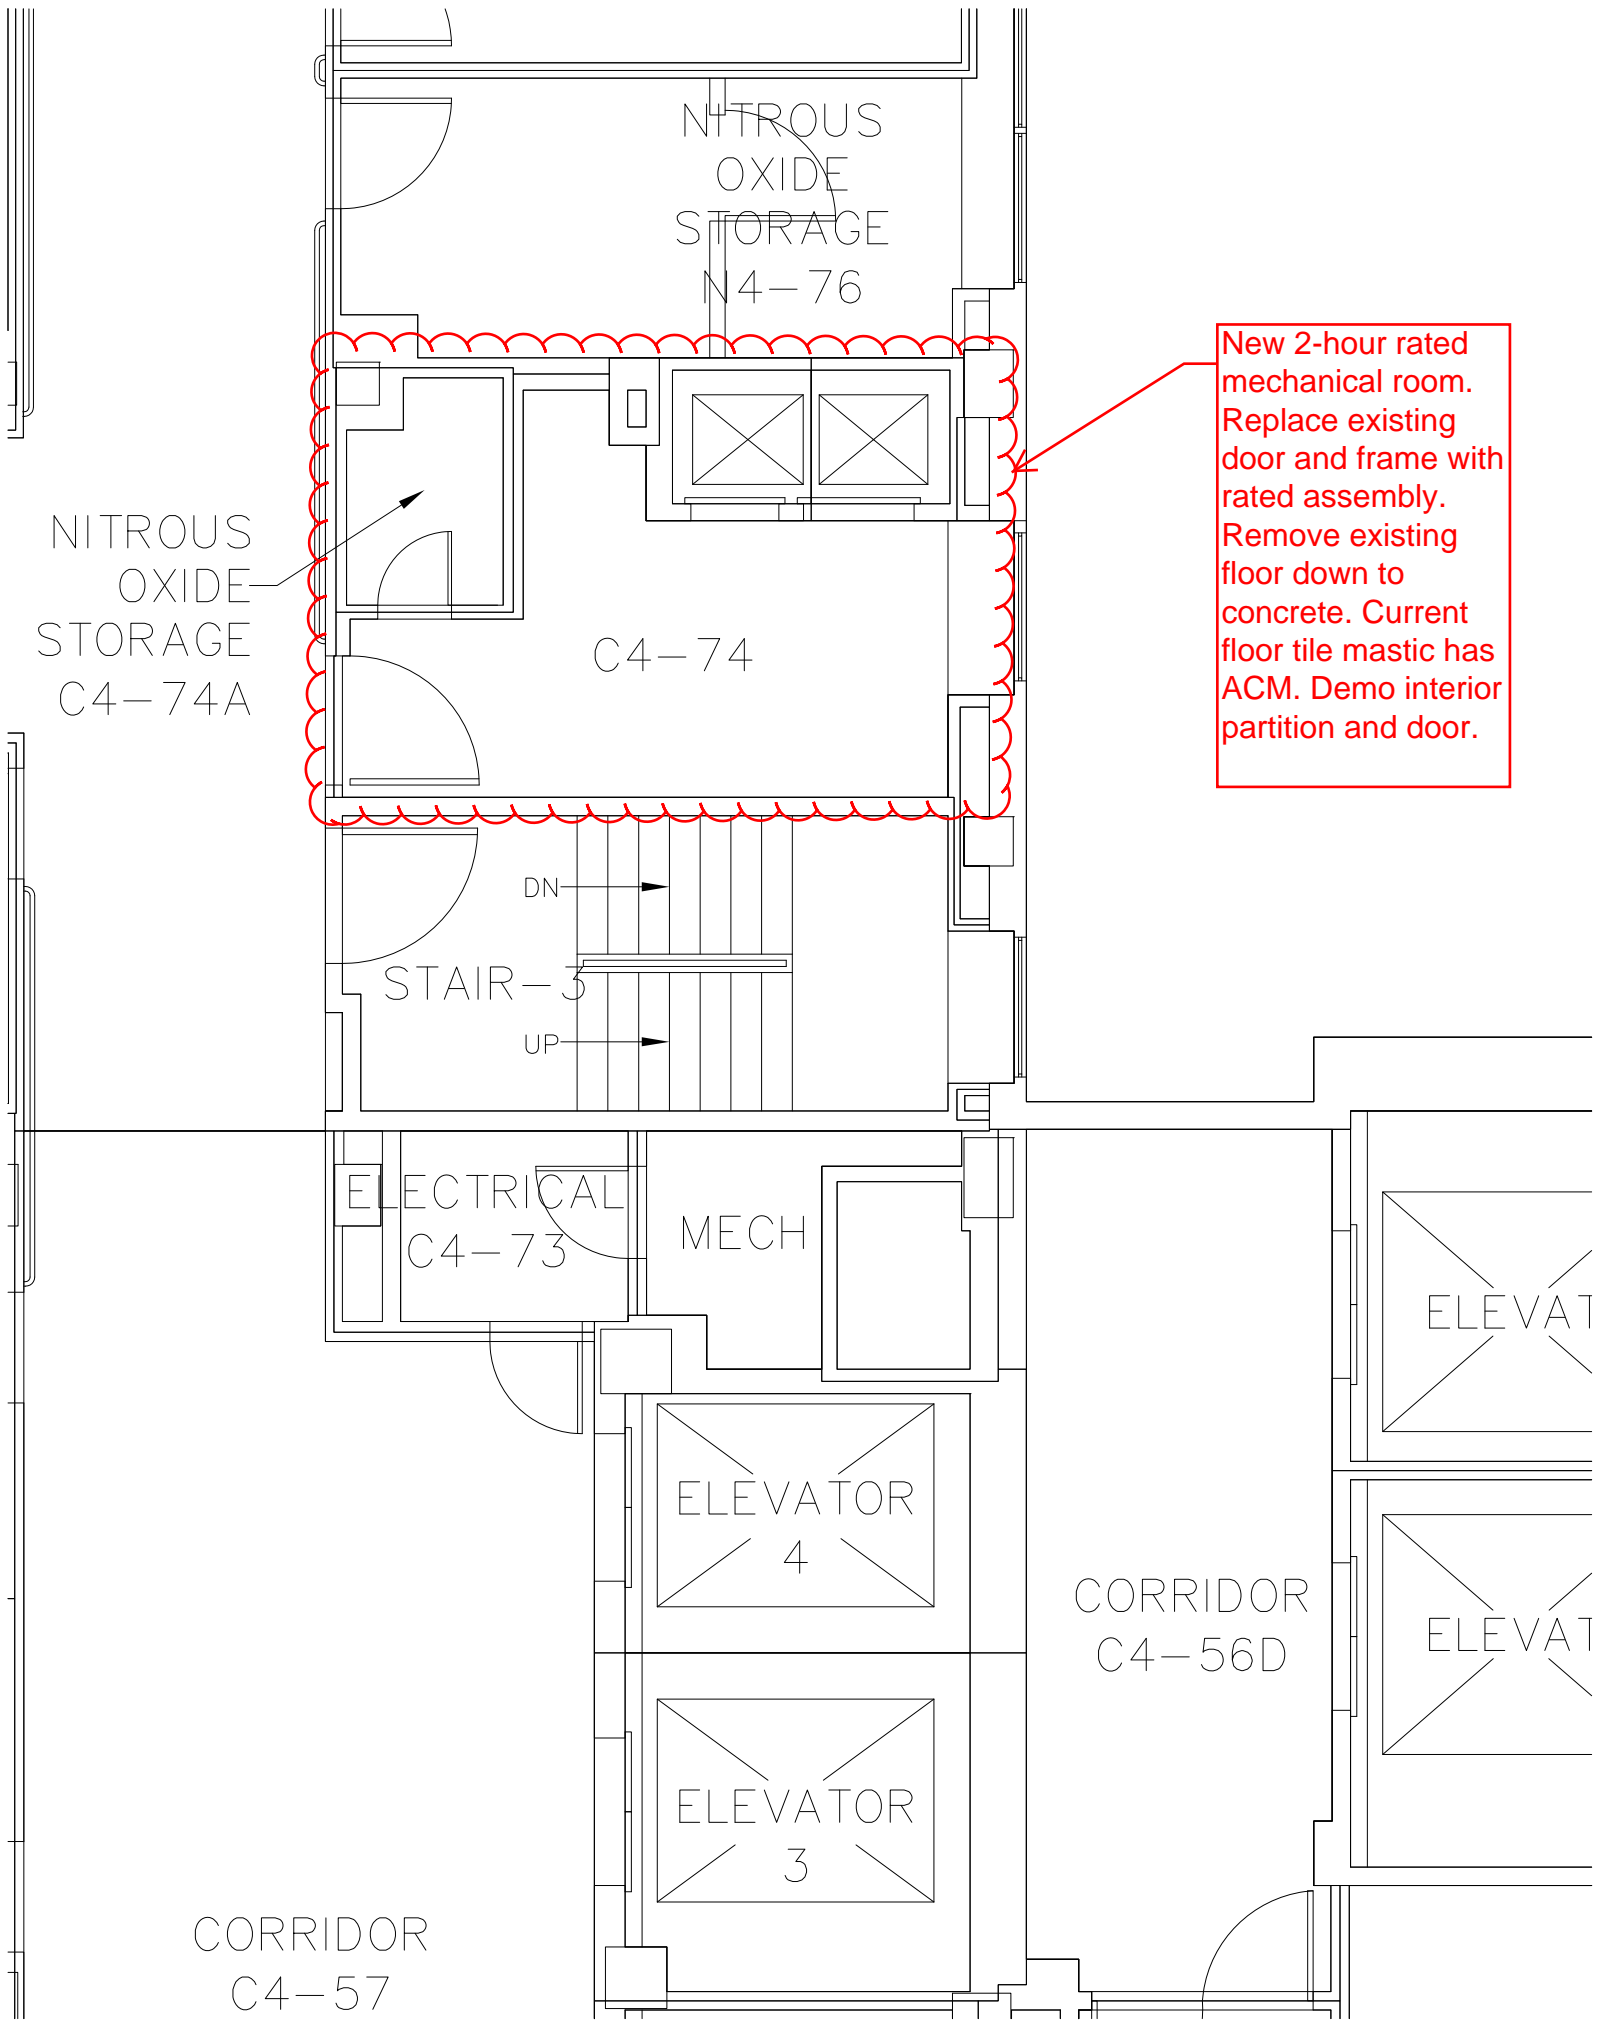

New 2-hour rated mechanical room. Replace existing door and frame with rated assembly. Remove existing floor down to concrete. Current floor tile mastic has ACM. Demo interior partition and door.

STORAGE
C5-74A

STORAGE
C5-74

DN

UP

STAIR-3

ELECTRICAL


ELECTRICAL
C5-73


ELEVATOR

4


CORRIDOR
C5-56

New 2-hour rated
mechanical room.
Replace existing
door and frame with
rated assembly.
Remove existing
flooring down to
concrete. Current
floor tile mastic has
ACM.

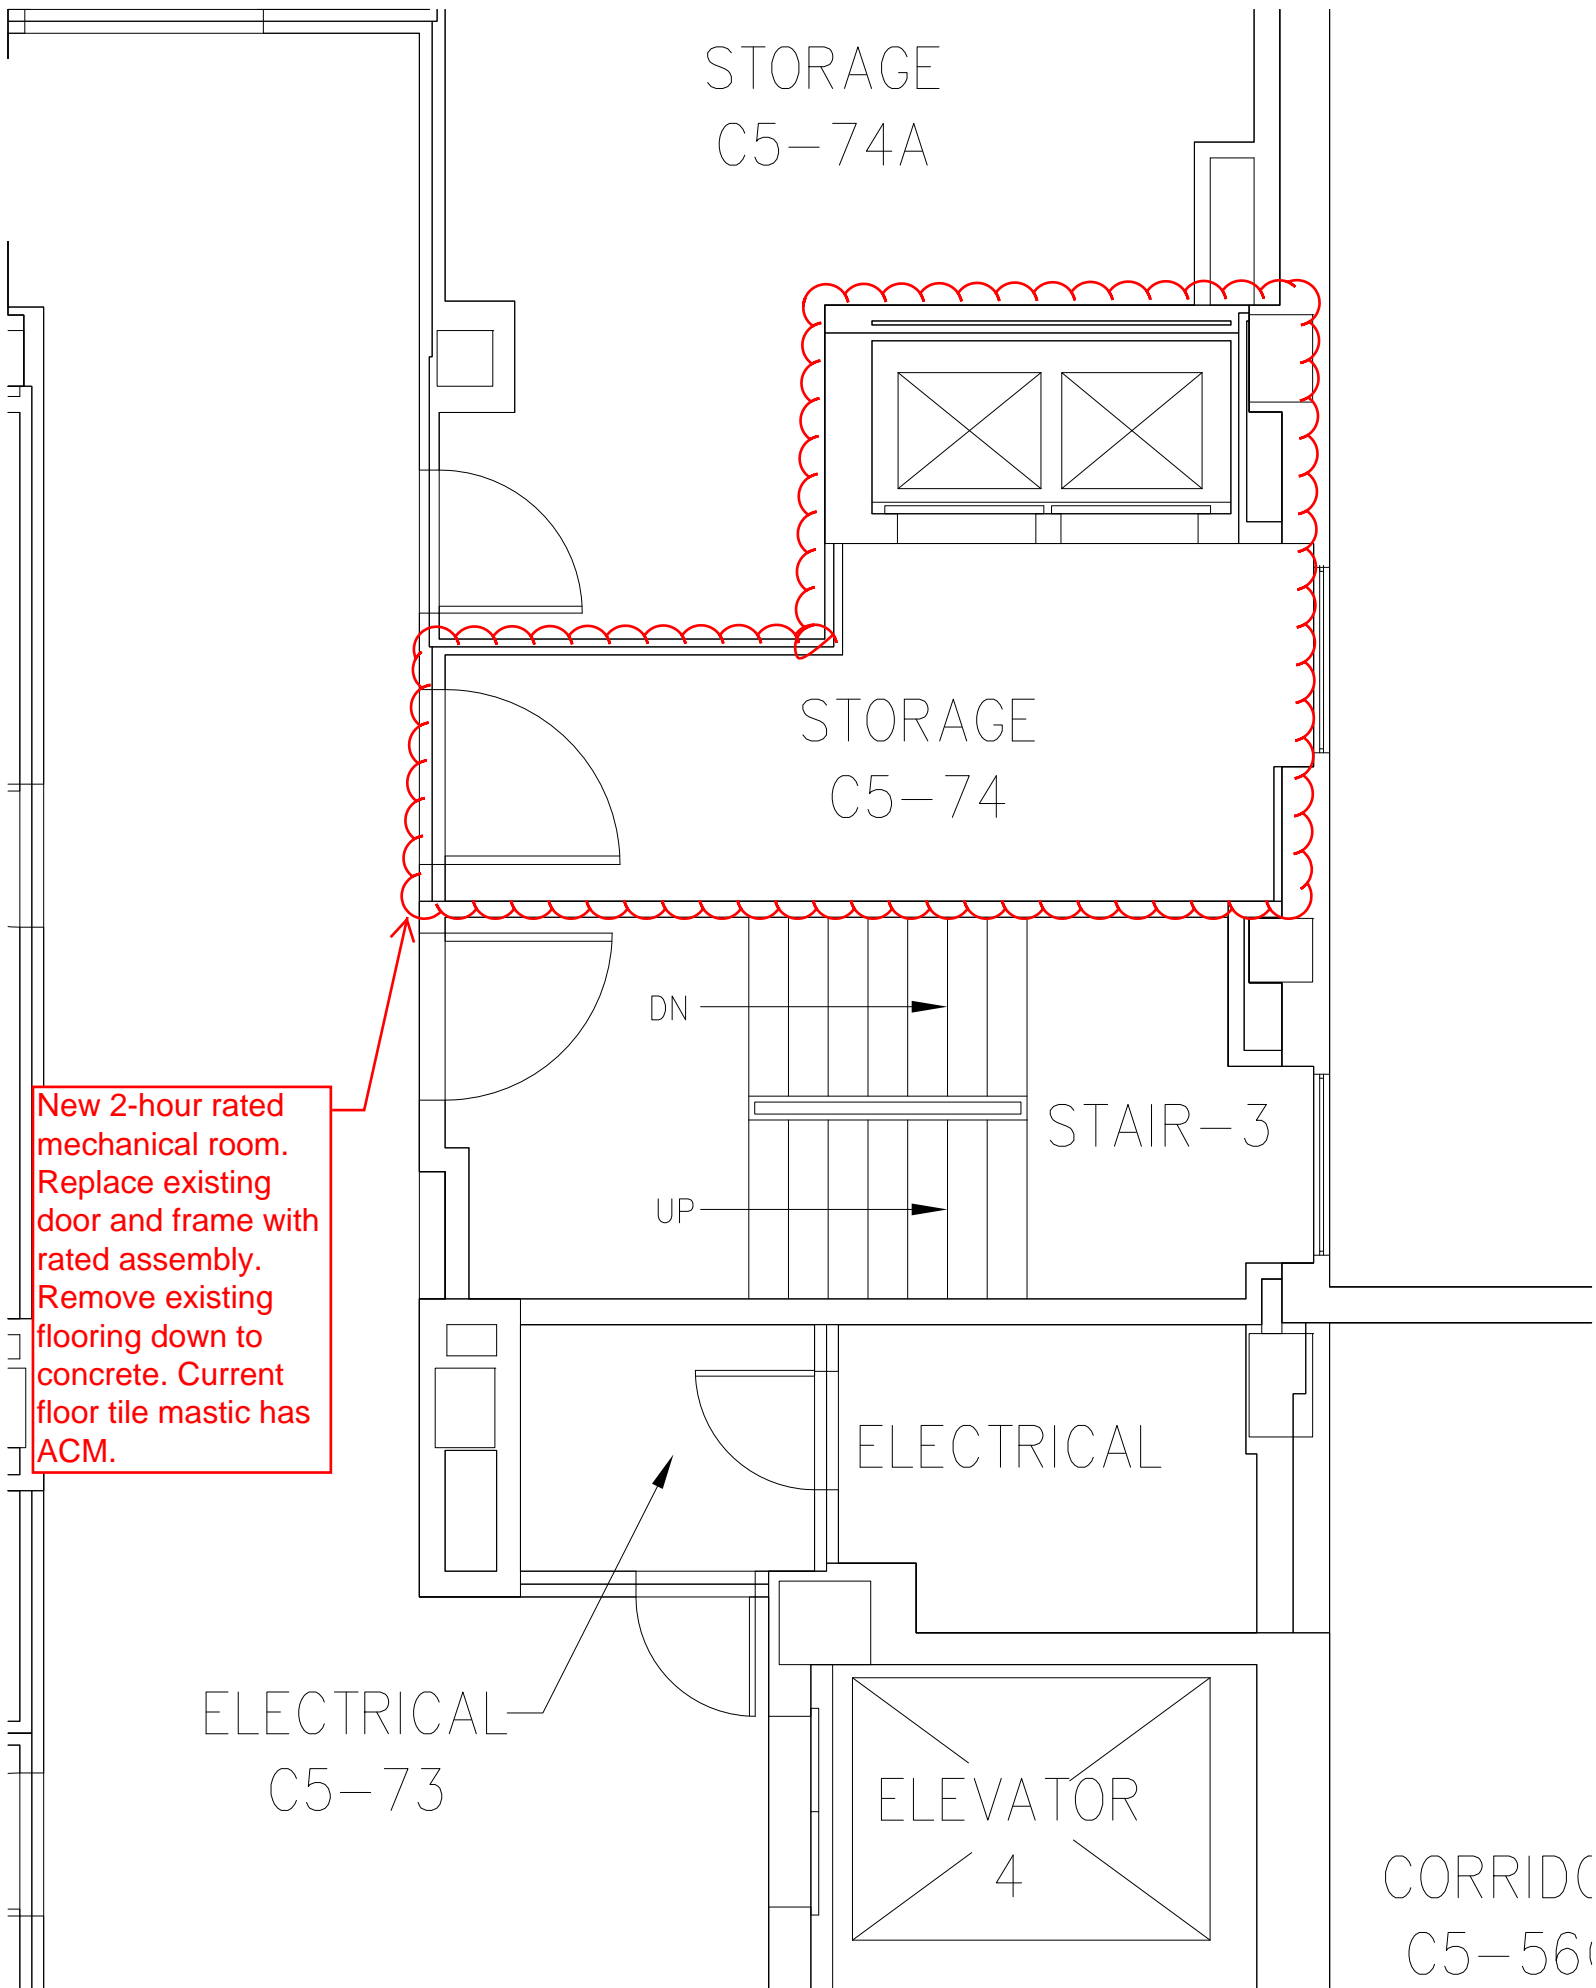

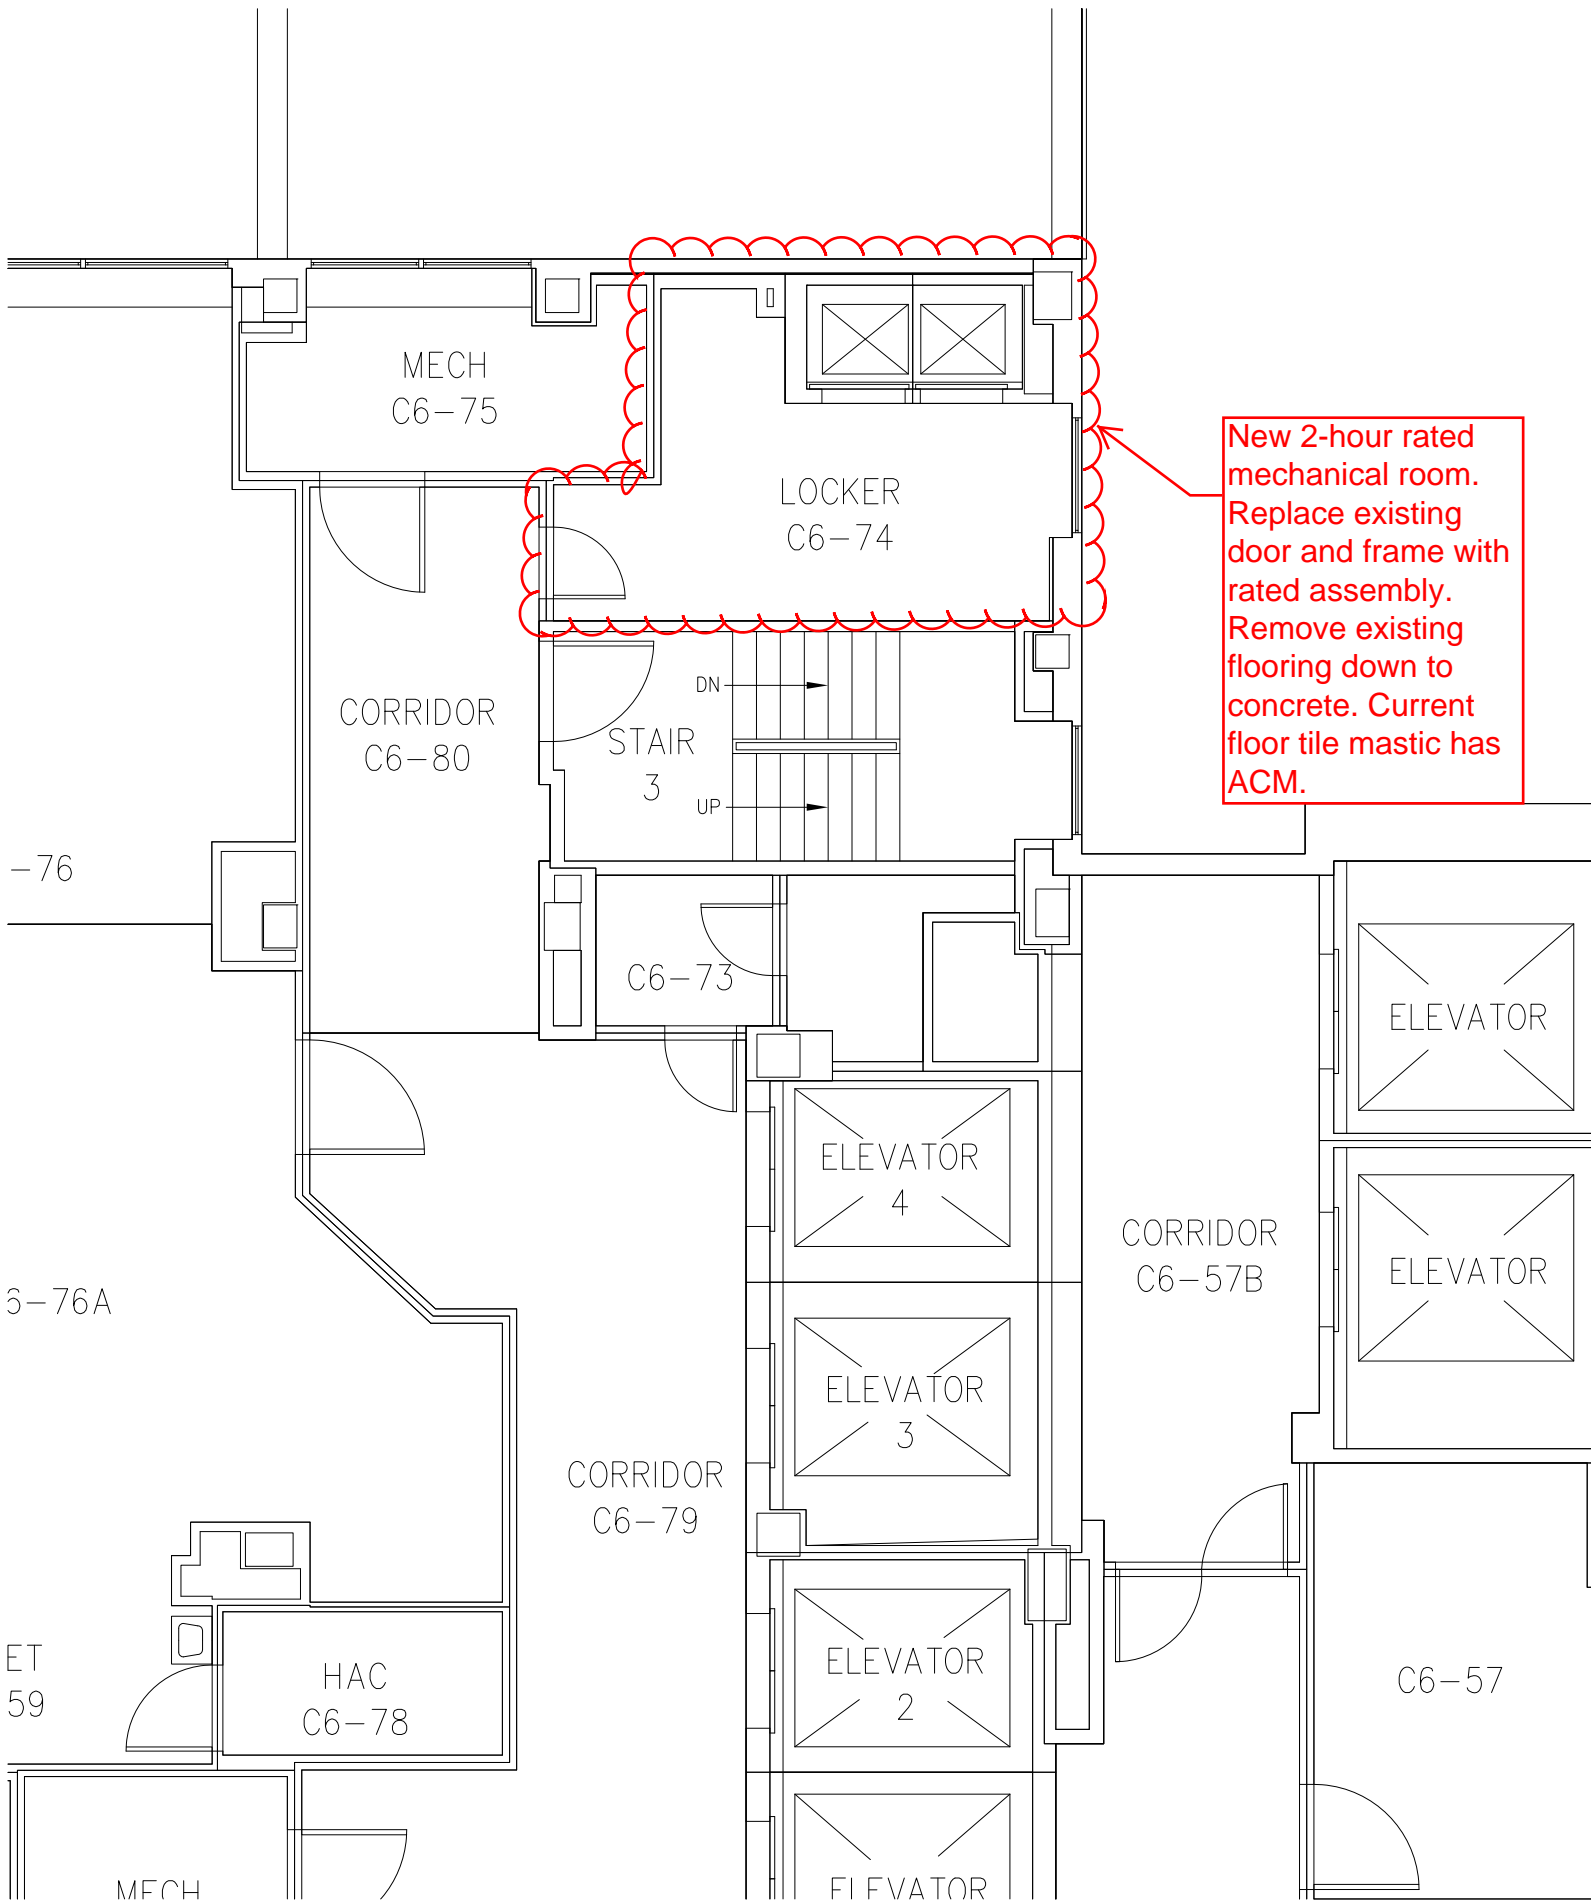

New 2-hour rated
mechanical room.
Replace existing
door and frame with
rated assembly.
Remove existing
flooring down to
concrete. Current
floor tile mastic has
ACM.

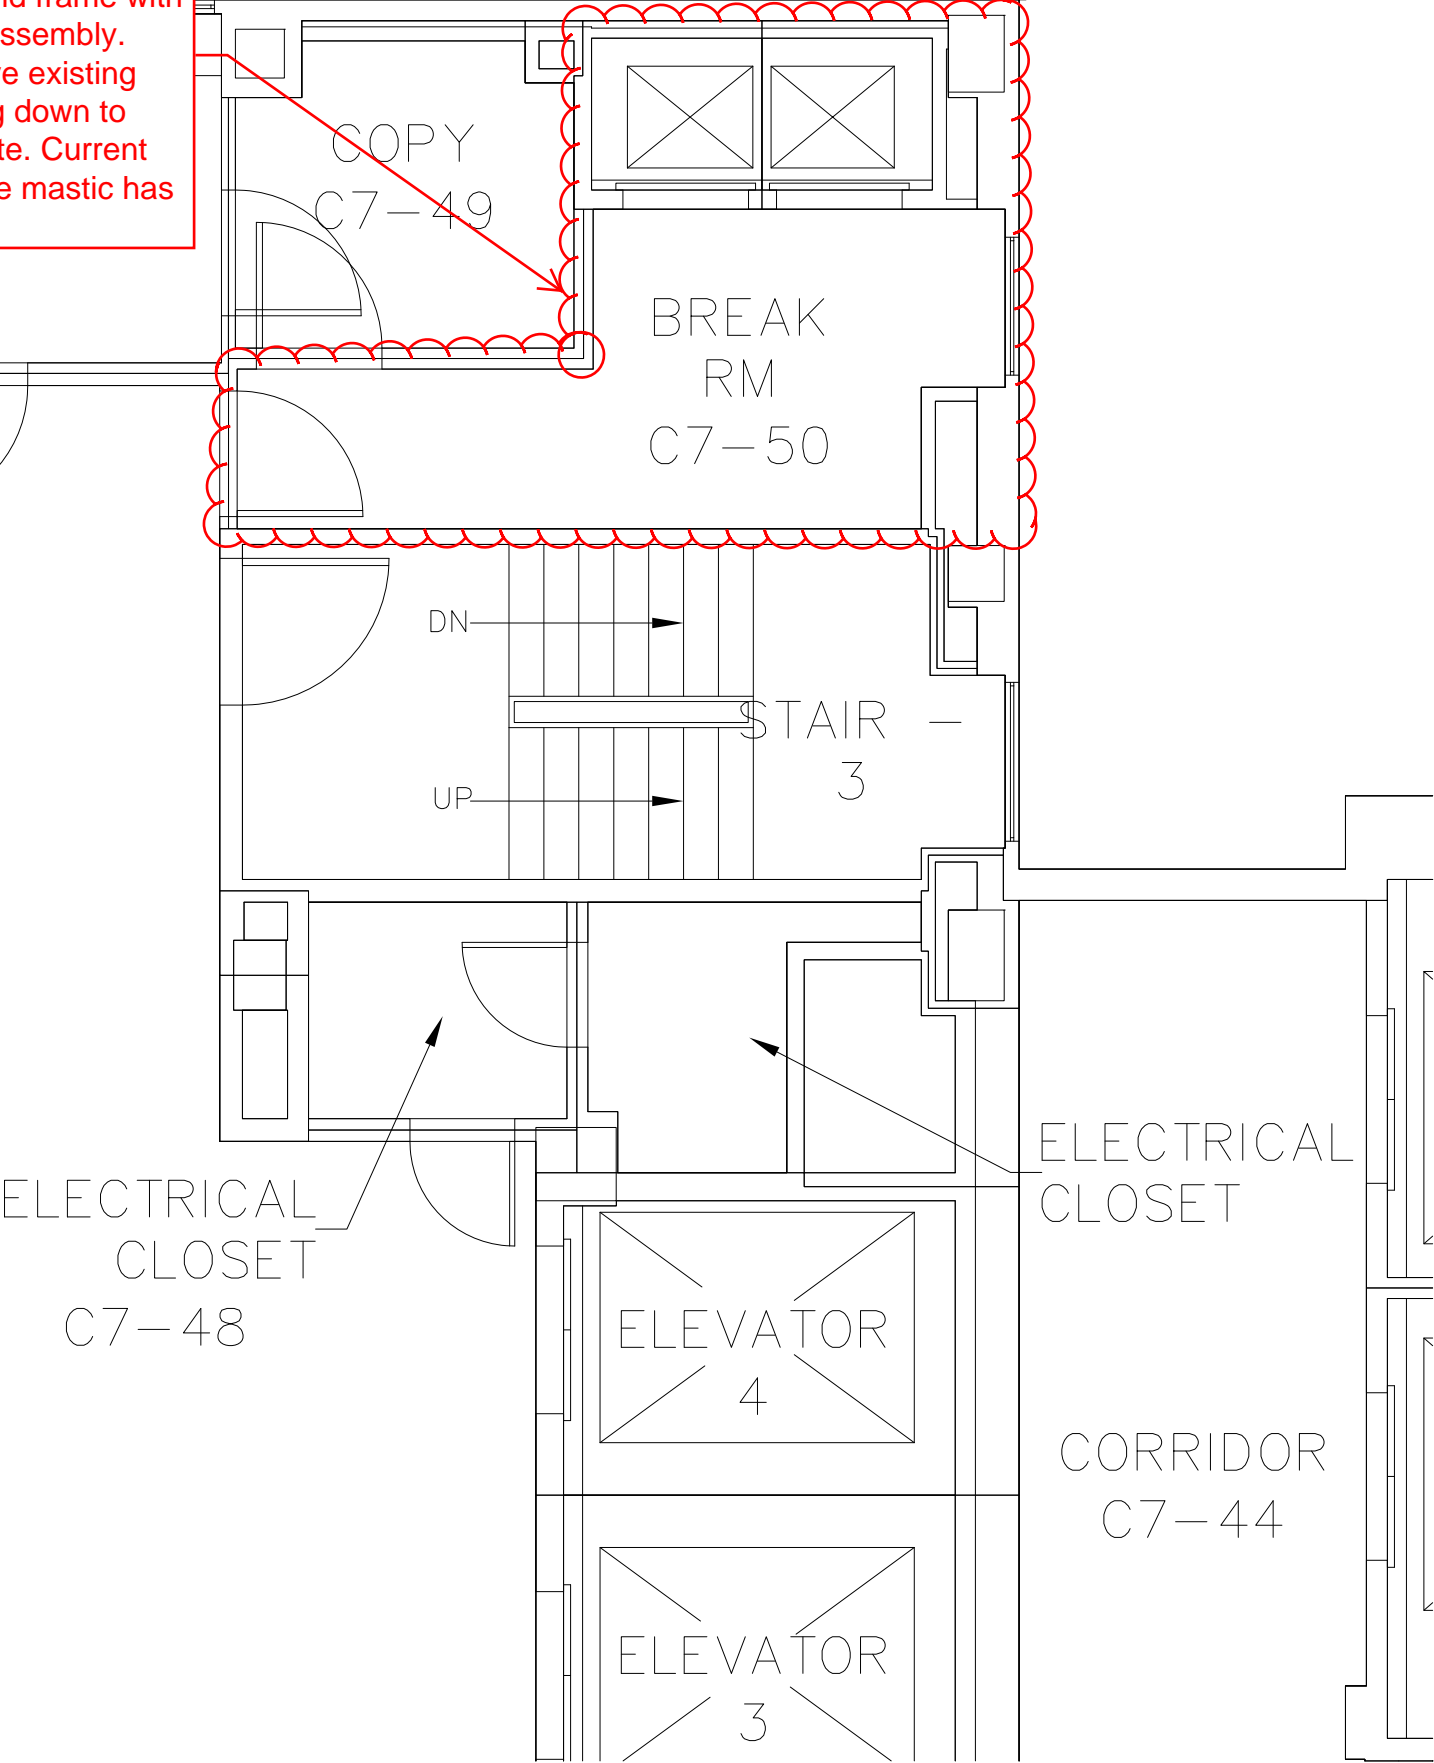

New 2-hour rated
mechanical room.
Replace existing
door and frame
with rated
assembly. Remove
existing flooring
down to concrete.

