



GENERAL NEW WORK NOTES


1. ALL DIMENSIONS ARE NOMINAL UNLESS NOTED OTHERWISE.
2. ALL METAL TO BE SHOP PRIMED AND PAINTED. FIELD PRIME AND TOUCH UP PAINT AS REQUIRED DURING CONSTRUCTION.
3. SEE CIVIL PLANS FOR START AND FINISH LOCATIONS OF FENCE TYPES.

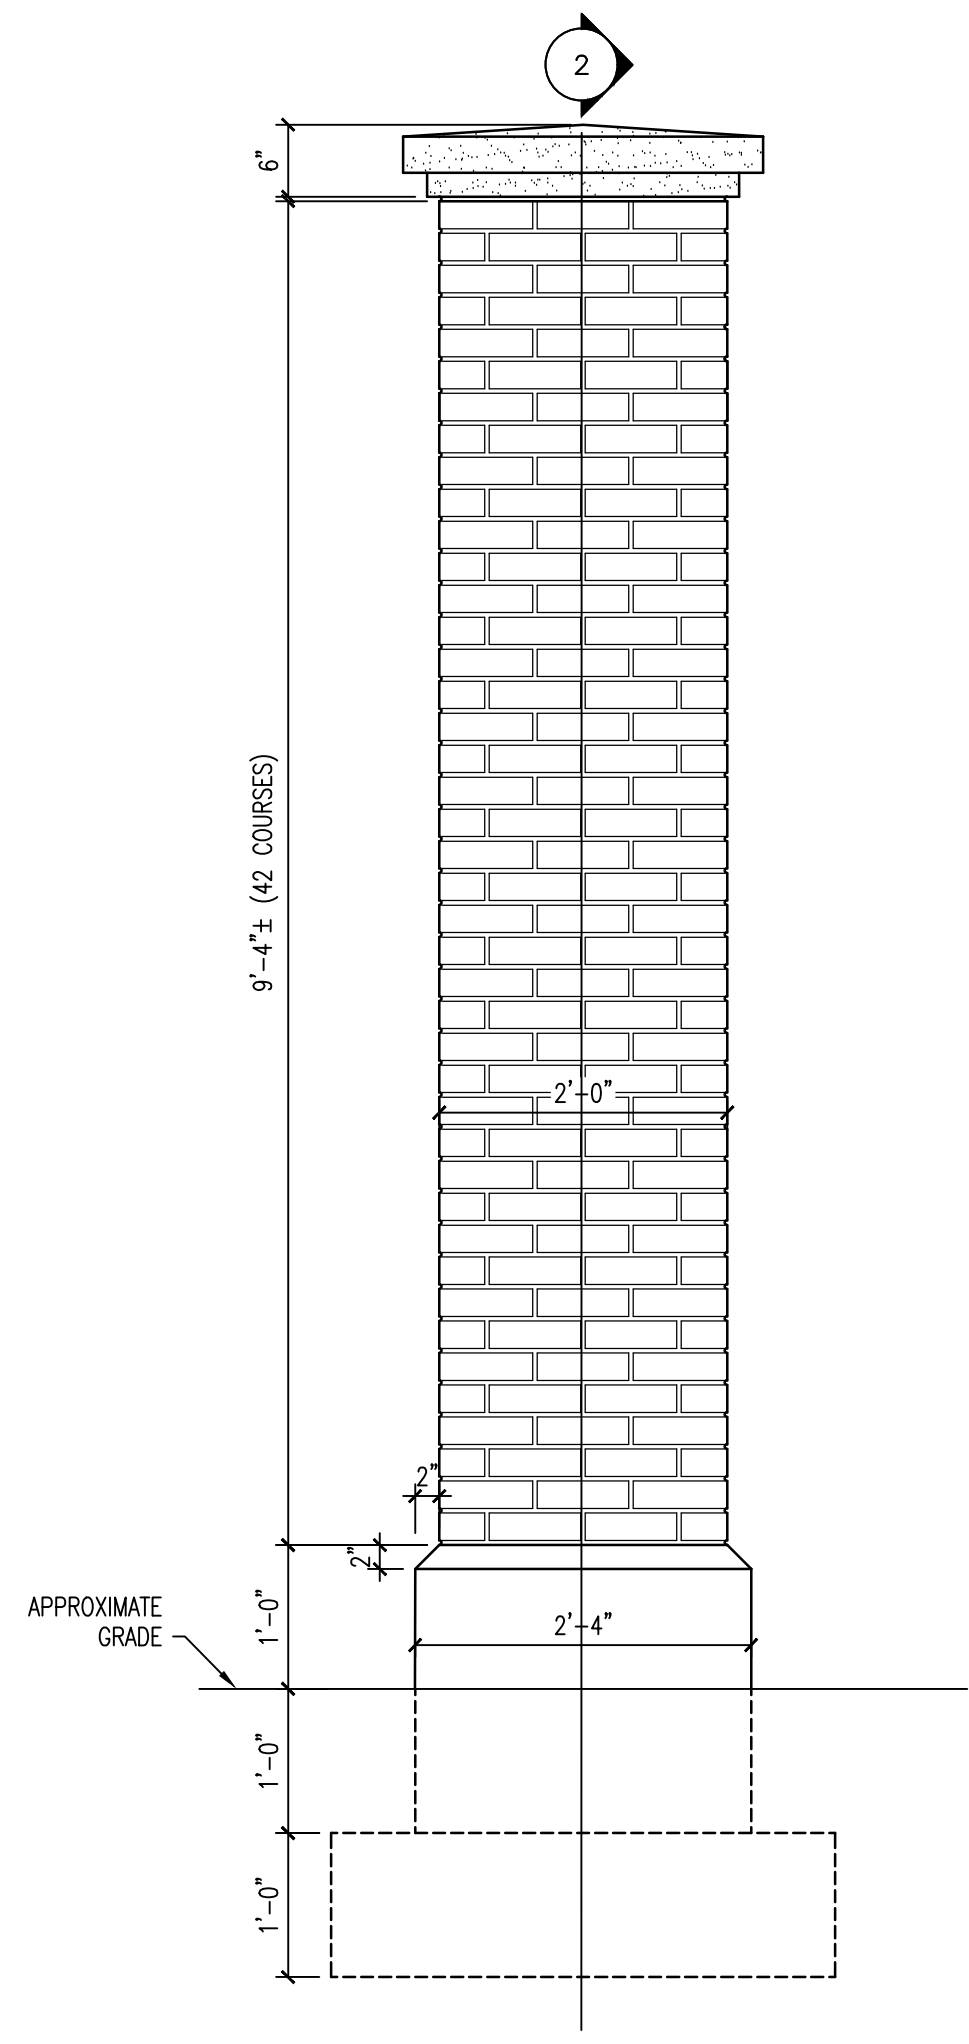


1 COLUMN ELEVATION
SCALE: 3/4" = 1'-0"

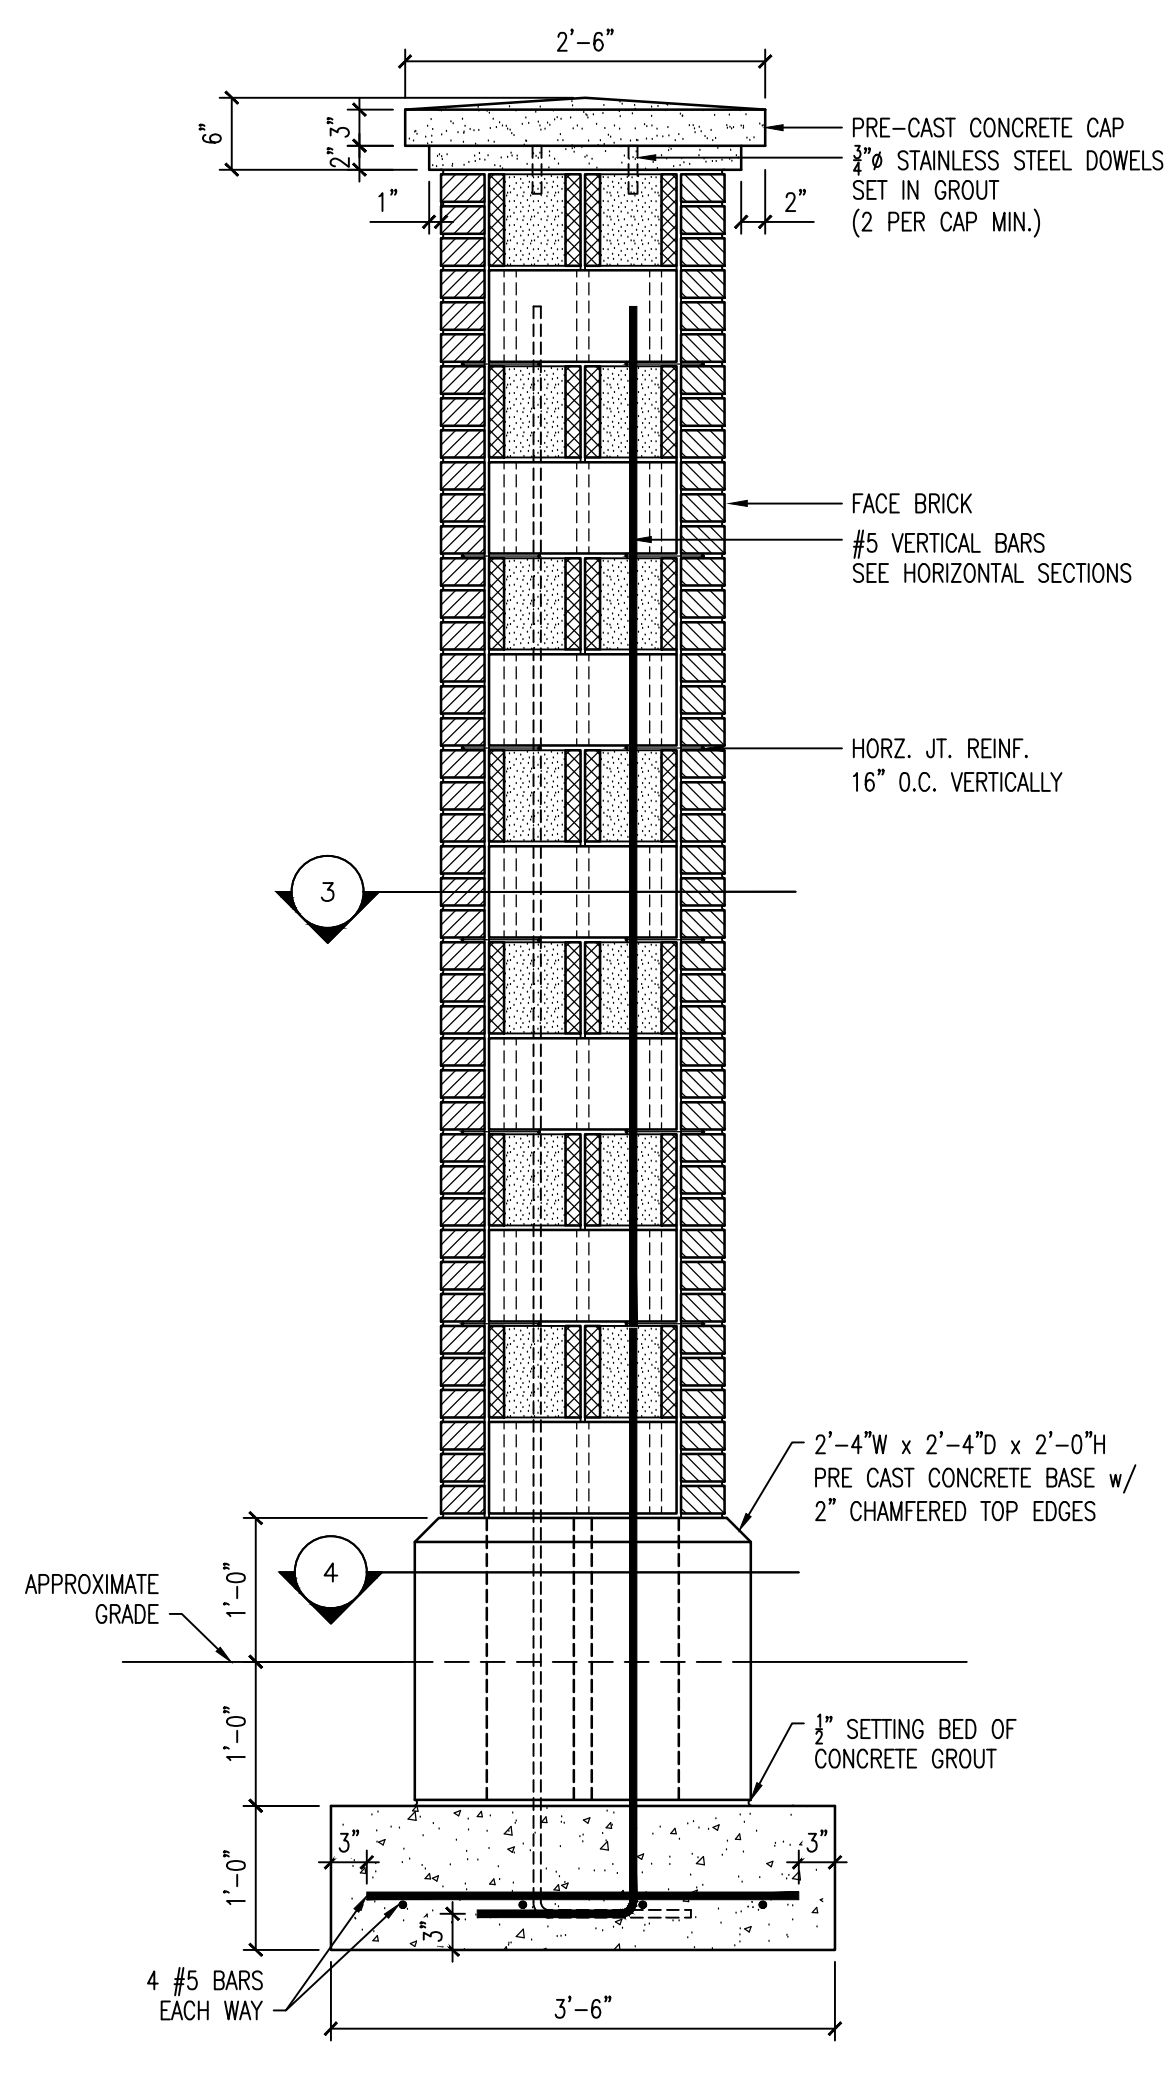


2 COLUMN SECTION - VERTICAL
SCALE: 3/4" = 1'-0"

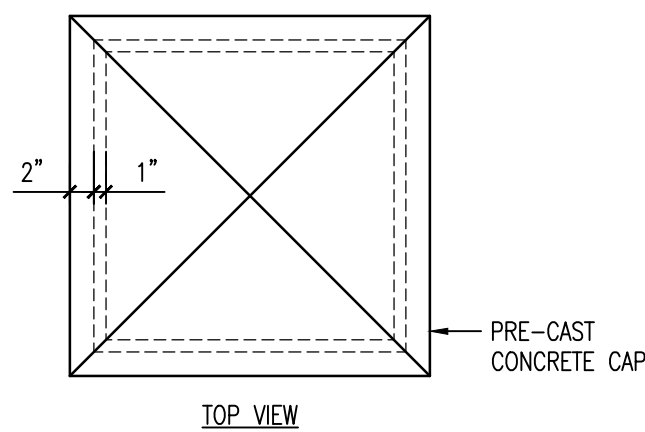


3 COLUMN SECTION - HORIZONTAL
SCALE: 3/4" = 1'-0"

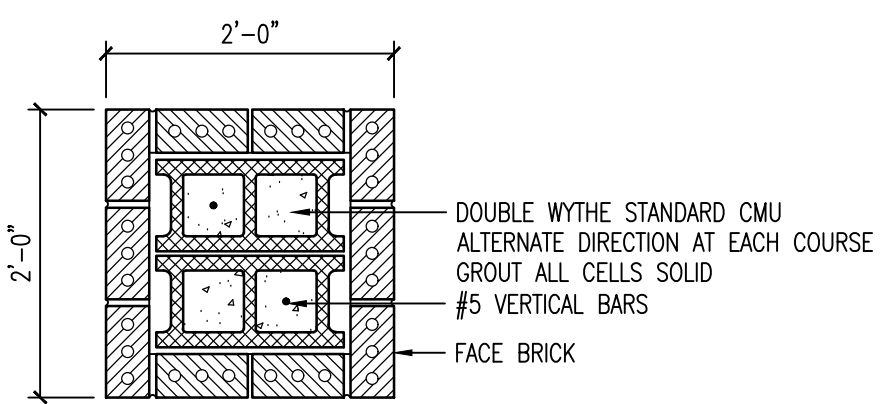


4 COLUMN SECTION - HORIZONTAL
SCALE: 3/4" = 1'-0"

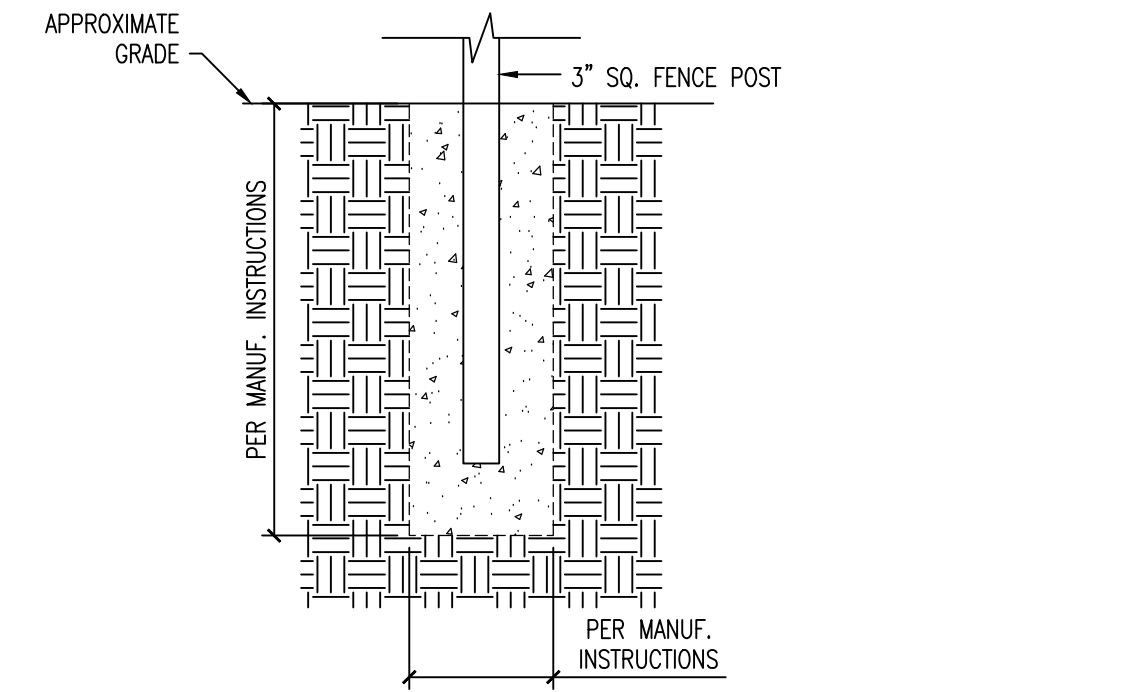


5 FENCE POST FOOTER SECTION
SCALE: 3/4" = 1'-0"

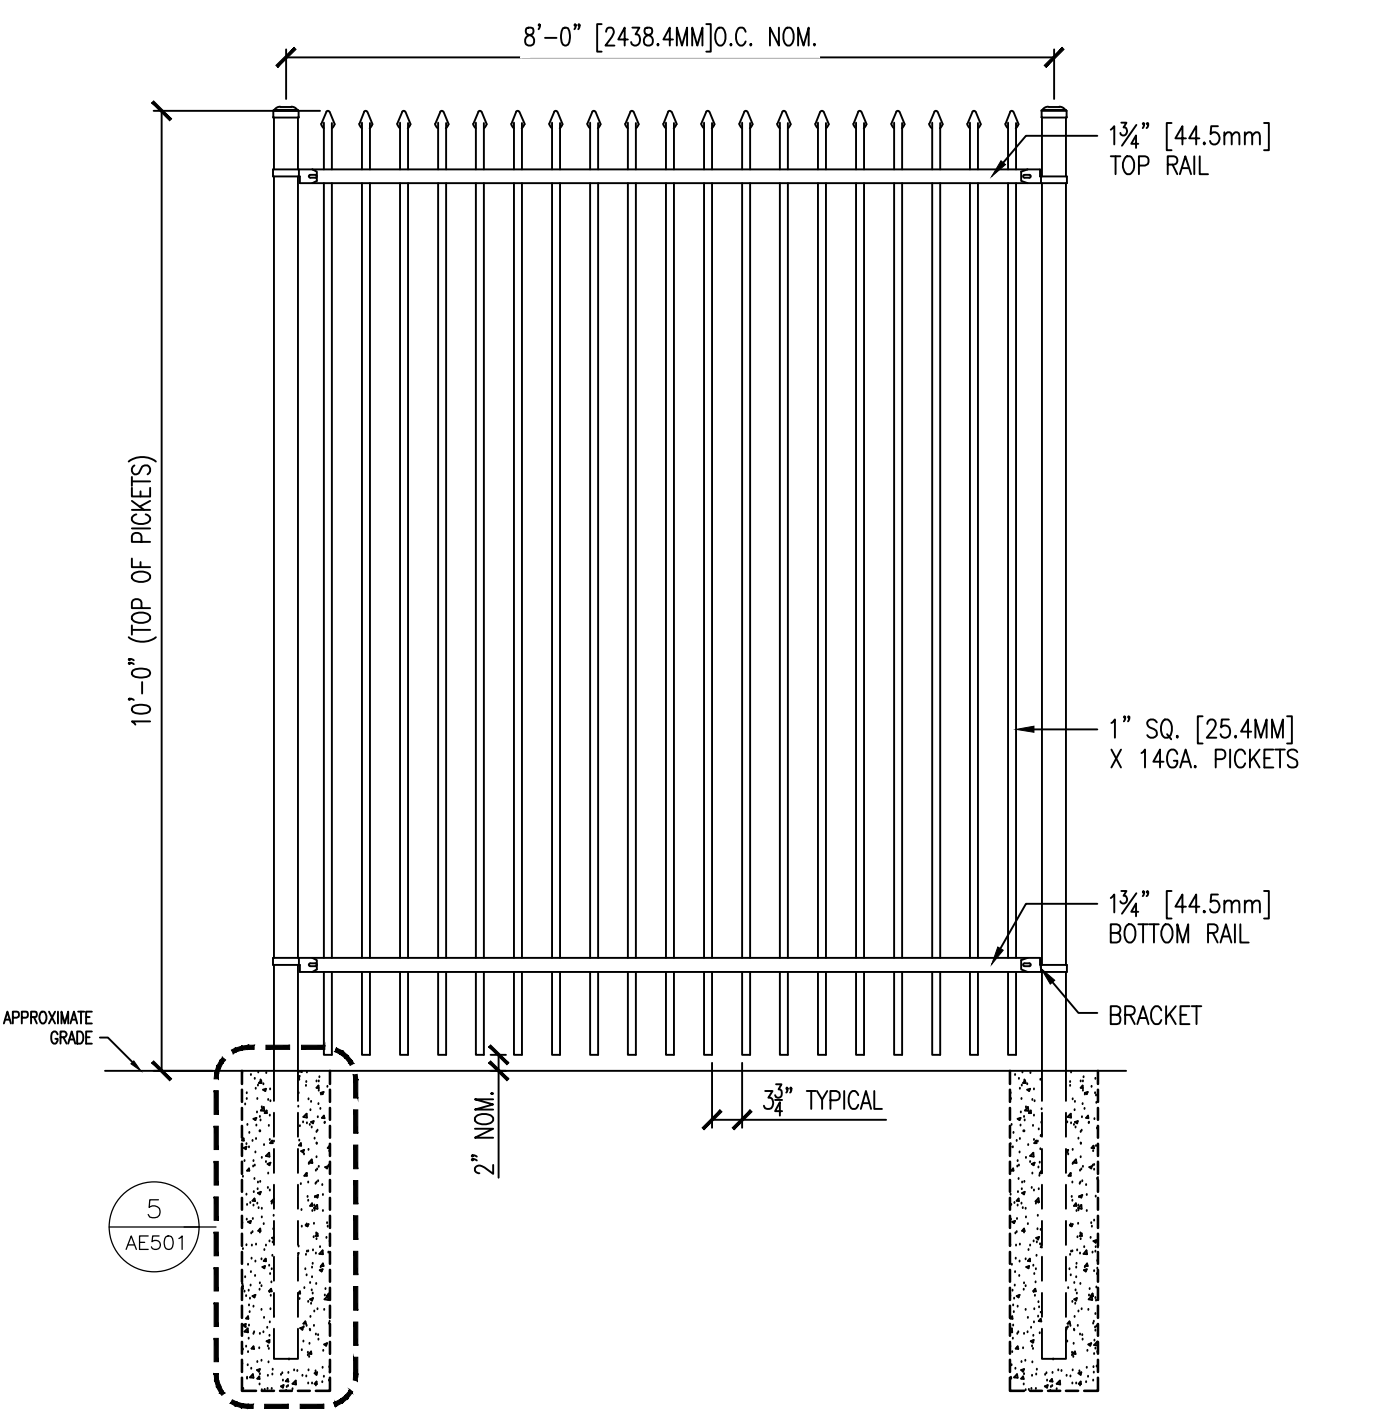

7 PRIMARY FENCE SECTION
SCALE: 1/2" = 1'-0"

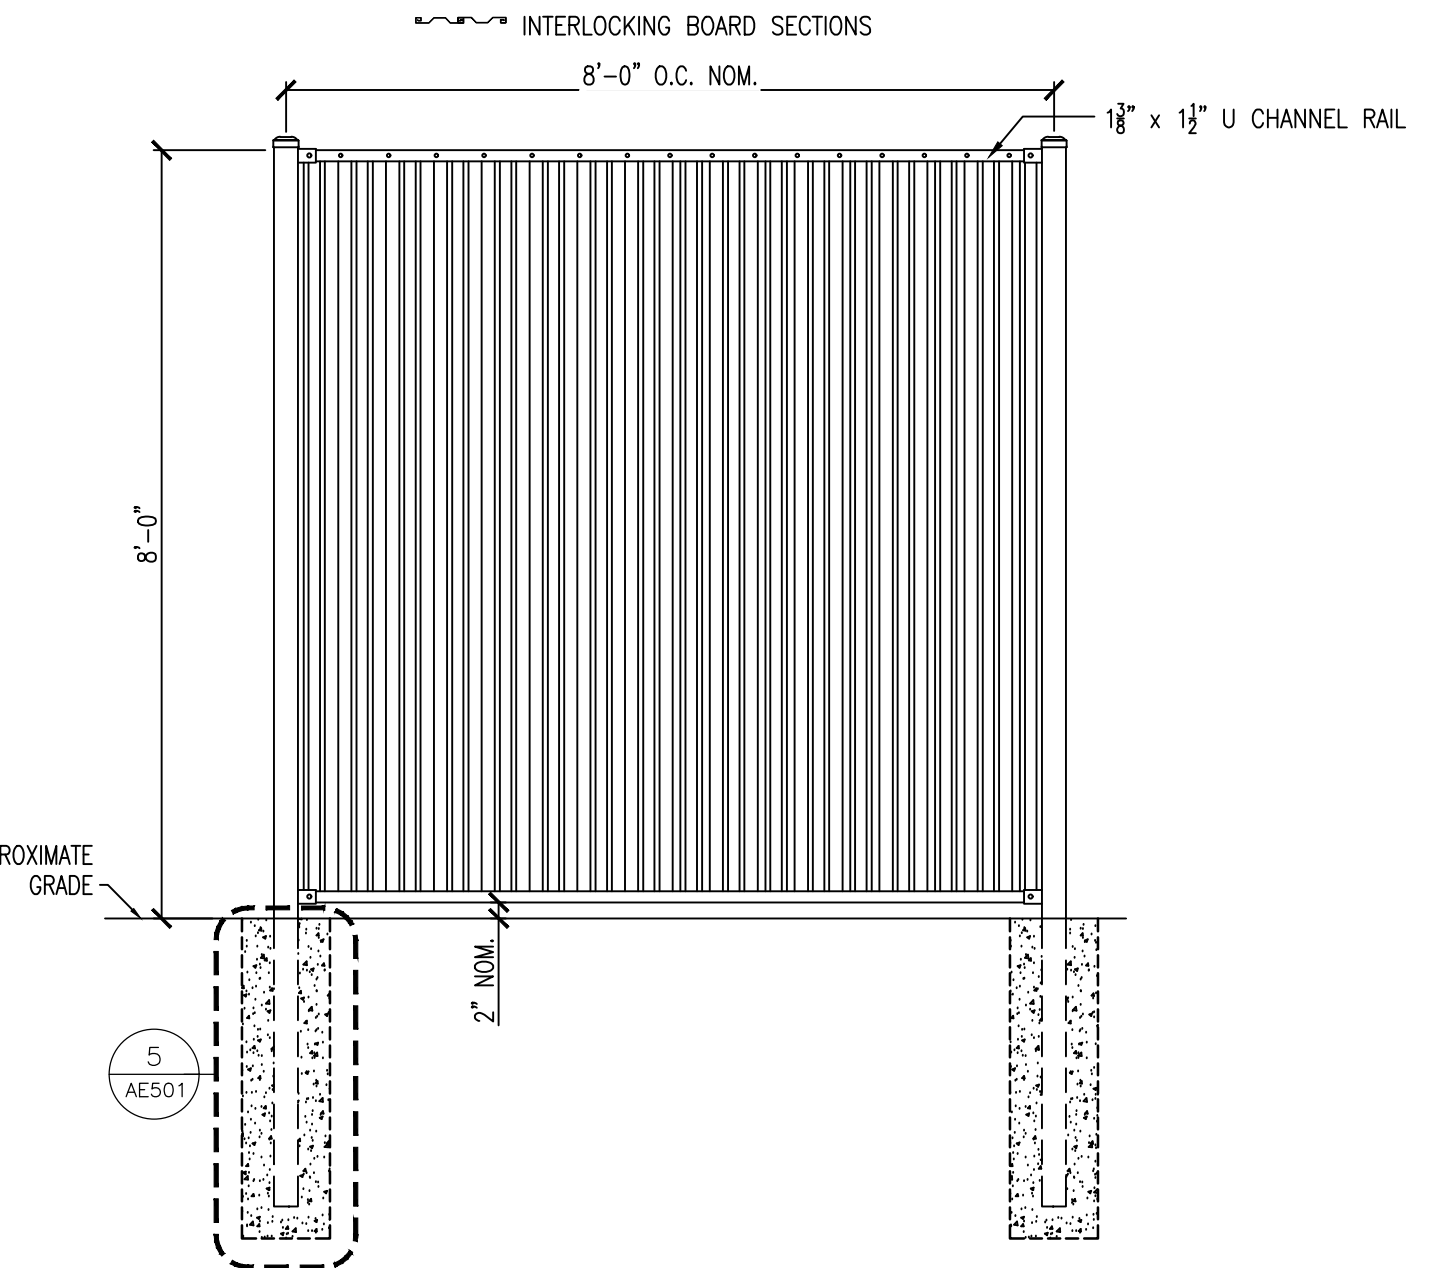

8 PRIVACY FENCE SECTION (BID ALTERNATE #2)
SCALE: 1/2" = 1'-0"

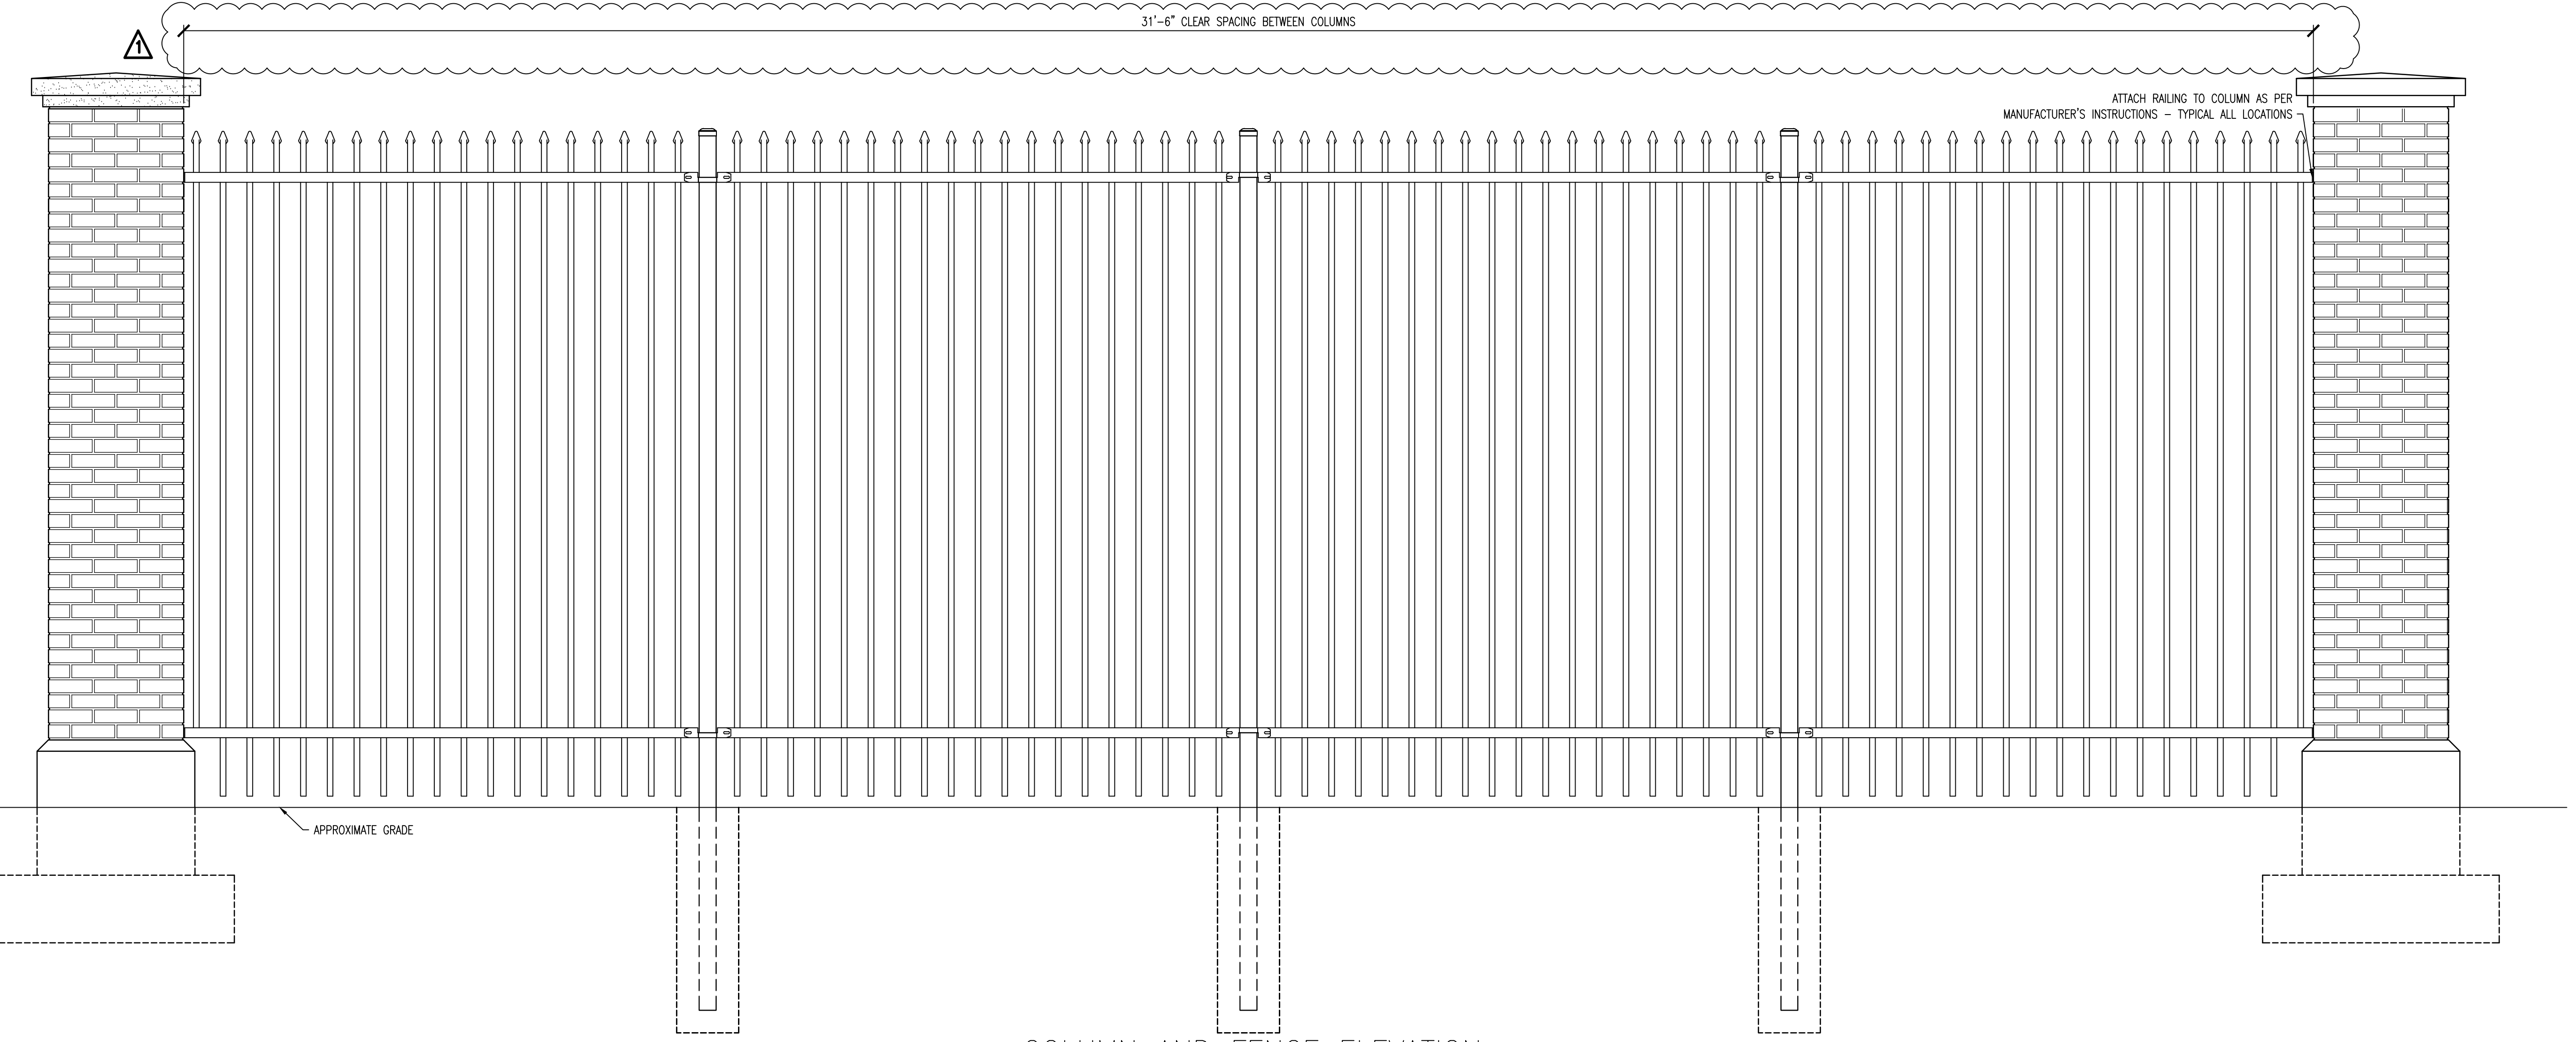


6 COLUMN AND FENCE ELEVATION
SCALE: 3/4" = 1'-0"

three inches = one foot
one and one half inches = one foot
one inch = one foot
three quarters inch = one foot
one half inch = one foot
three eighths inch = one foot
one quarter inch = one foot
one eighth inch = one foot

REV 1 - PREBID RFI	9-19-18
-	-
-	-
-	-
-	-
-	-
-	-
-	-
-	-
Revisions	Date

CONSULTANTS:

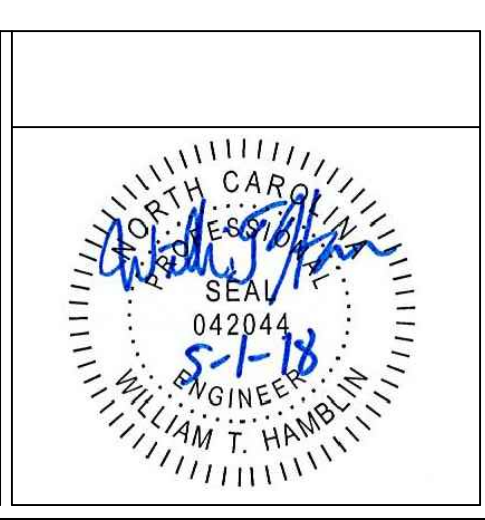

ARCHITECT/ENGINEERS:

Atriax
- GROUP

Atriax, pllc
102 3rd Avenue, NE
PO Box 1629, Hickory, NC 28603
Phone: 828.315.9962
Fax: 828.315.9964

www.atriaxgroup.com
NC Engineering License No.: P-0214
NC Architectural License No.: 51254

Drawing Title
COLUMN AND ELEVATIONS

Approved Project Director

Project Title
PROJECT # 544-16-113
A/E DESIGN - CONSTRUCT
PERIMETER FENCE

Location
COLUMBIA VAMC, COLUMBIA, SC

Date
5/1/2018

Checked
WTH

Drawn
TLR

Project Number
544-16-113

Building Number
-


Drawing Number
AE501

Dwg. 21 of 21


Office of Construction and Facilities Management

Department of Veterans Affairs


three inches = one foot
 one and one half inches = one foot
 one inch = one foot
 three quarters inch = one foot
 one half inch = one foot
 three eighths inch = one foot
 one quarter inch = one foot
 one eighth inch = one foot

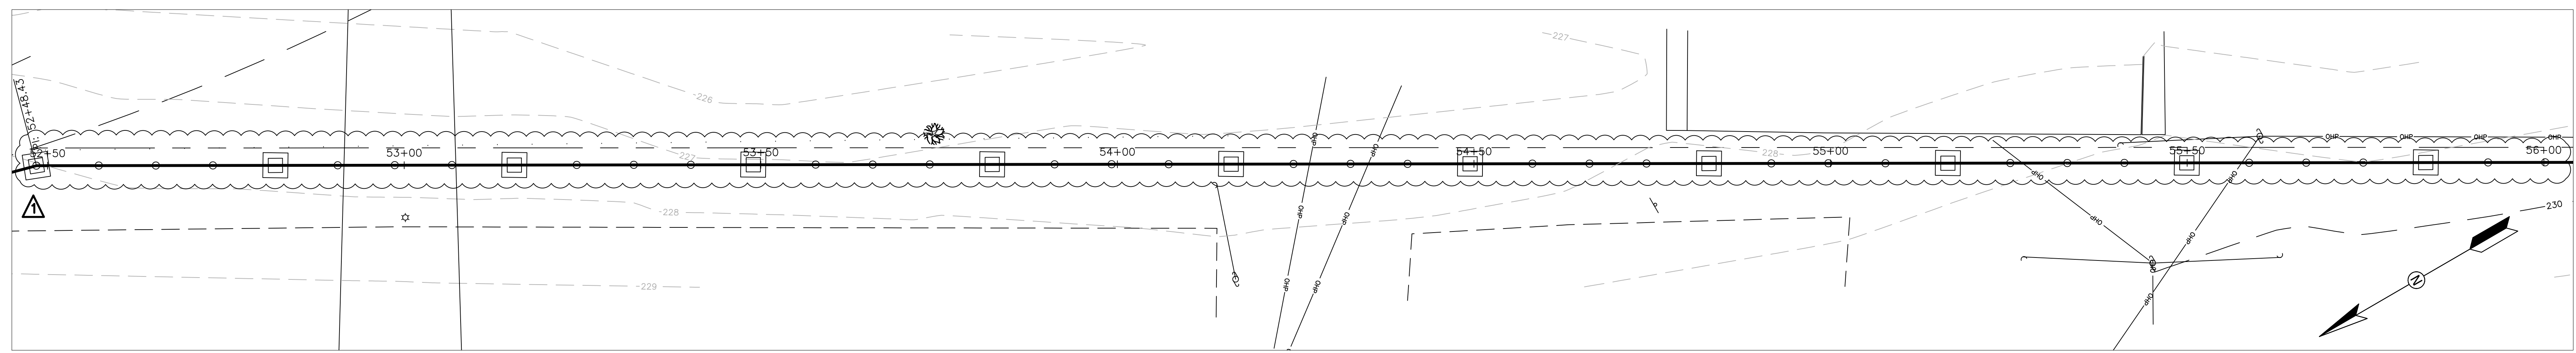


1 PLAN OF FENCE (STATION 52+50 - 56+00)
 SCALE: H1" = 10' V1" = 10'

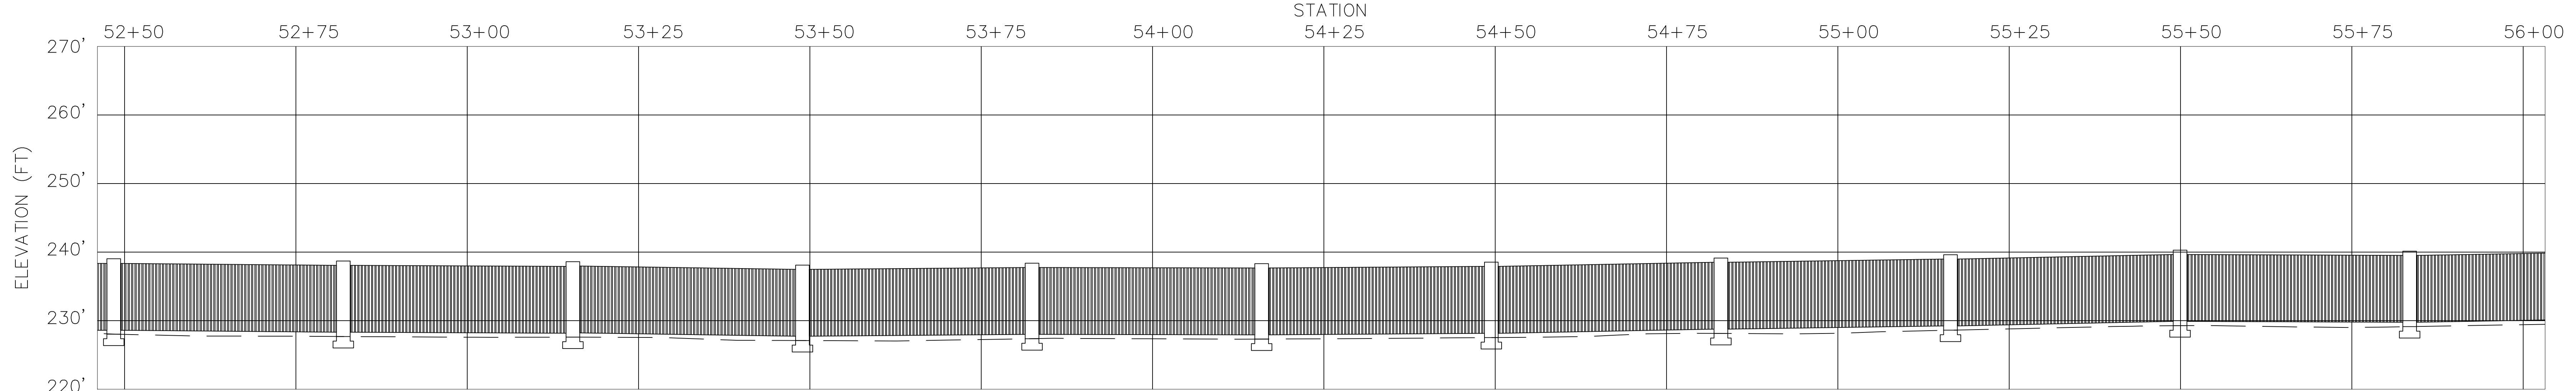


2 PROFILE OF FENCE (STATION 52+50 - 56+00)
 SCALE: H1" = 10' V1" = 10'

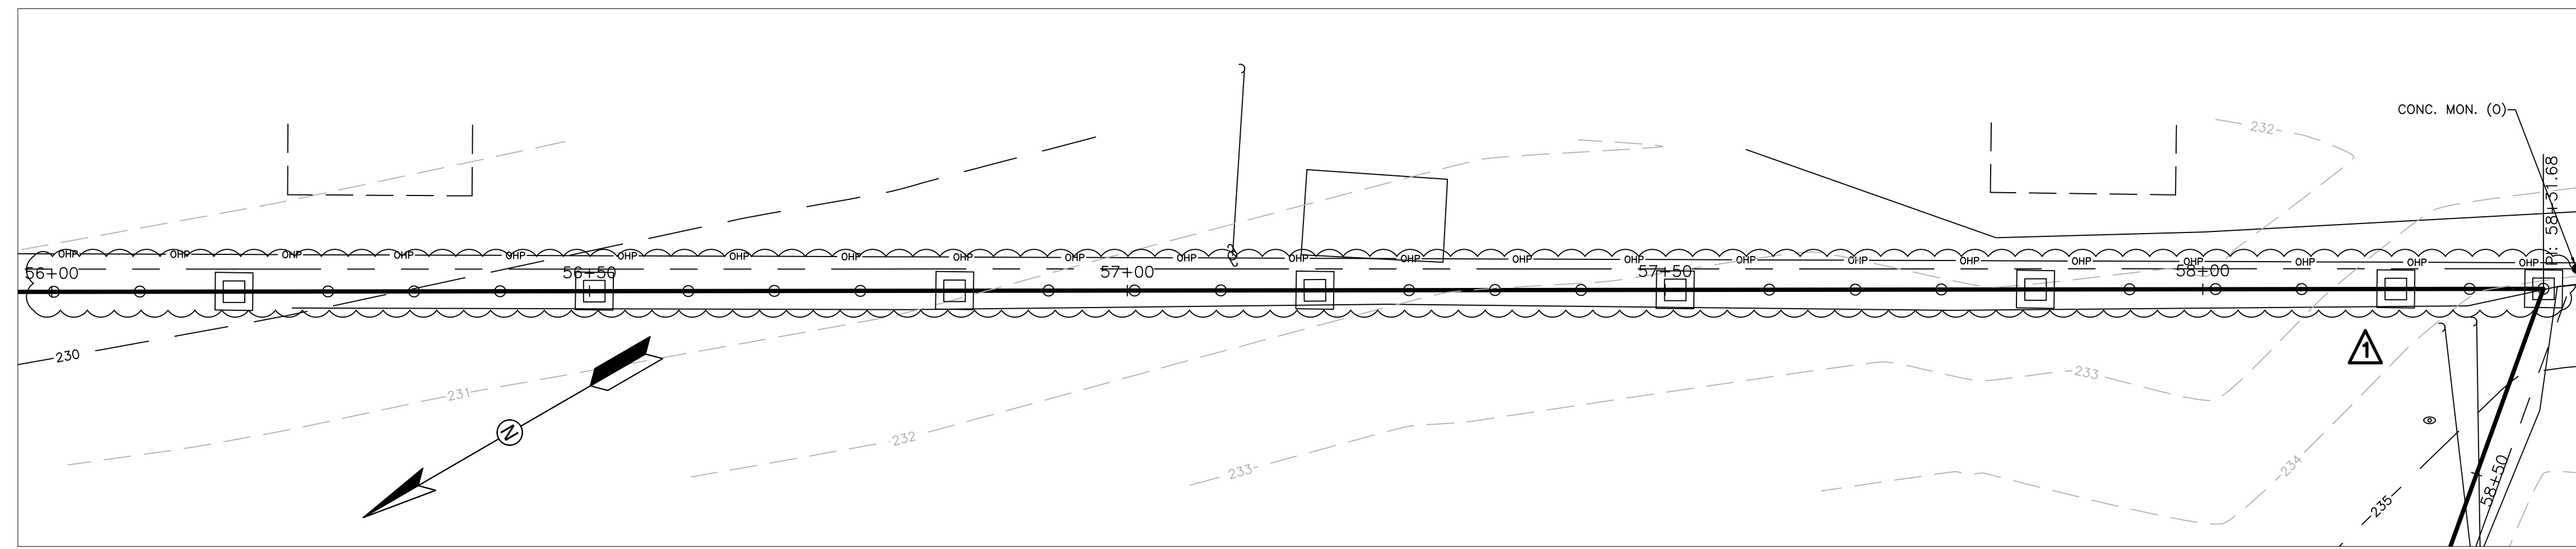

3 PLAN OF FENCE (STATION 56+00 - 58+31)
 SCALE: H1" = 10' V1" = 10'

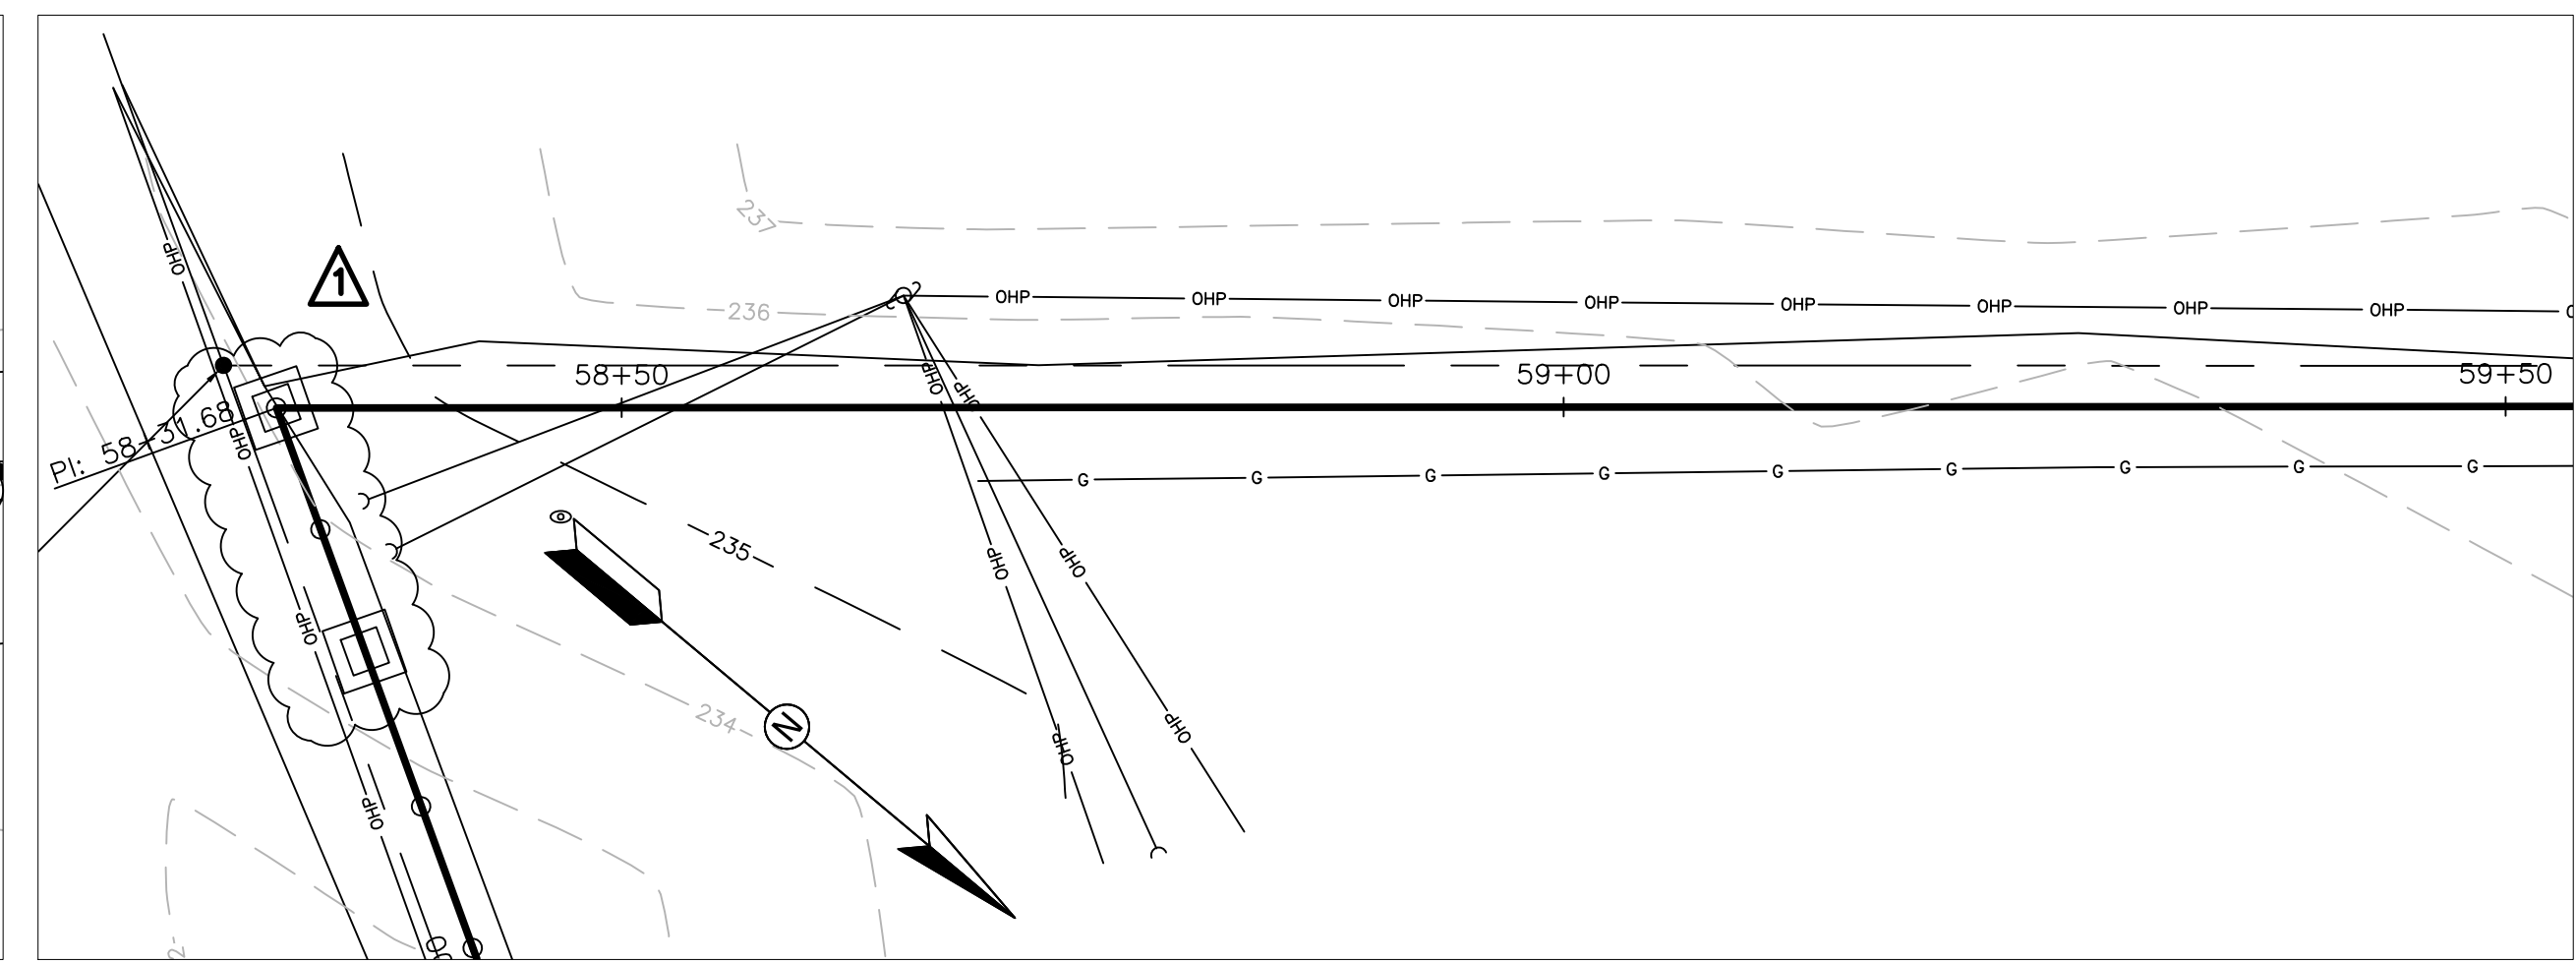


4 PLAN OF FENCE (STATION 58+31 - 59+50)
 SCALE: H1" = 10' V1" = 10'

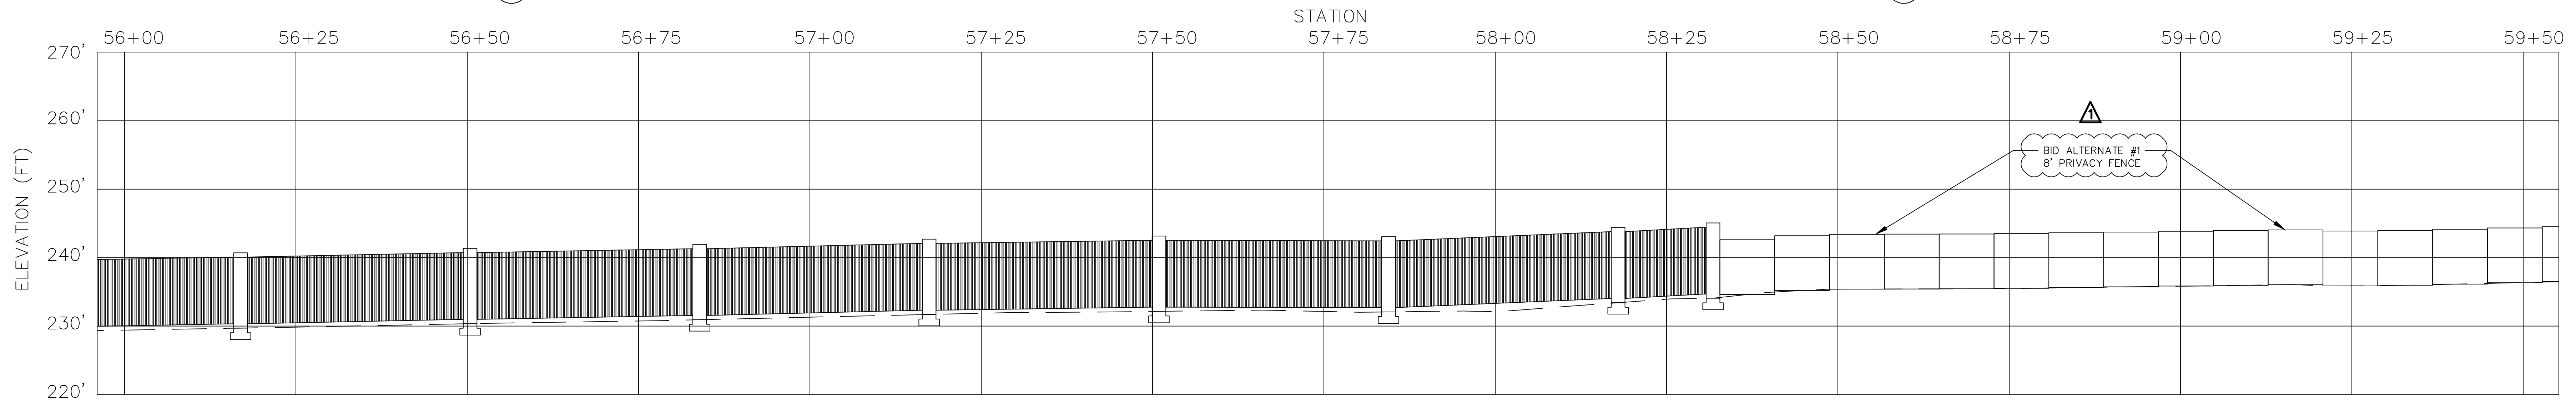

5 PROFILE OF FENCE (STATION 56+00 - 59+50)
 SCALE: H1" = 10' V1" = 10'

REV	DESCRIPTION	DATE
1	PRELIMINARY	9-19-18
2		
3		
4		
5		
6		
7		
8		
9		
10		

CONSULTANTS:

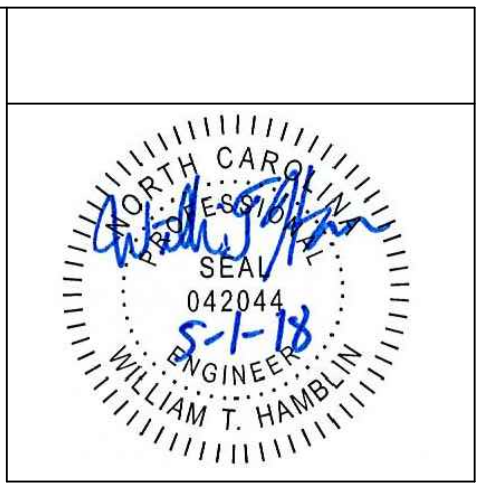

ARCHITECT/ENGINEERS:
Atriax GROUP
 Atriax, PLLC
 102 3rd Avenue, NE
 PO Box 1629, Hickory, NC 28603
 Phone: 828.315.9962
 Fax: 828.315.9964
 www.atriaxgroup.com
 NC Engineering License No.: P-0214
 NC Architectural License No.: 51254

Drawing Title
FENCE PLAN AND PROFILE
 STA 52+50 - 59+50
 Approved Project Director

Project Title
PROJECT # 544-16-113
 A/E DESIGN - CONSTRUCT
 PERIMETER FENCE
 Location
COLUMBIA VAMC, COLUMBIA, SC
 Date
5/1/2018
 Checked
 WTH
 Drawn
 WTH
 Project Number
544-16-113
 Building Number
 -
 Drawing Number
CS-209
 Dwg. 12 of 21

Office of
 Construction
 and Facilities
 Management
 Department of
 Veterans Affairs

