




10 01-01-TR1 ENLARGED
 3/4" = 1'-0"

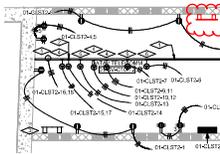


11 01-01-TR2 ENLARGED
 3/4" = 1'-0"

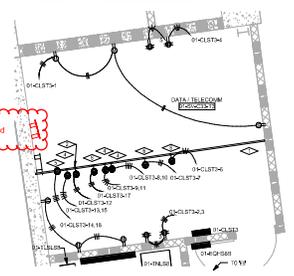


12 01-01-TR3 ENLARGED
 3/4" = 1'-0"

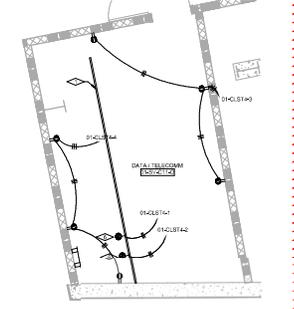


13 01-01-TR4 ENLARGED
 3/4" = 1'-0"

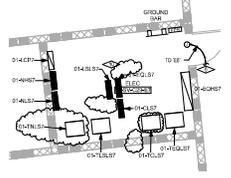


7 01-01-E7 ENLARGED ELECTRICAL ROOM
 3/4" = 1'-0"

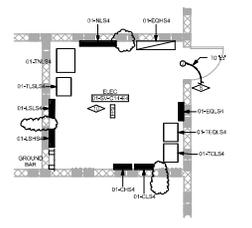


4 01-01-E4 ENLARGED ELECTRICAL ROOM
 3/4" = 1'-0"

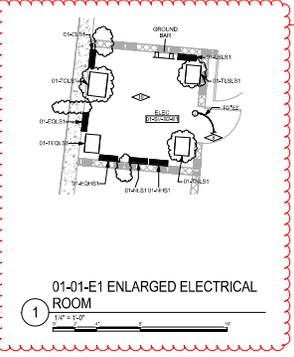


1 01-01-E1 ENLARGED ELECTRICAL ROOM
 3/4" = 1'-0"

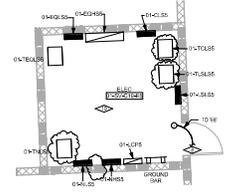


5 01-01-E5 ENLARGED ELECTRICAL ROOM
 3/4" = 1'-0"

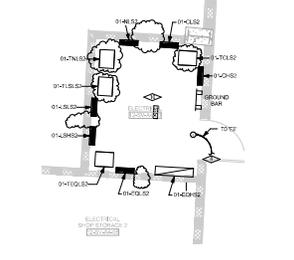


2 01-01-E2 ENLARGED ELECTRICAL ROOM
 3/4" = 1'-0"

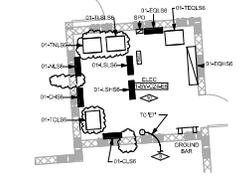


6 01-01-E6 ENLARGED ELECTRICAL ROOM
 3/4" = 1'-0"

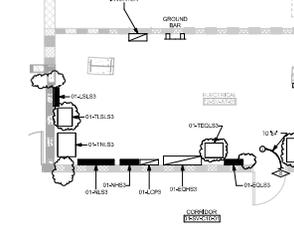

3 01-01-E3 ENLARGED ELECTRICAL ROOM
 3/4" = 1'-0"

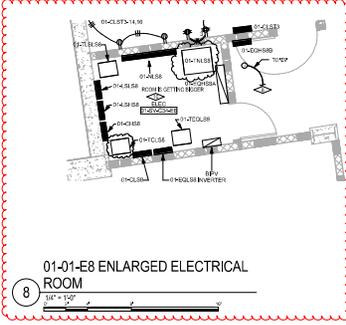

8 01-01-E8 ENLARGED ELECTRICAL ROOM
 3/4" = 1'-0"

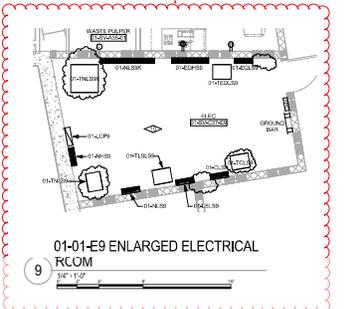

9 01-01-E9 ENLARGED ELECTRICAL ROOM
 3/4" = 1'-0"

- FLAG NOTES:** (NOT ALL FLAG NOTES USED ON THIS SHEET)
- PROVIDE UNISTRUT RACK ABOVE CABLE TRAY (LOWER TIER). COORDINATE EXACT LOCATION OF UNISTRUT WITH TELECOM DETAILS.
 - PROVIDE 15-30V TUNSTACK RECEPTACLE MOUNTED TO UNISTRUT RACK ABOVE CABLE TRAY. PROVIDE 2R10, 1R10G, 3/4" CONDUIT TO PANEL.
 - REFER TO TELECOM DRAWINGS FOR EXACT MOUNTING HEIGHT OF GROUND BAR.
 - PROVIDE 200V, 1-PHASE, 50A HARDWIRED CONNECTION FOR UPS. SWITCH BOX TO BE MOUNTED TO UNISTRUT RACK. PROVIDE 3R1, 1R10G, 3/4" CONDUIT TO PANEL.
 - PROVIDE 15-30V TUNSTACK RECEPTACLE MOUNTED TO UNISTRUT RACK ABOVE CABLE TRAY. PROVIDE 2R12, 1R12G, 3/4" CONDUIT TO PANEL.
 - PROVIDE 2" CONDUIT TO FIRE ALARM CONTROL PANEL IN E3 ELECTRICAL ROOM FOR FIRE ALARM SYSTEM FIBER OPTIC CABLEING.
 - PROVIDE 2" CONDUIT TO ELECTRICAL ROOM INDICATED FOR IDEAL METERING INTERFACE. PROVIDE CONNECTION TO SPACE METER IN INDICATED ELECTRICAL ROOM.
 - PROVIDE 120V POWER FOR DIGITAL METERING INTERFACE.
 - PROVIDE UNISTRUT RACK AS SHOWN FOR SPARE WIRE SPACE.
- See KT RFI 2439/VA RFI 2241 Clarifies electrical equipment locations.
- See attachment to RFI 6842 for modifications to circuits in electrical room.

RFI 10232:
 Install a quad outlet with 120V circuit run from panel 01-CL5T2, and install a secondary ground bar for Cellular DAS

Please review KT RFI #20297 VA RFI #2685 for revised detail of Elec 01-01-E3-EN


RFI 10232:
 Install secondary ground bar for Cellular DAS

Please review RFI RFI #2432 / VA RFI #2618 for more information about the LCP panel lighting requirements and panel coverage.

Please review RFI RFI #2432 / VA RFI #2618 for more information about the location of the LCP panel.

RFI 10232:
 Install 120V receptacles for 120V and 240V receptacles to 4163. Please refer to RFI 10232 attachment for detailed location of receptacles.

In the RFI detail the following electrical equipment was to be added:
 1. 120V receptacle (240V receptacle removed) in 01-01-E3
 2. 120V SP receptacle in room 01-01-CL5-E2
 3. 120V receptacle in room 01-01-CL5-E2
 4. 120V receptacle in room 01-01-CL5-E2
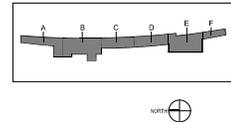

CONSULTANTS: [Blank space for consultant names]		ARCHITECT/ENGINEERS: H+L SOM CRA SAM ARCHITECTS / ENGINEERS 1144 Ardmore 1700 Mile Street Suite 100 Denver, CO 80202		Project Title CONCOURSE ENLARGED SERVICE LEVEL POWER PLANS Approved: Project Director		Project Title REPLACEMENT MEDICAL CENTER FACILITY, EASTERN COLORADO HEALTH CARE SYSTEM LOCATION AURORA, COLORADO Date 08/31/2012		Project Number 554-501 Building Number [Blank]		Drawing Number 01.ES.410.1		OFFICE OF CONSTRUCTION AND FACILITIES MANAGEMENT Department of Veterans Affairs	
---	--	--	--	--	--	---	--	--	--	--------------------------------------	--	--	--

