


**NOTES:**

- TOP OF FINISHED FLOOR ELEVATION EQUALS 26'-1 1/4", UNO. TOP OF SLAB AT PROMENADE IS (-0'-7").
- THE SLAB-ON-GRADE SHALL BE 4" THICK CONCRETE REINFORCED WITH 6x6-W2.9xW2.9 WWR PLACED ON A 4" LAYER OF SAND OVER A VAPOR BARRIER AND 4" DRAINAGE FILL.
- WHERE NOTED THE SLAB-ON-GRADE SHALL BE 5" THICK CONCRETE REINFORCED WITH 6x6-W2.9xW2.9 WWR PLACED ON A 4" LAYER OF SAND OVER A VAPOR BARRIER AND 4" DRAINAGE FILL.
- WHERE NOTED THE SLAB-ON-GRADE SHALL BE 8" THICK CONCRETE REINFORCED WITH #4@12 EW PLACED ON A 4" LAYER OF SAND OVER A VAPOR BARRIER AND 4" DRAINAGE FILL.
- UPPER LEVEL FRAMED FLOOR CONSTRUCTION IS 3/4" LIGHT WEIGHT CONCRETE SLAB REINFORCED WITH 6x6-W2.9xW2.9 WWR OVER 2" DEEP, 20 GAGE GALVANIZED COMPOSITE STEEL DECK, (5/4" TOTAL THICKNESS)
- TOP OF STEEL ELEVATION EQUALS (1'-0 1/2") UNLESS NOTED THUS: (-X") FROM FINISHED FLOOR.
- FOR SIZE AND LOCATIONS OF SLAB OPENINGS, CURBS, DEPRESSIONS, SLOPES, FLOOR DRAINS, ETC. NOT SHOWN ON THIS DRAWING, SEE ARCHITECTURAL, MECHANICAL, ELECTRICAL & PLUMBING DRAWINGS. SEE TYPICAL FLOOR OPENING DETAIL FOR ADDITIONAL FRAMING AND / OR REINFORCING AT OPENINGS.
- SHOWN THUS ON PLAN:
  - A. (-0'-0") INDICATES TOP OF FOOTING ELEVATION.
  - B. (-0'-0") INDICATES TOP OF CONCRETE WALL / GRADE BEAM ELEVATION.
  - C. (-0'-0") INDICATES TOP OF PIER ELEVATION.
  - D. [100] INDICATES NUMBER OF 3/4" x 4" LONG HEADED SHEAR STUD CONNECTORS.
  - E. "P" INDICATES A HSS5x5x1/4 POST ABOVE, UNO.
  - F. "→" INDICATES DIRECTION OF STEEL DECK SPAN.
  - G. "M" INDICATES FULLY DEVELOPED MOMENT CONNECTION ST THAT END OF MEMBER.
- TOP OF EXTERIOR FOOTINGS SHALL BE (-2'-0"), UNO. TOP OF INTERIOR FOOTINGS SHALL BE (-8"), UNO. TOP OF PIERS SHALL BE [-8"], UNO.
- FOR TYPICAL DETAILS SEE SHEETS S401 THROUGH S405, FOR COLUMN & PIER SCHEDULES SEE SHEET S705.

**FOOTING SCHEDULE (3KSF)**

MARK	LENGTH	WIDTH	THICKNESS	REINFORCEMENT (BOT UNO)	REMARKS
F30	3'-0"	3'-0"	12"	4#5 EW BOT	
F40	4'-0"	4'-0"	12"	4#5 EW BOT	
F46	4'-6"	4'-6"	12"	4#5 EW BOT	
F50	5'-0"	5'-0"	12"	7#4 EW BOT	
F60	6'-0"	6'-0"	14"	7#5 EW BOT	
F66	6'-6"	6'-6"	16"	8#5 EW BOT	
F70T	7'-0"	7'-0"	17"	6#6 EW-B & 6#4 EW-T	
F80	8'-0"	8'-0"	19"	8#7 EW BOT	
F108/99	10'-8"	10'-9"	24"	11#7 EW BOT	
F149/100	14'-9"	10'-0"	34"	13#9 EW BOT	

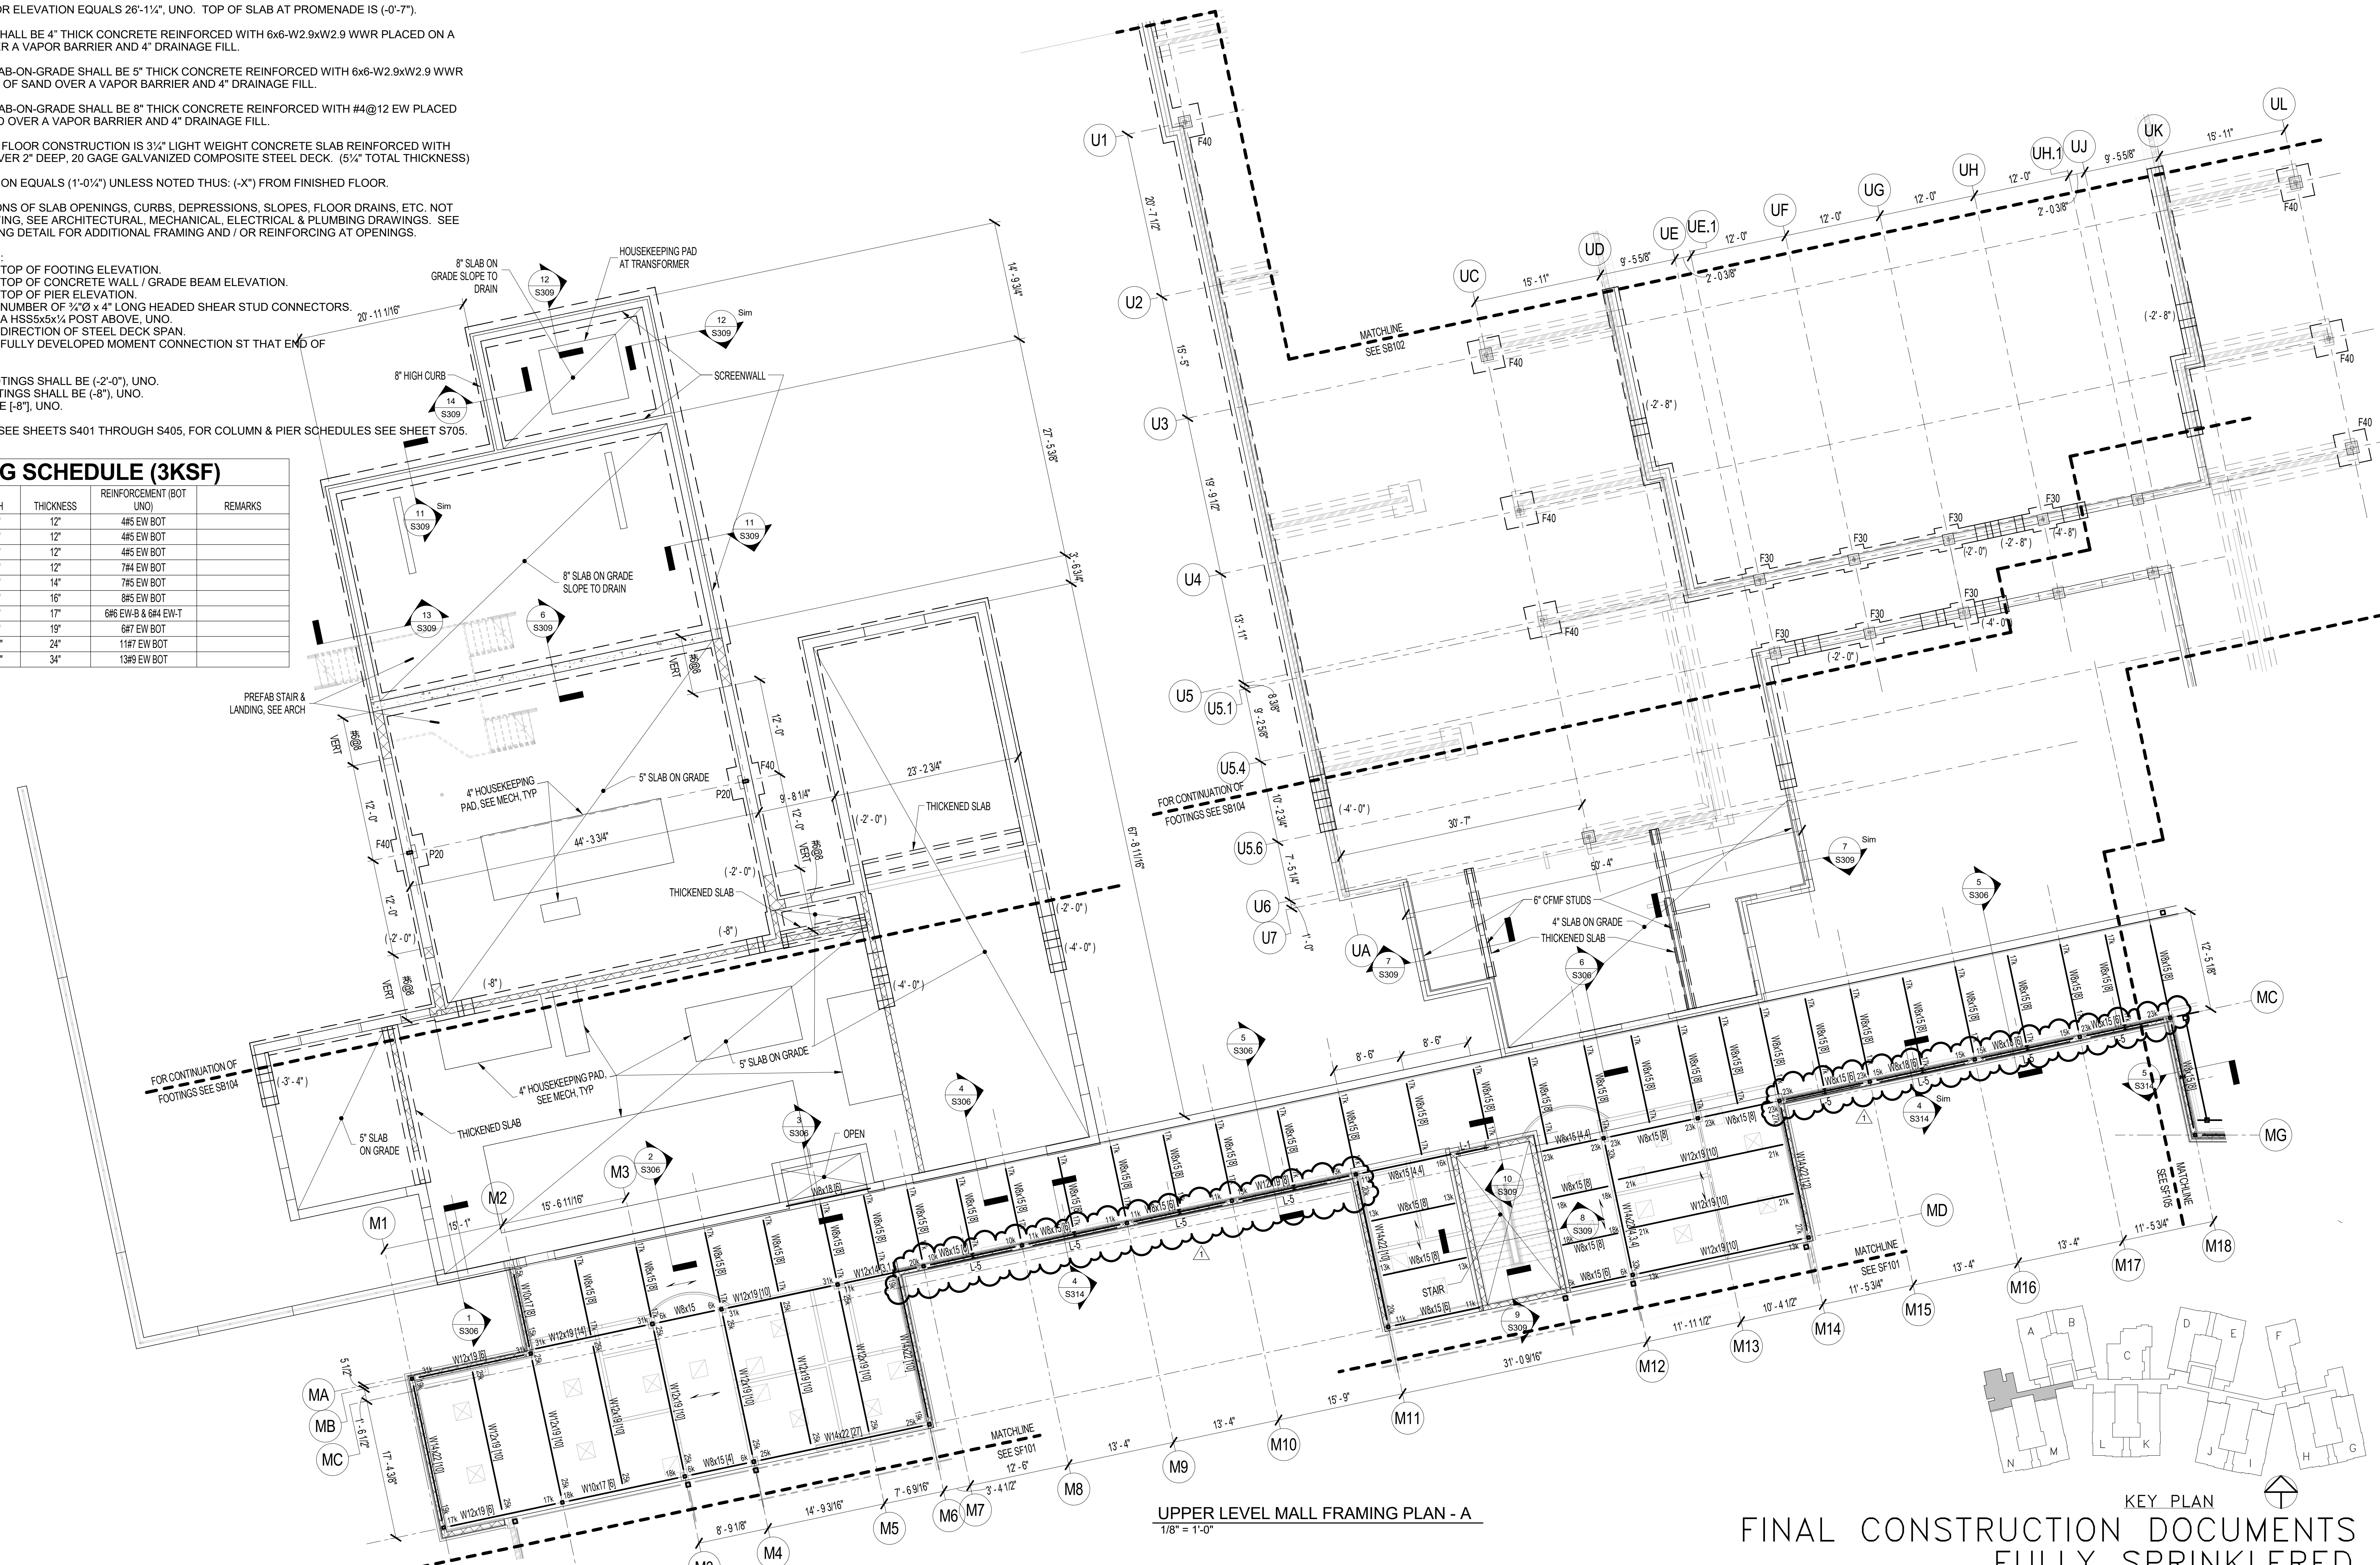

UPPER LEVEL MALL FRAMING PLAN - A  
1/8" = 1'-0"

KEY PLAN  
FINAL CONSTRUCTION DOCUMENTS  
FULLY SPRINKLERED

No.	Revisions	Date
1	ADDENDUM - BID RFI	10/5/18

**CONSULTANTS:**

**BURDETTE KOEHLER MURPHY & ASSOCIATES, INC.**  
MECHANICAL/ELECTRICAL CONSULTING ENGINEERING  
1416 CLARKVIEW ROAD, SUITE 500  
BALTIMORE, MARYLAND 21209  
410.323.0600 - FAX 410.377.2543

**CENTURY ENGINEERING, INC.**  
CIVIL & STRUCTURAL ENGINEERING  
15716 GILROY ROAD  
HUNT VALLEY, MARYLAND 21031  
443.589.2400 - FAX 443.589.2401

**KOFFEL ASSOCIATES, INC.**  
FIRE PROTECTION ENGINEERING  
8815 CENTRE PARK DR., SUITE 200  
COLUMBIA, MARYLAND 21045  
410.760.2246 - FAX 410.760.2888

**ROBERT L. SEYMOUR ASSOCIATES**  
AUTOMATIC TRANSPORT ENGINEERING  
182 THOMAS JOHNSON DR., SUITE 200  
FREDERICK, MARYLAND 21702  
301.662.8112 - FAX 301.662.8117

**I.D.E.A.S., INC.**  
PLANT/REEF CONSULTANT  
8085 CHORDON RD.  
KIRTLAND, OHIO 44094  
440.296.1880 - FAX 440.296.1881

**BUILDING COST CONSULTANTS**  
COST ESTIMATING  
12817 - 30TH AVENUE  
PLATTSMOUTH, NEBRASKA 68048  
402.298.8290 - FAX 402.298.8290

**JOHN MILNER ASSOCIATES, INC.**  
CULTURAL RESOURCES CONSULTANT  
533 NORTH CHURCH ST.  
WEST CHESTER, PENNSYLVANIA 19380  
610.436.9000 - FAX 610.436.8468

**ARCHITECT/ENGINEERS:**

**POLT DESIGN GROUP**  
ARCHITECTURE  
PLANNING  
ENGINEERING  
2215 Conowingo Rd, Suite 101  
Bel Air, Maryland 21015-1436  
410.803.2141  
fax 410.836.6611  
www.polt-design.com

Drawing Title  
**UPPER LEVEL MALL FRAMING PLAN - A**

Approved: Project Director

Project Title  
**REPLACEMENT COMMUNITY LIVING CENTER**

Project Number  
512-173

Building Number  
370

Location  
**PERRY POINT VA MEDICAL CENTER**

Drawing Number  
SF104

Date  
06/08/18

Checked  
CEI

Drawn  
CEI

Office of Construction and Facilities Management

Department of Veterans Affairs