


SAMPLE IDENTIFICATION LEGEND

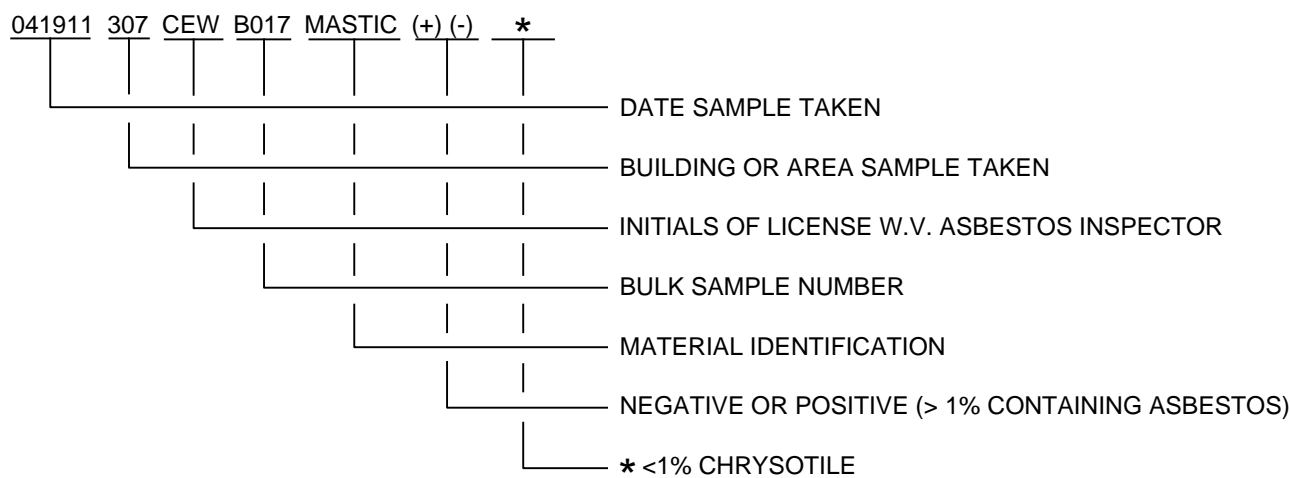

LEAD IN PAINT RESULTS

SAMPLE NUMBER	LABORATORY NUMBER	CONCENTRATION (%weight)	CONCENTRATION (mg/g)
041911302CEWPb001	TM-11-49396	0.58	5.8
041911302CEWPb002	TM-11-49397	3.0	30
041911302CEWPb003	TM-11-49398	0.19	1.9
041911302CEWPb004	TM-11-49399	0.25	2.5
041911302CEWPb005	TM-11-49400	0.44	4.4

NOTE: The Department of Housing and Urban Development classifies paint containing more than 0.5% lead by weight as being lead based.

MATERIAL LOCATION LEGEND


- DW JC CT1 FT28 FT28M CTGDM WGP
- DW JC CT1 CTGDM FT25 FT25M FT28 FT28M BB9 BB9M
- DW JC CT4 FT76 FT76M WGP
- DW JC BB9 BB9M CT4 WGP FT76 FT76M
- DW JC BB17 BB17M FT74 FT74M BMR WGP
- DW JC CT5 WGP FT28 FT28M
- DW JC CT4 CT5 SF24 SF24M FT74 FT74M WGP BB8 BB8M FT2 FT2M
- DW JC WGP FT2 FT2M
- DW JC FT74 FT74M CT5 WGP
- DW JC
- DW JC FT77 FT77M BB1 BB1M
- DW JC FT61 FT61M CT5 FT75 FT75M WGP
- DW JC CT5 CT3 CTGDM
- NO ACM

LEGEND:

KEY	DESCRIPTION
DW	DRYWALL
JC	JOINT COMPOUND
BB1	6" DARK BROWN BASE BOARD
BB1M	MASTIC FOR BB1
BB9	4" DARK GRAY BASEBOARD
BB9M	MASTIC FOR BB9
BB17	4" BLACK BASEBOARD
BB17M	MASTIC FOR BB17
CT1	12" X 12" INTERLOCKING CEILING TILE W/PITS & PUNCH MARKS
CT4	2' X 4' CEILING TILE W/WORMY GROOVES & PINHOLES
CT5	2' X 4' CEILING TILE W/RANDOM PUNCH MARKS & PINHOLES
CTGDM	CEILING TILE GLUE DOT MASTIC
FT28	9" X 9" FLOOR TILE LIGHT GREEN W/CREAM COLOR
FT28M	MASTIC FOR FT28
FT25	9" X 9" FLOOR TILE BLACK W/TAN & WHITE STREAKS
FT25M	MASTIC FOR FT25
FT74	12" X 12" FLOOR TILE BEIGE W/BROWN STREAKS
FT74M	MASTIC FOR FT74

LEGEND CONT:

KEY	DESCRIPTION
FT75	12" X 12" FLOOR TILE DARK BLUE
FT75M	MASTIC FOR FT75
FT76	9" X 9" FLOOR TILE OFF WHITE W/GREEN STREAKS
FT76M	MASTIC FOR FT76
FT77	12" X 12" FLOOR TILE GREEN MARBLE
FT77M	MASTIC FOR FT77
BMR	BLACK MASTIC RESIDUE
BB8	4" LIGHT GRAY BASE BOARD (NEW)
BB8M	MASTIC FOR BBB
CT3	12" X 12" INTERLOCKING CEILING TILE W/WORMY GROOVES & PINHOLES
FT61	9" X 9" BLACK FLOOR TILE
FT61M	MASTIC FOR FT61
FT2	12" X 12" FLOOR TILE BEIGE FLAKE
FT2M	MASTIC FOR FT2
SF24	SHEET FLOORING BURNT ORANGE CREAM TAN MOSAIC
FT24M	MASTIC FOR SF24
WGP	WINDOW GLAZING PUTTY

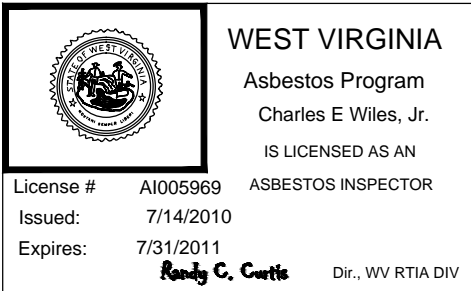

As - Built Conditions	CEW/CJZ	04/29/11
Rev	Explanation & Initials	IH/CAD Date

Professional Seal

NO SCALE

Drawing Title
ASBESTOS SURVEY

Approved:

Approved:

Project Title
BUILDING 302

Building Number

302

Checked

CEW

Drawn

CJZ

Location

VAMC, MARTINSBURG WV

Date
4/29/11

Project No.

Dwg. 1 of 1

