



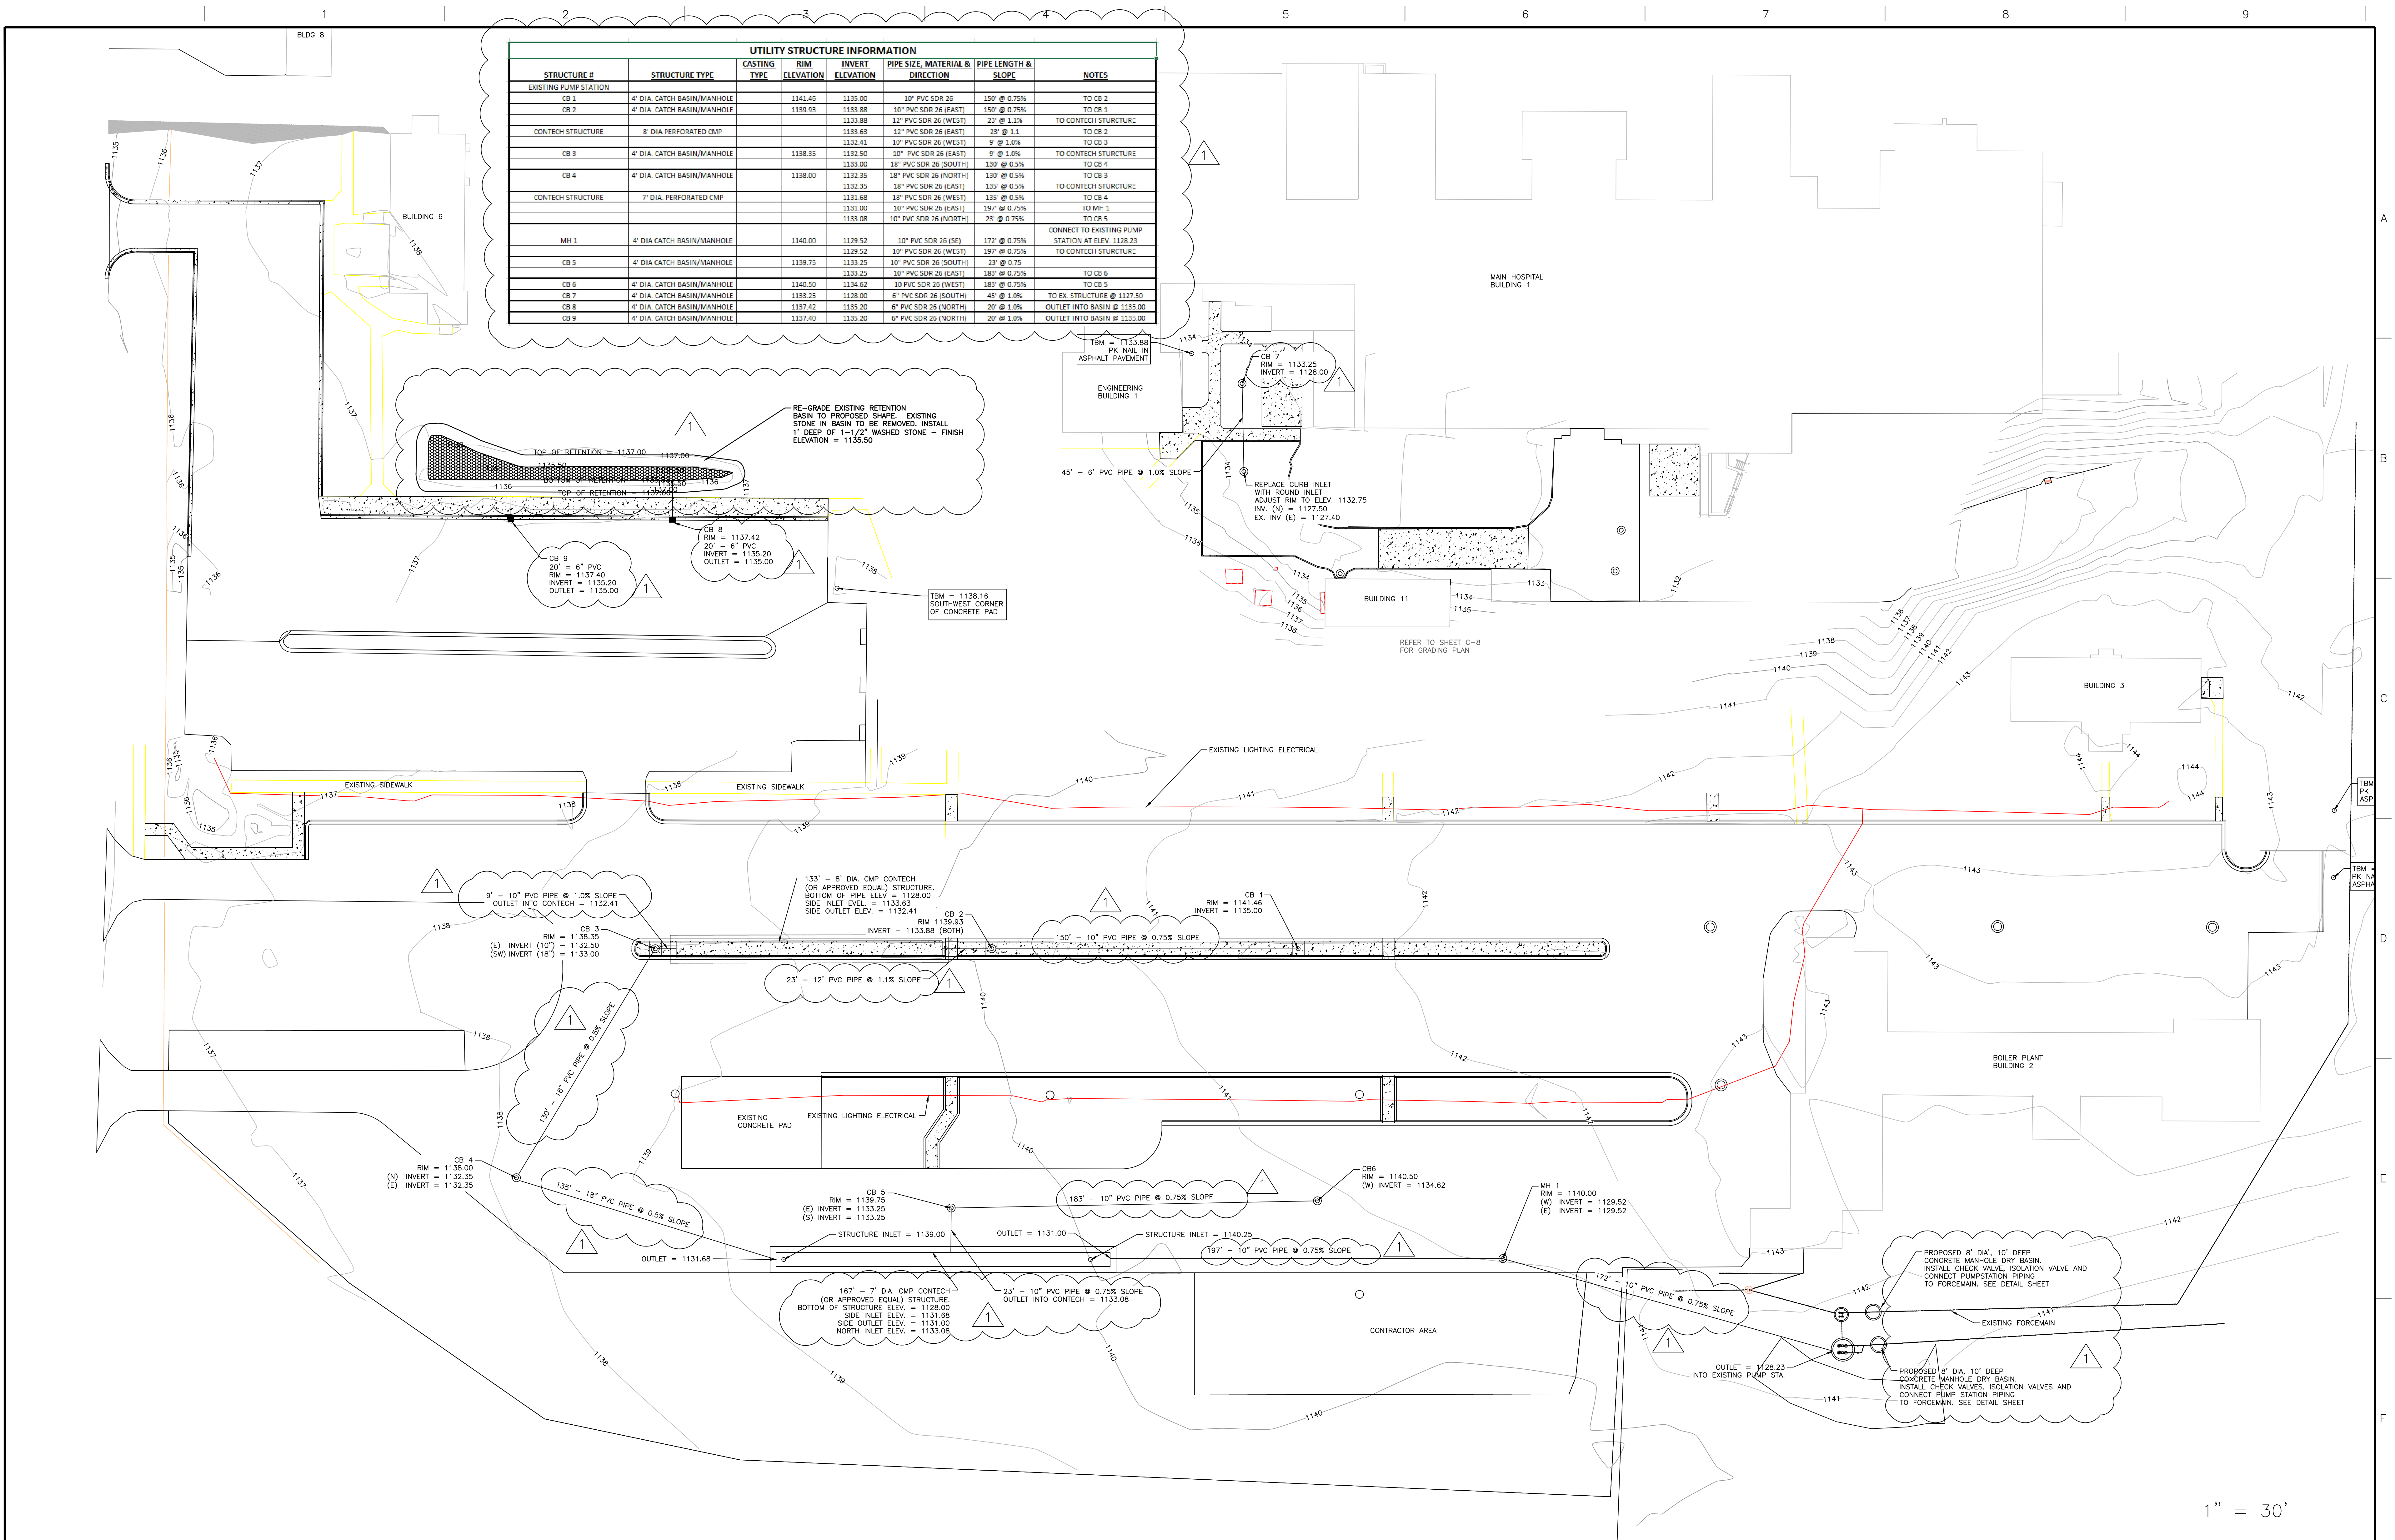

ADDENDUM #1

100% CONSTRUCTION DRAWINGS

Revisions:

10/16/18

9/11/18

Date

OSCAR G. JOHNSON

VA MEDICAL CENTER

IRON MOUNTAIN, MI 49801

W

VA

Drawing Title

UTILITY PLAN

Project Title

UPGRADE STAFF PARKING AREAS AND UTILITIES

Project Number

585-17-110

Building Number

1

Location

IRON MOUNTAIN, MICHIGAN

Date

9/11/18

Checked

AMS

Drawn

ARH

Project Number

585-17-110

Building Number

1

Drawing Number

Dwg. 6 of 16

C - 3

Department of Veterans Affairs