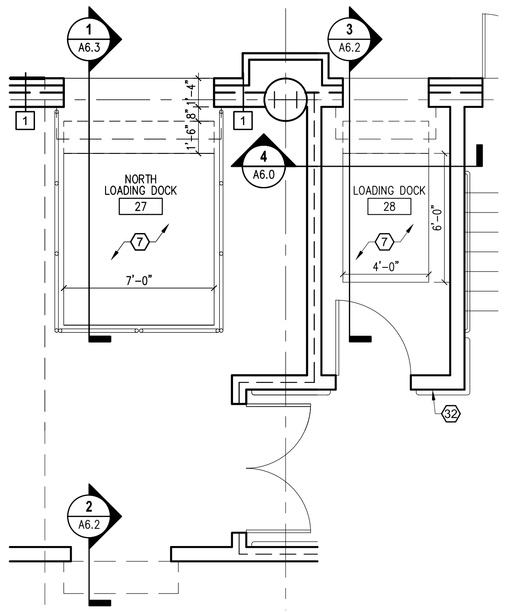

ENLARGED FLOOR PLAN

GRAPHIC SCALE SUPERSEDES NUMERIC SCALE

0 2' 4' 8'

SCALE: 1/4" = 1'-0"

6 A1.0 | A2.0

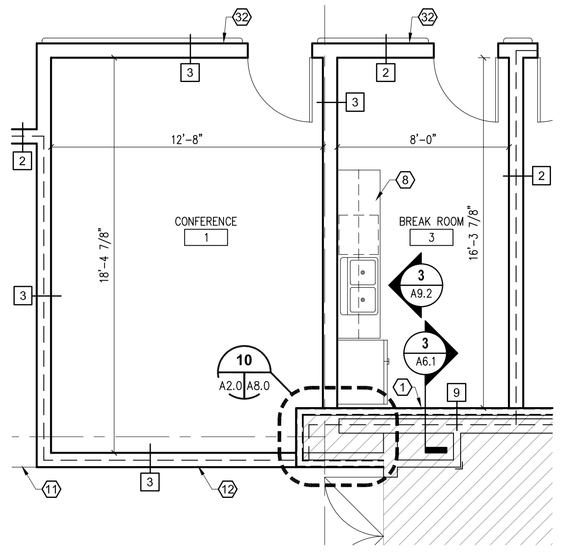

ENLARGED FLOOR PLAN

GRAPHIC SCALE SUPERSEDES NUMERIC SCALE

0 2' 4' 8'

SCALE: 1/4" = 1'-0"

5 A1.0 | A2.0

PLAN KEYNOTES: (KEYNOTES REFERENCED THIS SHEET ONLY)

1. EXISTING WALL TO REMAIN
2. EXISTING COLUMN TO REMAIN
3. WALL MOUNTED HANDRAIL, PAINT
4. EXISTING ROOF LEADER TO REMAIN
5. EXISTING MANHOLE AND COVER TO REMAIN
6. FURNITURE ITEM OWNER FURNISHED CONTRACTOR INSTALLED (O.F.C.I.)
7. HYDRAULIC LIFT, SEE REFERENCED SECTIONS
8. BASE CABINETS AND COUNTERTOP, SEE REFERENCED ELEVATION
9. 1 1/4" DIA. STANDARD PIPE GUARD (42"H.) AND HANDRAIL (34"–36"H.), PAINT
10. SOILED LINEN CARTS OWNER FURNISHED OWNER INSTALLED (O.F.O.I.)
11. FLOOR EXPANSION JOINT COVER AND FLOOR FIRE BARRIER. PROVIDE METAMAT FLOOR FIRE BARRIER BY BALCO INC. OR EQUAL PROVIDE FLOOR EXPANSION JOINT COVER WITH "NO BUMP" OR NO CHANGE IN FLOOR ELEVATION. SEE DETAIL 7/A6.1
12. FLOOR EXPANSION JOINT COVER AND FLOOR FIRE BARRIER FOR TWO HOUR FIRE RATED CONSTRUCTION. PROVIDE EXPANSION JOINT COVERS BY BALCO INC., SEE DETAIL 6/A6.1
13. WALL GUARDS AND BASE GUARDS
14. SHADED AREA INDICATES CONSTRUCTION WORK FOR MODERNIZATION OF ICU BEDS, PROJECT NO. 646–366 TO BE COMPLETED BY OTHERS. SHOWN ON THIS DRAWING FOR REFERENCE ONLY.
15. EXISTING CONCRETE BOLLARD TO REMAIN
16. EXISTING ROOF LEADER TO REMAIN
17. WALL MOUNTED URINAL, SEE PLUMBING
18. WATER CLOSET, SEE PLUMBING
19. WALL MIRROR
20. REFER TO FIXTURE MOUNTING HEIGHTS FOR GRAB BARS, TOILET ACCESSORIES AND MOUNTING HEIGHTS
21. TOILET PAPER ROLL HOLDER (O.F.C.I.)
22. SOLID SURFACE VANITY COUNTER WITH 4" BACK SPLASH
23. STAINLESS STEEL TOILET PARTITIONS
24. WALL MOUNTED SOAP DISPENSER (O.F.C.I.)
25. PAPER TOWEL DISPENSER (O.F.C.I.)
26. SANITARY NAPKIN DISPOSAL
27. COAT HOOK
28. STAINLESS STEEL URINAL SCREEN
29. COIN OPERATED SANITARY NAPKIN DISPENSER
30. TELEPHONE ALCOVE, SEE DETAIL 12/A7.0
31. EMERGENCY EYE WASH STATION. RELOCATE FROM CURRENT STORAGE AREA
32. WALL MOUNTED ROOM IDENTIFICATION SIGN, REFER TO SPECIFICATIONS
33. NEW SANITARY MANHOLE LOCATION, SEE CIVIL ENGINEERING DRAWINGS AND AD1.0.

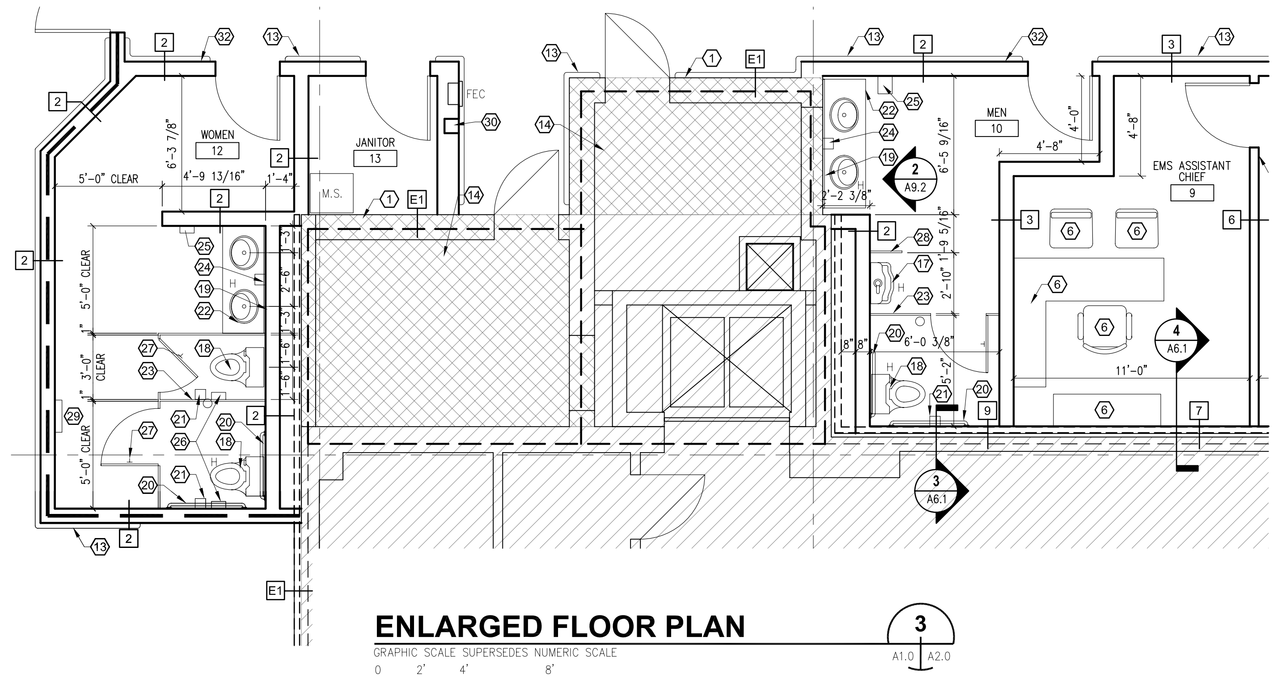

ENLARGED FLOOR PLAN

GRAPHIC SCALE SUPERSEDES NUMERIC SCALE

0 2' 4' 8'

SCALE: 1/4" = 1'-0"

3 A1.0 | A2.0

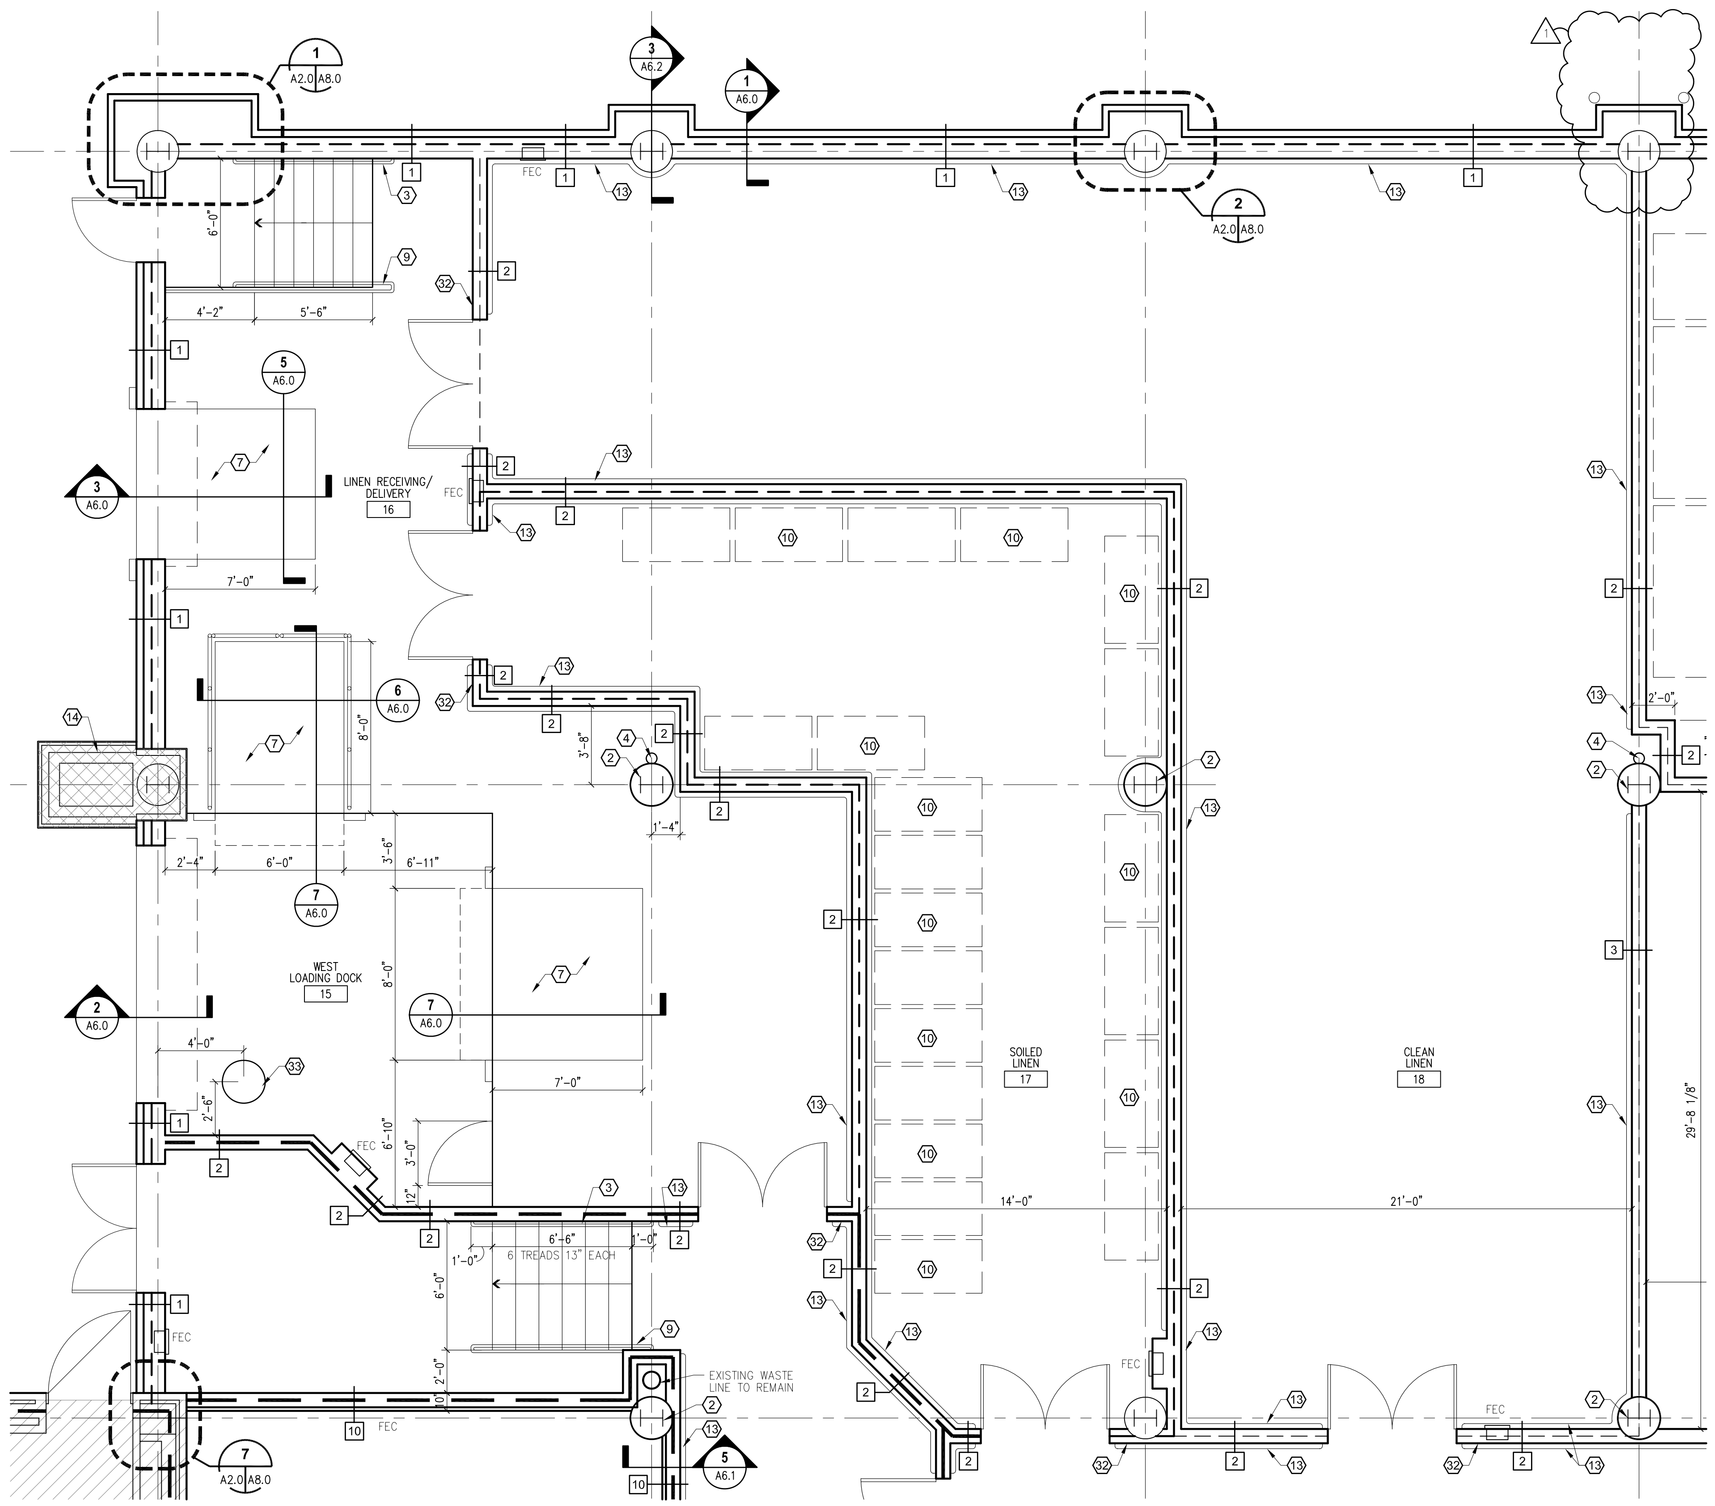

ENLARGED FLOOR PLAN

GRAPHIC SCALE SUPERSEDES NUMERIC SCALE

0 2' 4' 8'

SCALE: 1/4" = 1'-0"

4 A1.0 | A2.0

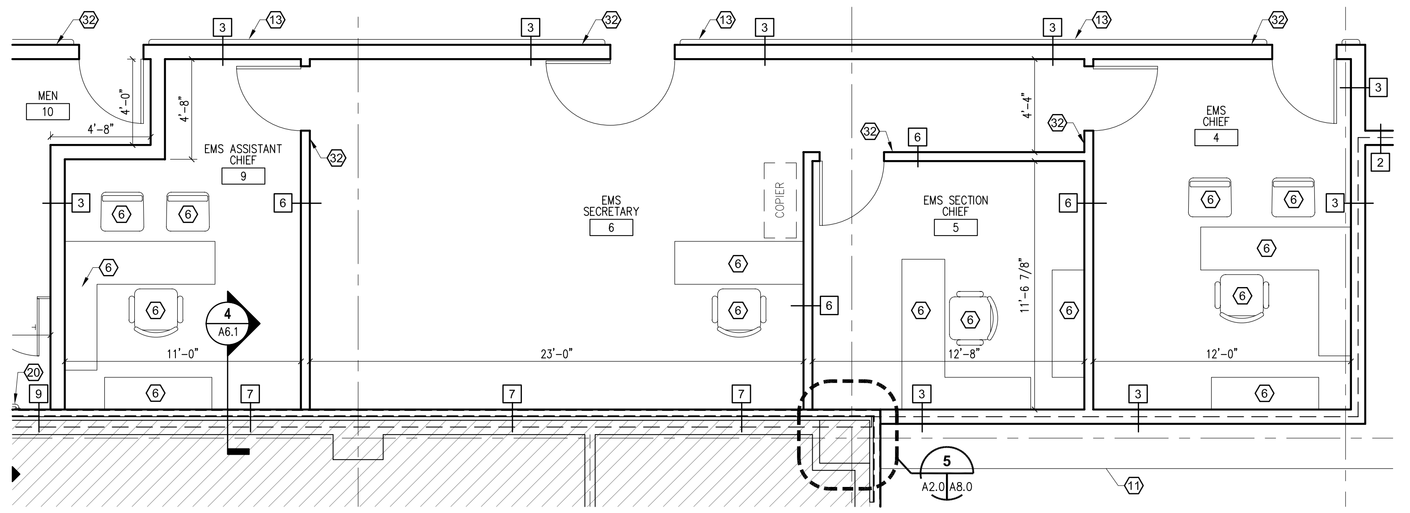

ENLARGED FLOOR PLAN

GRAPHIC SCALE SUPERSEDES NUMERIC SCALE

0 2' 4' 8'

SCALE: 1/4" = 1'-0"

2 A1.0 | A2.0

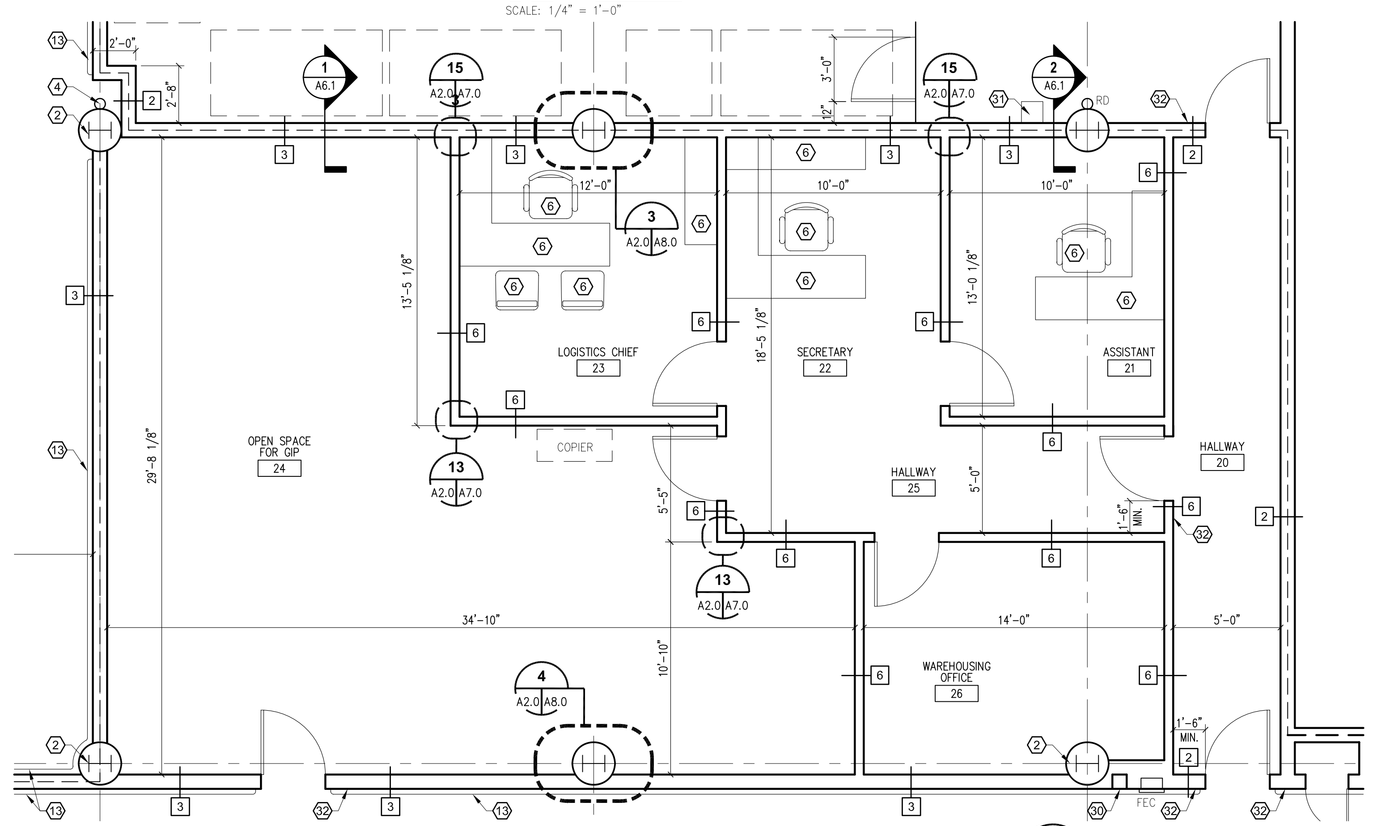

ENLARGED FLOOR PLAN

GRAPHIC SCALE SUPERSEDES NUMERIC SCALE

0 2' 4' 8'

SCALE: 1/4" = 1'-0"

1 A1.0 | A2.0

FULLY SPRINKLERED BUILDING

BID DOCUMENTS

	REVISIONS	DATE
1	ICU ELEVATOR OMITTED	AUGUST 21, 2012
2		
3		
4		
5		
6		
7		
8		
9		

PARADIGM
ENGINEERS AND CONSTRUCTORS
PO BOX 436223
Louisville, Kentucky 40253
502-339-8511 www.paradigmusa.com

UPGRADE SPD AND SECURITY DOCK
PROJECT: 646-367

VA PITTSBURGH HEALTHCARE SYSTEM
UNIVERSITY DRIVE C
PITTSBURGH, PENNSYLVANIA 15240

Department of Veterans Affairs

MADE BY: JG | CHECKED:

DATE: 7-28-11

ENLARGED FLOOR PLANS

DRAWING NO.: A2.0R1 | BID PKG.