


three inches = one foot
one and one half inches = one foot
one inch = one foot
three quarters inch = one foot
one half inch = one foot
three eighths inch = one foot
one quarter inch = one foot
one eighth inch = one foot
one eighth inch = one foot

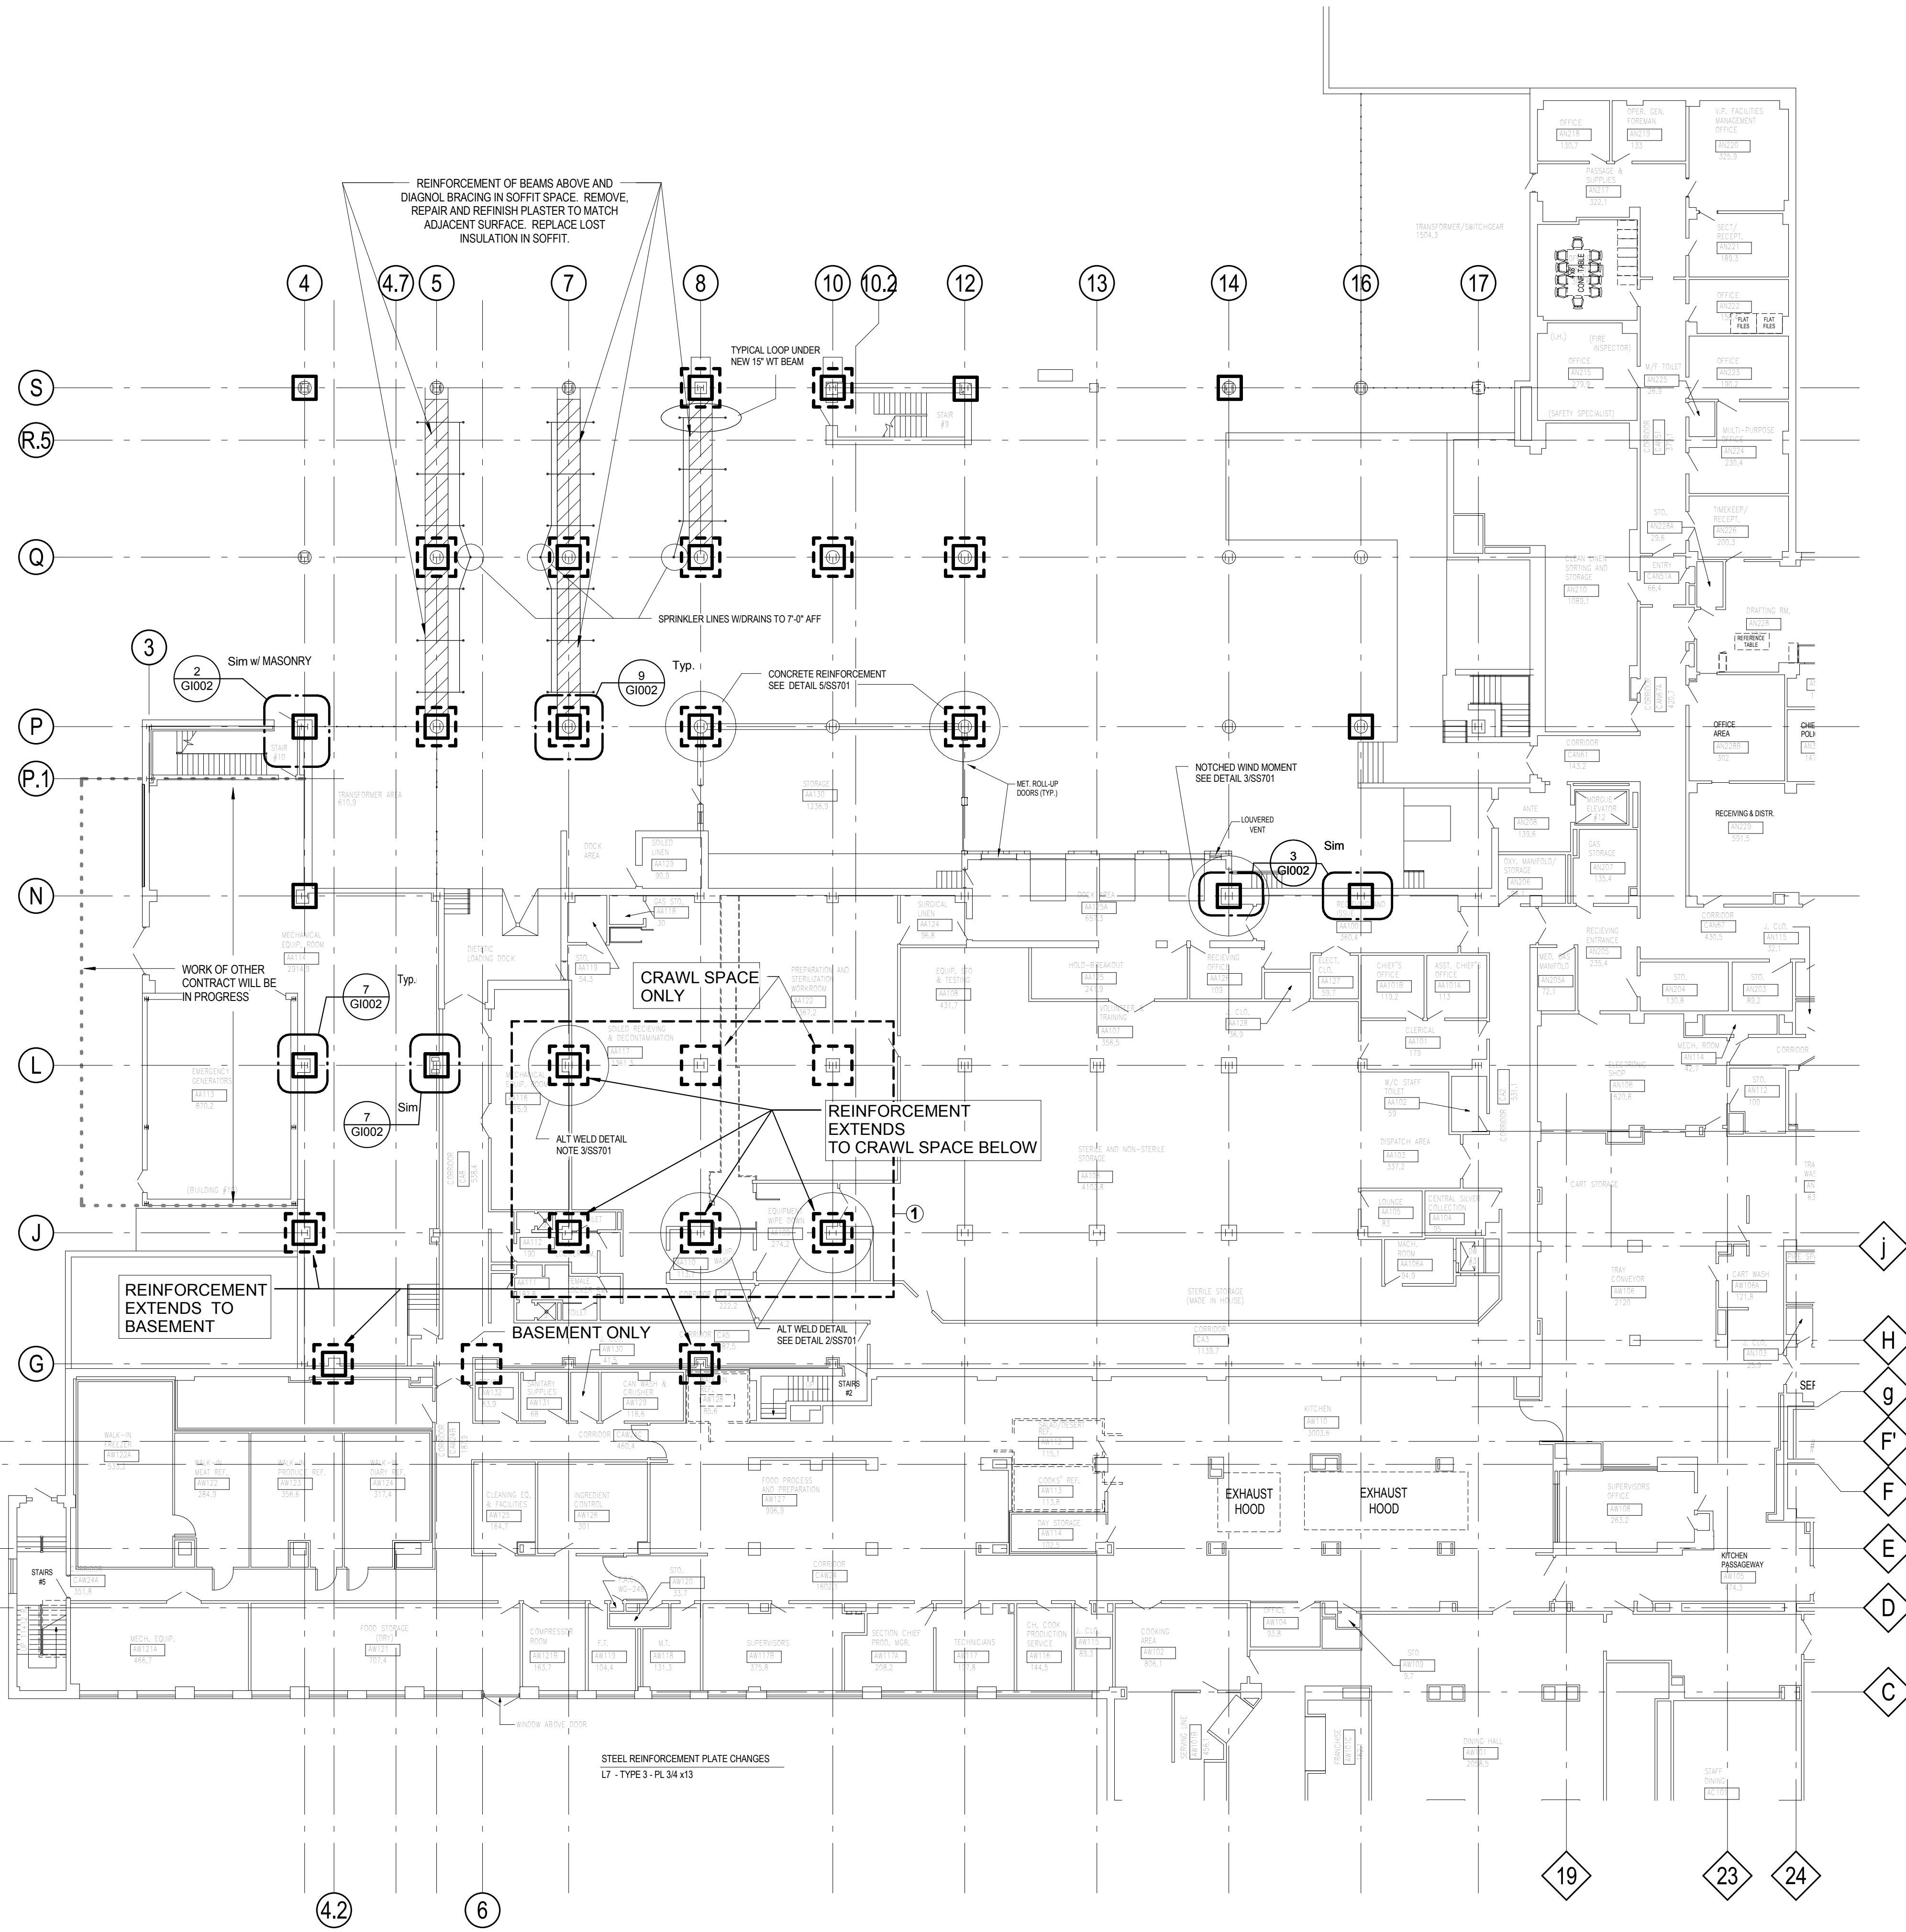



COLUMN AND COLUMN BEAM CONNECTION IN WALLS AND ABOVE CEILING
COORDINATE LOCATIONS AND REQUIRED SCOPE OF STRUCTURAL WORK ON THE STRUCTURAL DRAWINGS AND OTHER CONSTRUCTION DOCUMENTS. REINFORCING IDENTIFIED ON EACH FLOOR CAN REPRESENT WORK ANYWHERE FROM FLOOR TO STEEL FRAMING FLOOR ABOVE.
WORK WILL REQUIRE CUTTING AND PATCHING OF EXISTING FINISHES. REPLACE AND REPAIR ALL EXISTING CONSTRUCTION TO MATCH EXISTING FINISHES. PROTECT ADJACENT EXISTING SURFACE OUTSIDE WORK AREA. REPLACE ALL FIREPROOFING DISTURBED BY THE REMEDIAL WORK.
FOLLOW CLOSELY MEDICAL CENTER REQUIREMENTS AS DESCRIBED IN THE SPECIFICATIONS.
FOLLOW INFORMATION REGARDING ACCESSING ROOMS AS DESCRIBED IN THE SPECIFICATIONS.
FOLLOW ICRA MATRIX OF PRECAUTIONS FOR CONSTRUCTION & RENOVATION

REINFORCING REMEDIAL WORK EXTENDING TO BELOW GROUND FLOOR SLABS / PAVEMENTS REQUIRING TO PATCH SLABS / PAVEMENTS MATCHING ADJACENT CONSTRUCTION

NOTES:

- WORK IN THIS AREA, CENTRAL STERILE, SHALL BE LIMITED TO THE HOURS OF 9:30PM TO 5:30AM. COORDINATE ICRA PARTITION ARRANGEMENT WITH OWNER SINCE SERVICE IN THESE ROOMS WILL CONTINUE DAILY. COORDINATE WORK REQUIRED IN CLOSE PROXIMITY OF STERILE PROCESSING EQUIPMENT WITH OWNER.
- COORDINATE WORK WITH MECHANICAL, ELECTRICAL, PLUMBING AND FIRE PROTECTION PLANS TO PREPARE EXTENT OF TEMPORARY DISCONNECTION OF DUCTS AND OTHER UTILITY LINES.
- COORDINATE WITH OWNER ARRANGEMENT OF ICRA PARTITIONS.
- WE REMIND THE CONTRACTOR THAT CONCURRENT WITH THIS PROJECT, OWNER HAS NUMEROUS, SEPARATE, ONGOING CONTRACTS IN VARIOUS STAGES, WITHIN THE FACILITY.

CONSTRUCTION DOCUMENT SUBMISSION
FULLY SPRINKLERED

		CONSULTANTS:				ARCHITECT/ENGINEERS:		Drawing Title		Project Title		Project Number		Office of Construction and Facilities Management Department of Veterans Affairs	
		LLI ENGINEERING				IKM Incorporated		Gound Floor Plan Remedial Work		VAPHS - UNIVERSITY DRIVE SITE PREP FOR ICU		646-10-108			
		6000 BROOKTREE ROAD, SUITE 300 WEXFORD, PA 724 934-8800		1500 ARDMORE BOULEVARD, SUITE 200 PITTSBURGH, PA 15221 (412) 271-5080 PHONE (412) 271-5183 FAX		Architects - Planners - Interior Designers 1 PPG Place Pittsburgh, PA 15222 412-281-1337 Fax 412-281-4639				Location VAMC University Drive, Pittsburgh, PA		Building Number			
AS - BUILT		02.17.2012		FILE NO. 10068						Date 8-06-10		Checked GB			
Revisions:		Date													