


642-18-SP4-0018
 VA 244-18-AP-3060

642-18-584-00 1P
VA 244-18-AP-3060

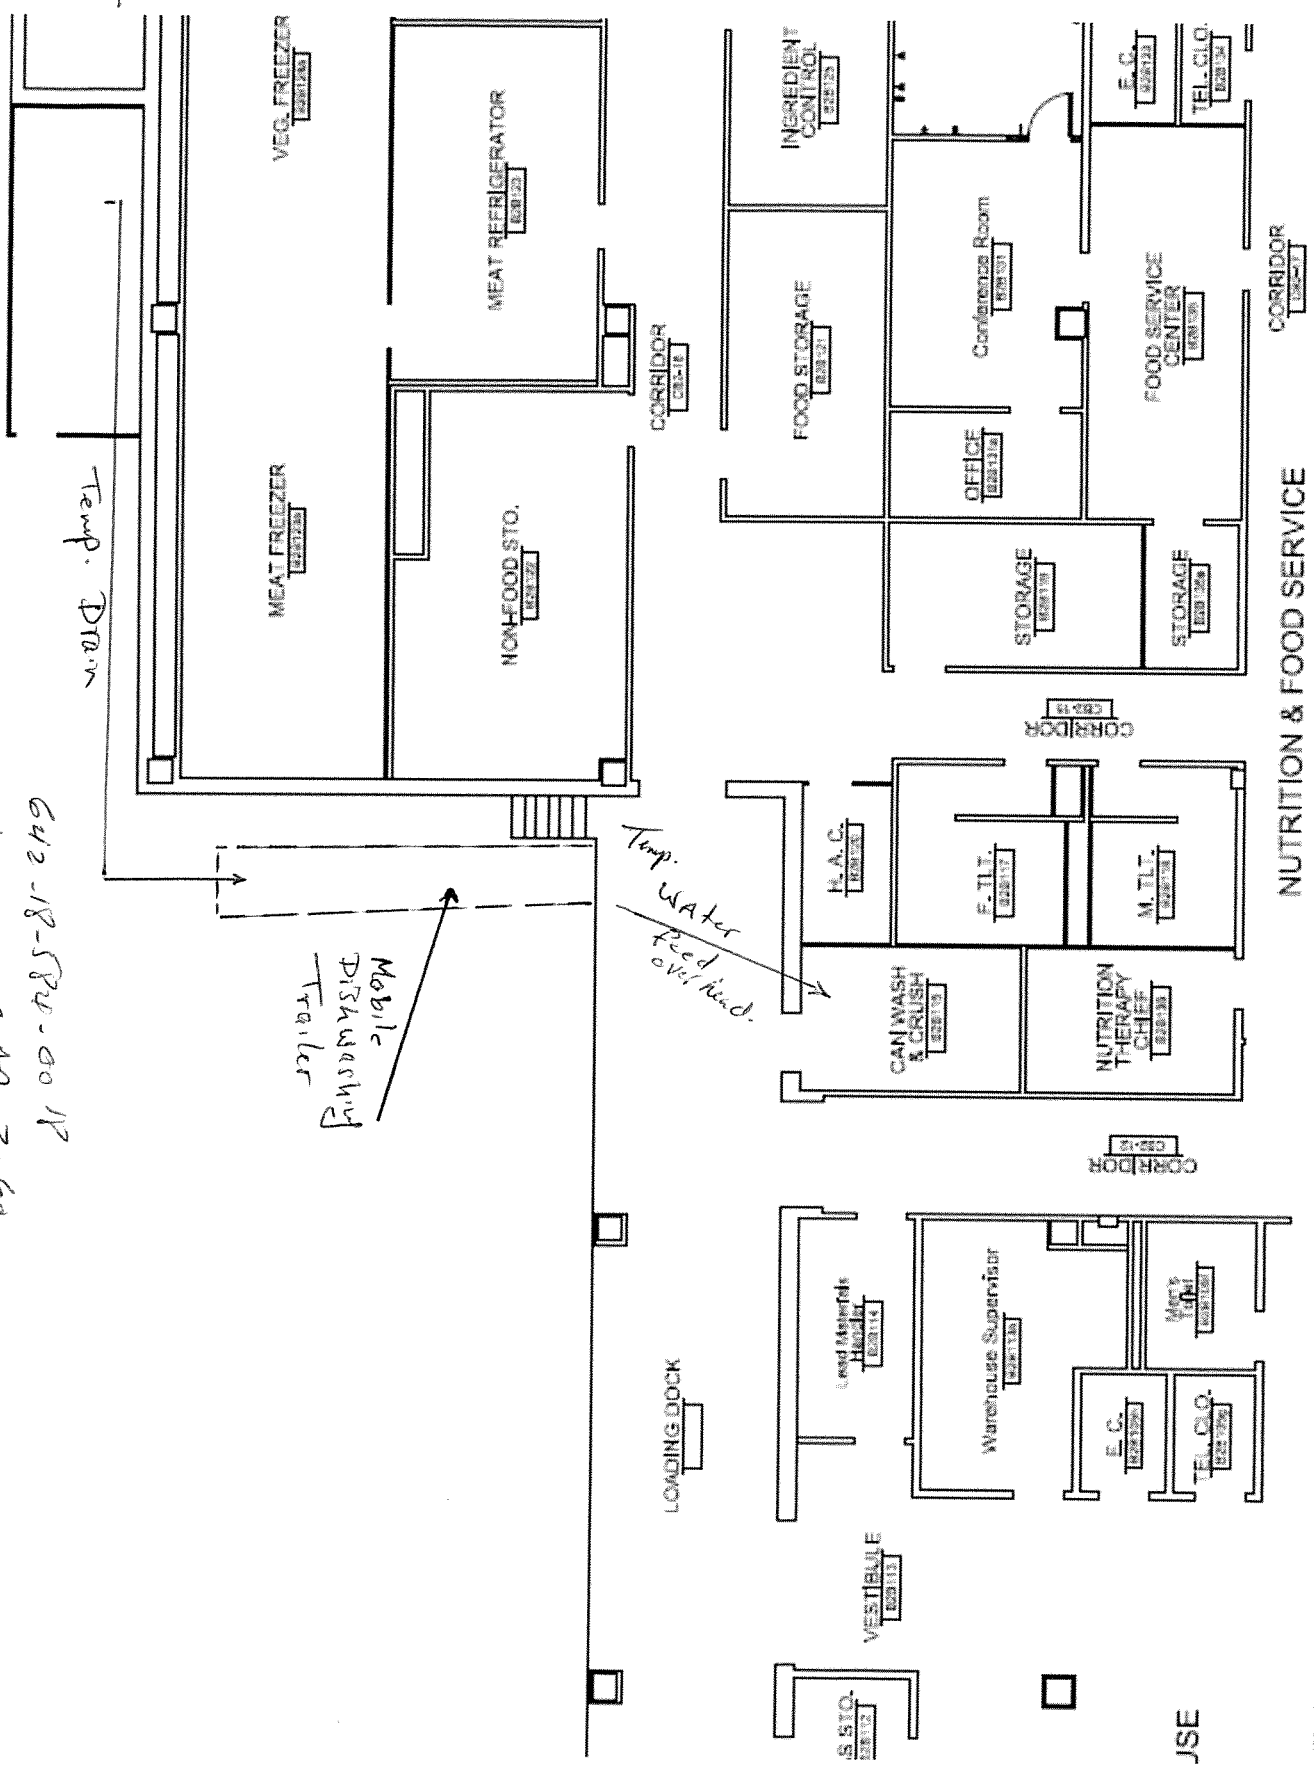

JSE

Warehouse