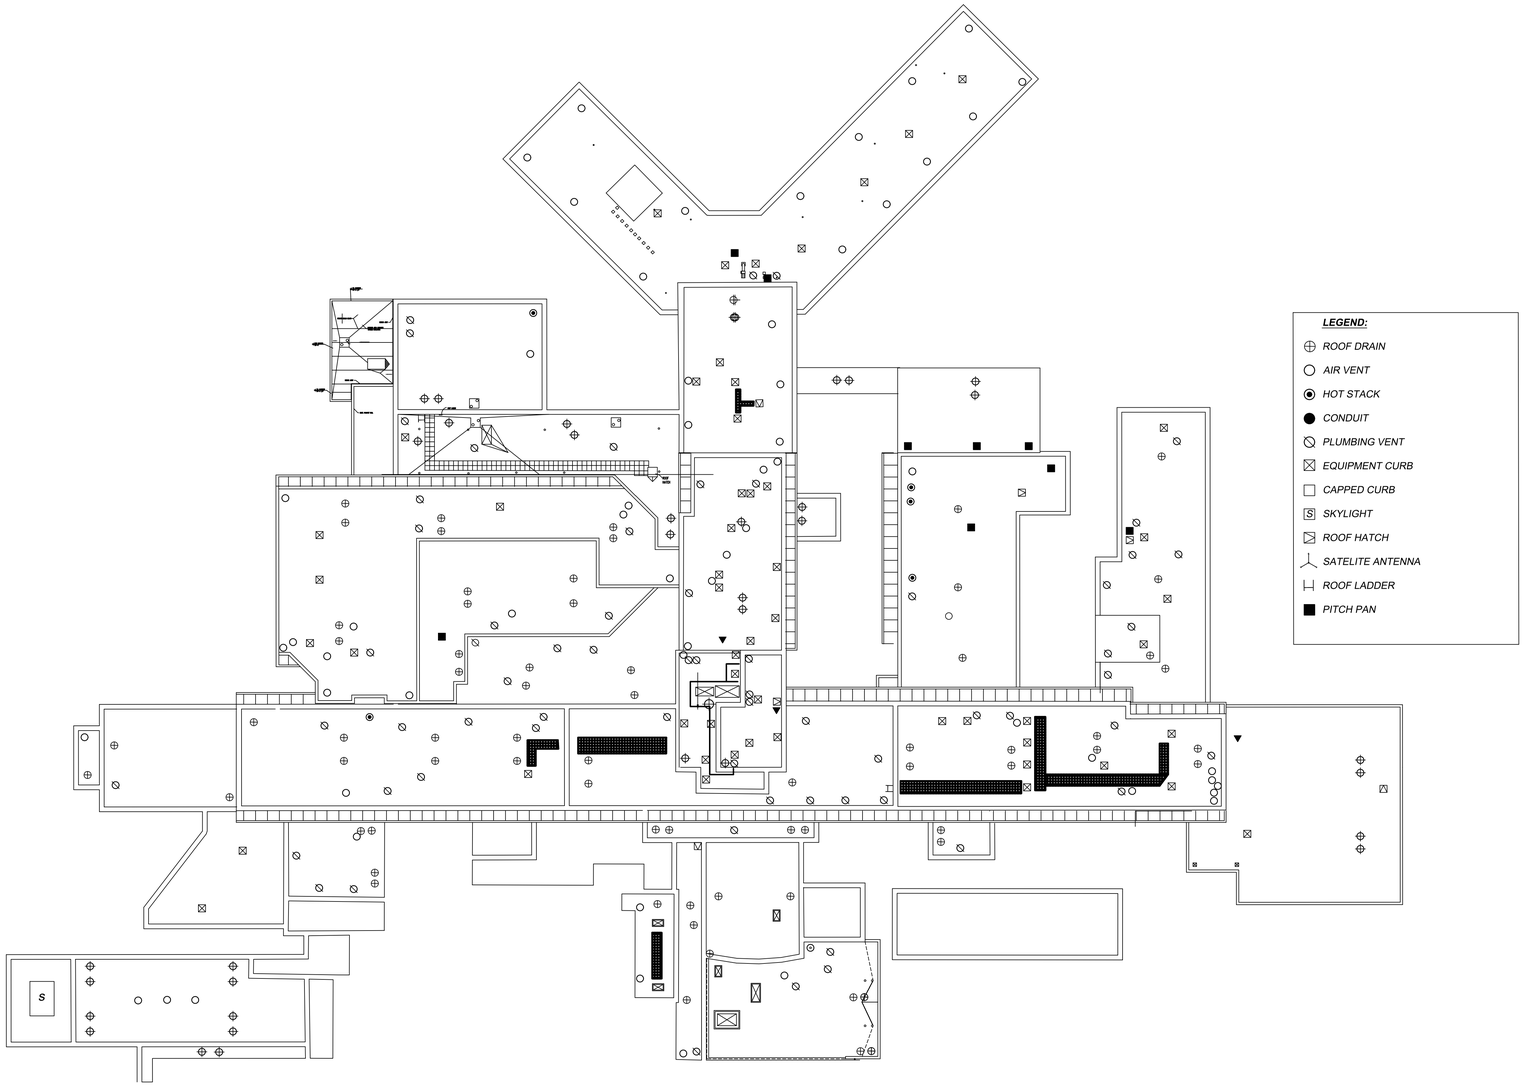

LEGEND:

- ROOF DRAIN
- AIR VENT
- HOT STACK
- CONDUIT
- PLUMBING VENT
- EQUIPMENT CURB
- CAPPED CURB
- SKYLIGHT
- ROOF HATCH
- SATELITE ANTENNA
- ROOF LADDER
- PITCH PAN

B.1 ROOF PLAN

1/64"=1'-0"

TRUE NORTH PROJECT NORTH

Revisions	CADD Information: CAD/FY06/XXX	Drawing Title: B.1 ROOF PLAN		Project Title: ARCHITECTURAL ASBUILTS	Date: 02/16
Date					Project No.
	Approved:	Approved: Medical Center Director	Drawn: C RYAN	Building Number: B. 1	DRAWING No. A-8
	Approved:	Approved: Chief, Engineering	Checked	Location: VAMC, SLC. UTAH.	Dwg. 8 Of 8

Department of Veterans Affairs