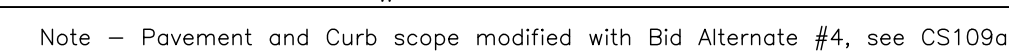


LEGEND	
<b>Proposed</b>	
Limits of Disturbance (1.91 Acres)	-----
Curb & Gutter, See Detail D, Sheet CS104	=====
Storm Sewer	-----ST-----ST-----
Storm Manhole	●
2'x2' Catch Basin	■
Yard Drain	■
Storm Structure Numbering	①
Sanitary Service Lateral	-----SAS-----SAS-----
Water Service	-----W-----W-----
Water Valve	⊕
Fire Department Connection	⚡
Electric	-----E-----E-----
Electric Manhole	EA
Fuel Oil Line	-----
Loading Dock Pavement, See Detail A, Sheet CS104	
Sidewalk	
See Detail B, Sheet CS102	
<b>Existing</b>	
Existing Sanitary Sewer	○-----SA-----
Existing Sanitary Structure Numbers	③
Existing Storm Sewer	□-----ST-----
Existing Storm Structure Numbers	②①
Existing Water Main	-----W-----
Existing Electric	-----E-----
Existing Fire Hydrant	⊕
Existing Water Valves	⊕ ⊕
Existing Electric Pull Box	⊕
Existing Electric Outlet	⊕
Existing Electric Pedestal Box	E
Existing Wooden Light Pole	⊕
Existing Metal Light Pole	⊕
Existing Mailbox	MB
Existing Fence Post	⊕
Existing Stop Sign	⊕
Existing Trees	⊕ ⊕ ⊕
Existing Tree Numbering	①⑧
Existing Bushes	

**BID ALTERNATE #4:**  
DELETE CONNECTING CORRIDOR, ADD RETAINING WALL AND PEDESTRIAN WALK BRIDGE (SEE STRUCTURAL PLANS FOR DETAILS OF RETAINING WALL AND BRIDGE), ADD 6' WIDE WALK CONNECTION FROM 501 BUILDING TO PROPOSED DEMENTIA BUILDING, REDUCE LIMITS OF UPPER COURTYARD CONCRETE INSTALLATION. FOR GRADING MODIFICATIONS AND CLARIFICATION OF SCOPE, SEE CS109A. INSTALL LOW VOLTAGE DUCT BANK PER MECHANICAL PLANS.

VA FORM 08-6231