



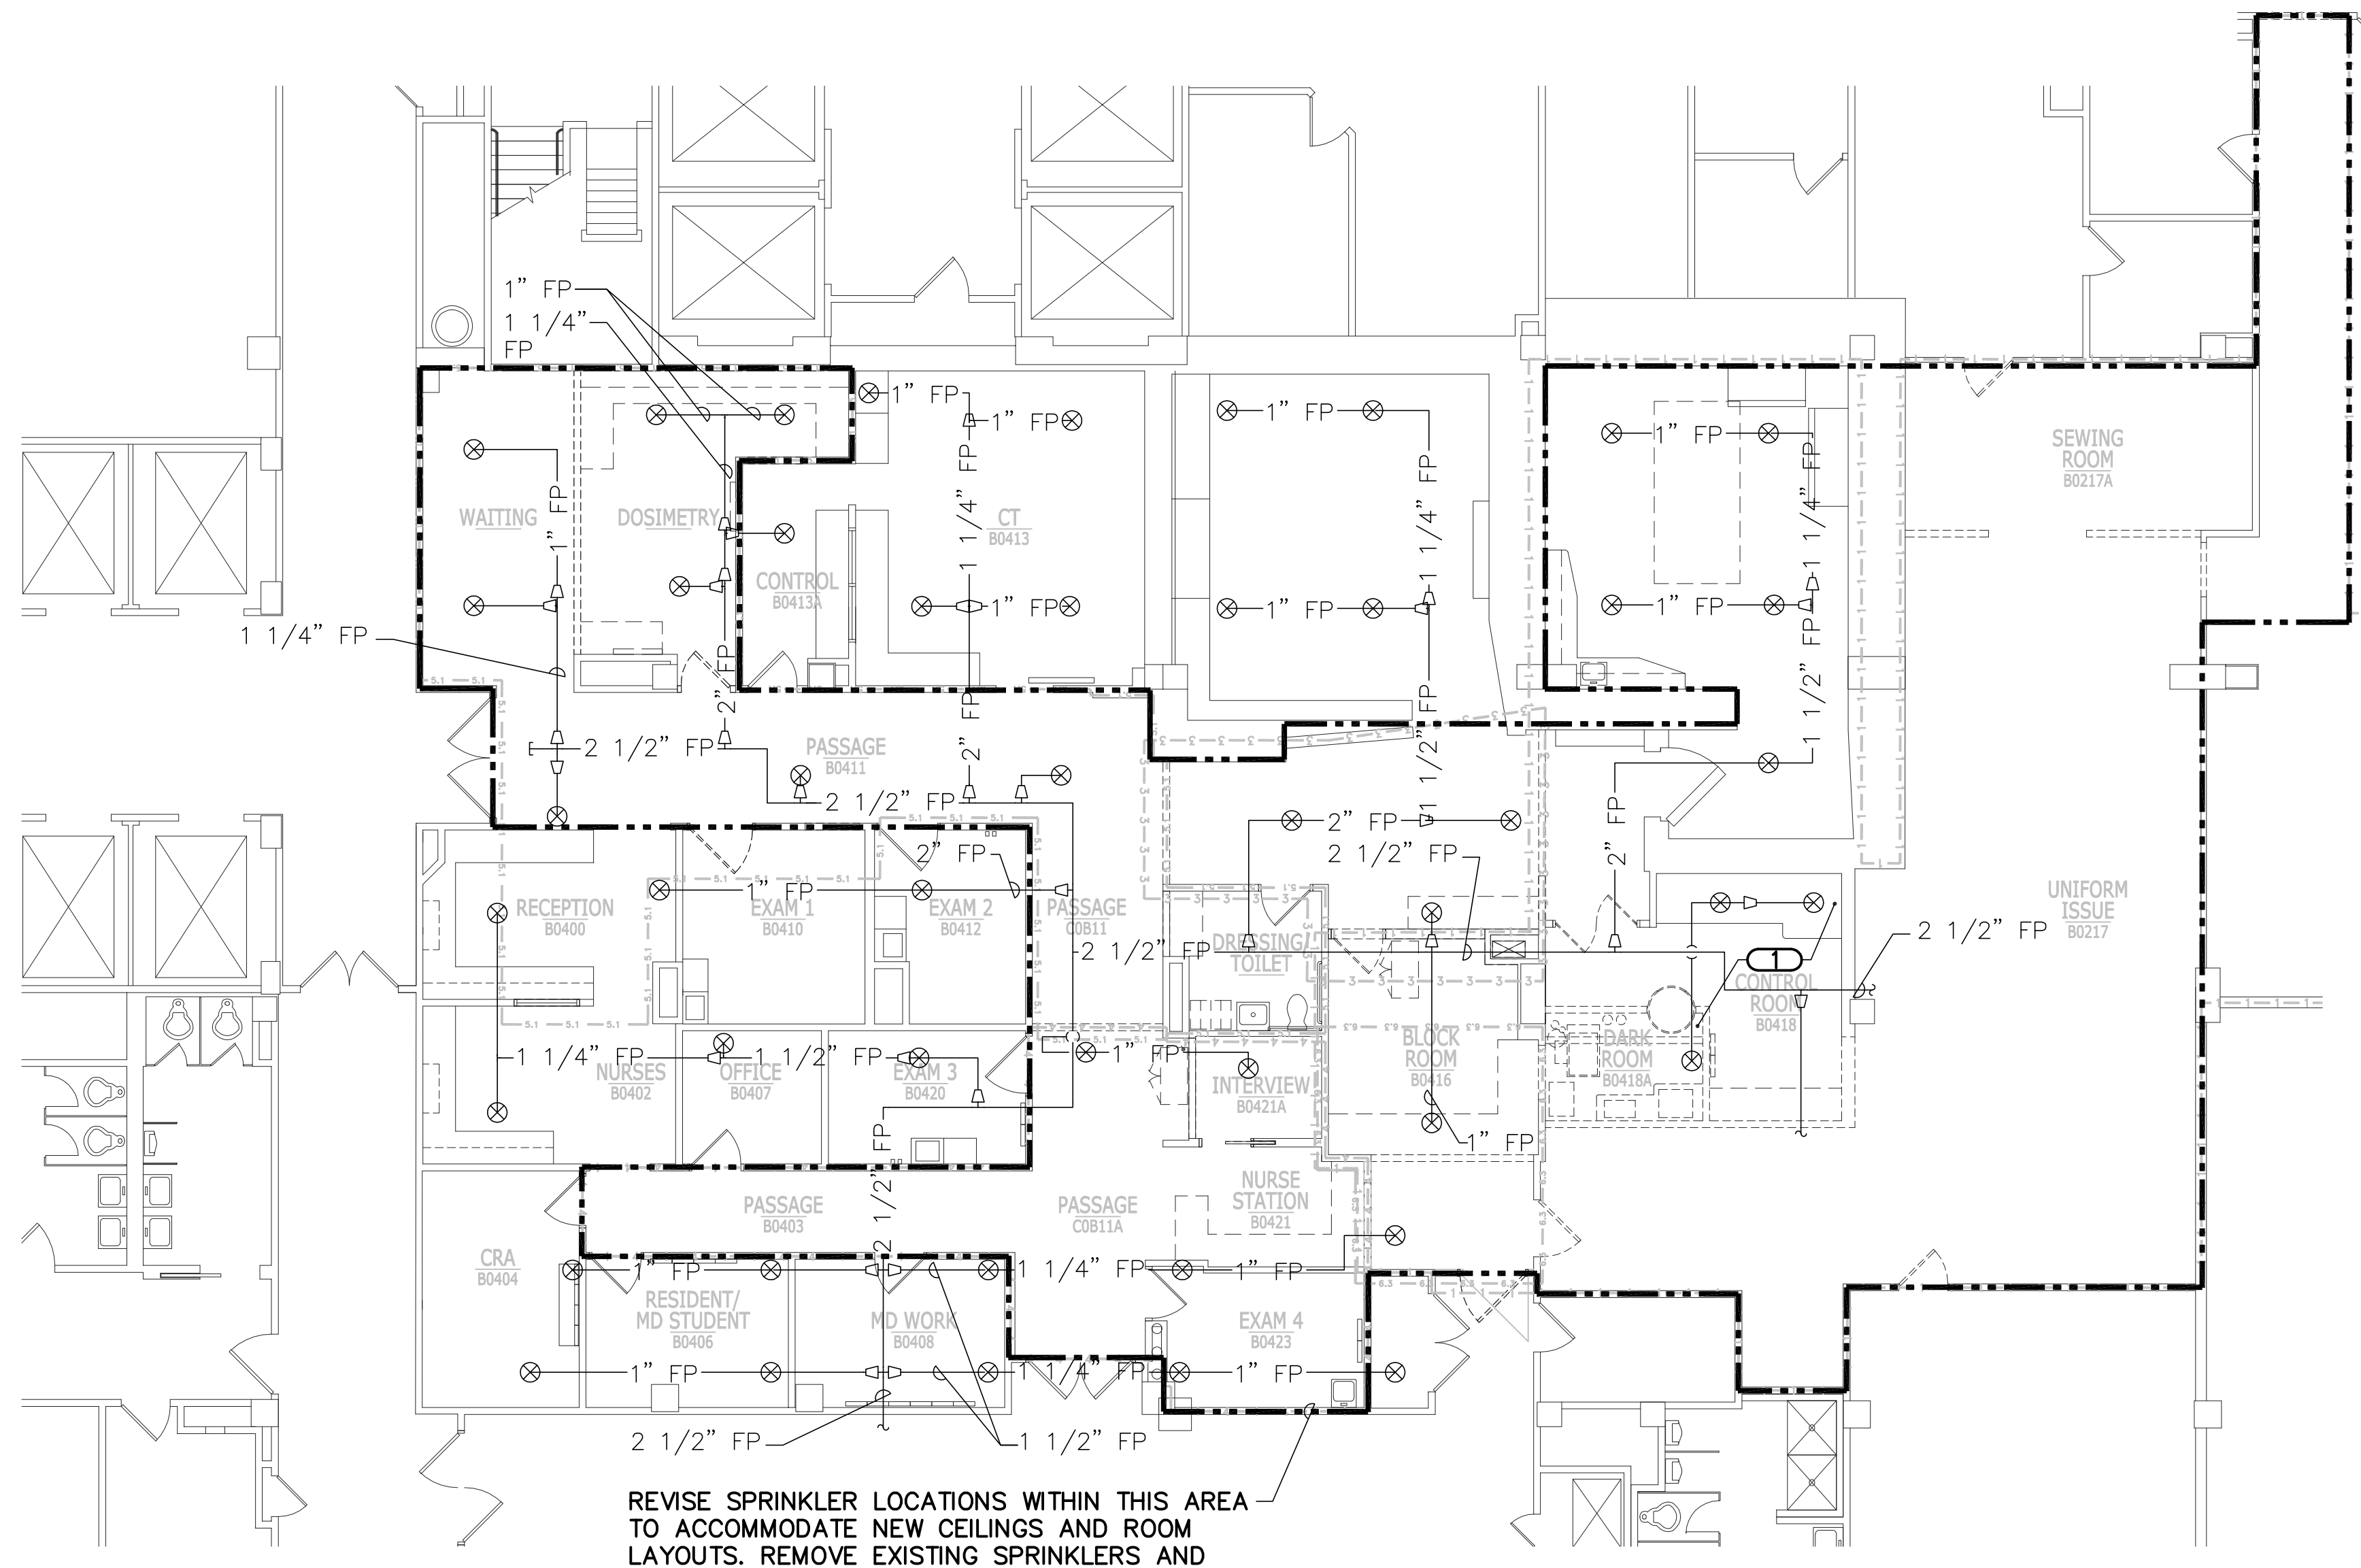

1 DEMOLITION PLAN - FIRE PROTECTION
SCALE: 1/8"=1'-0"

FIRE PROTECTION SYMBOLS LIST	
SYMBOL:	DESCRIPTION:
	EXISTING TO REMAIN
	EXISTING TO BE REMOVED
	NEW
	FIRE PROTECTION
	SPRINKLER
	LIGHT HAZARD
	ORDINARY GROUP 2

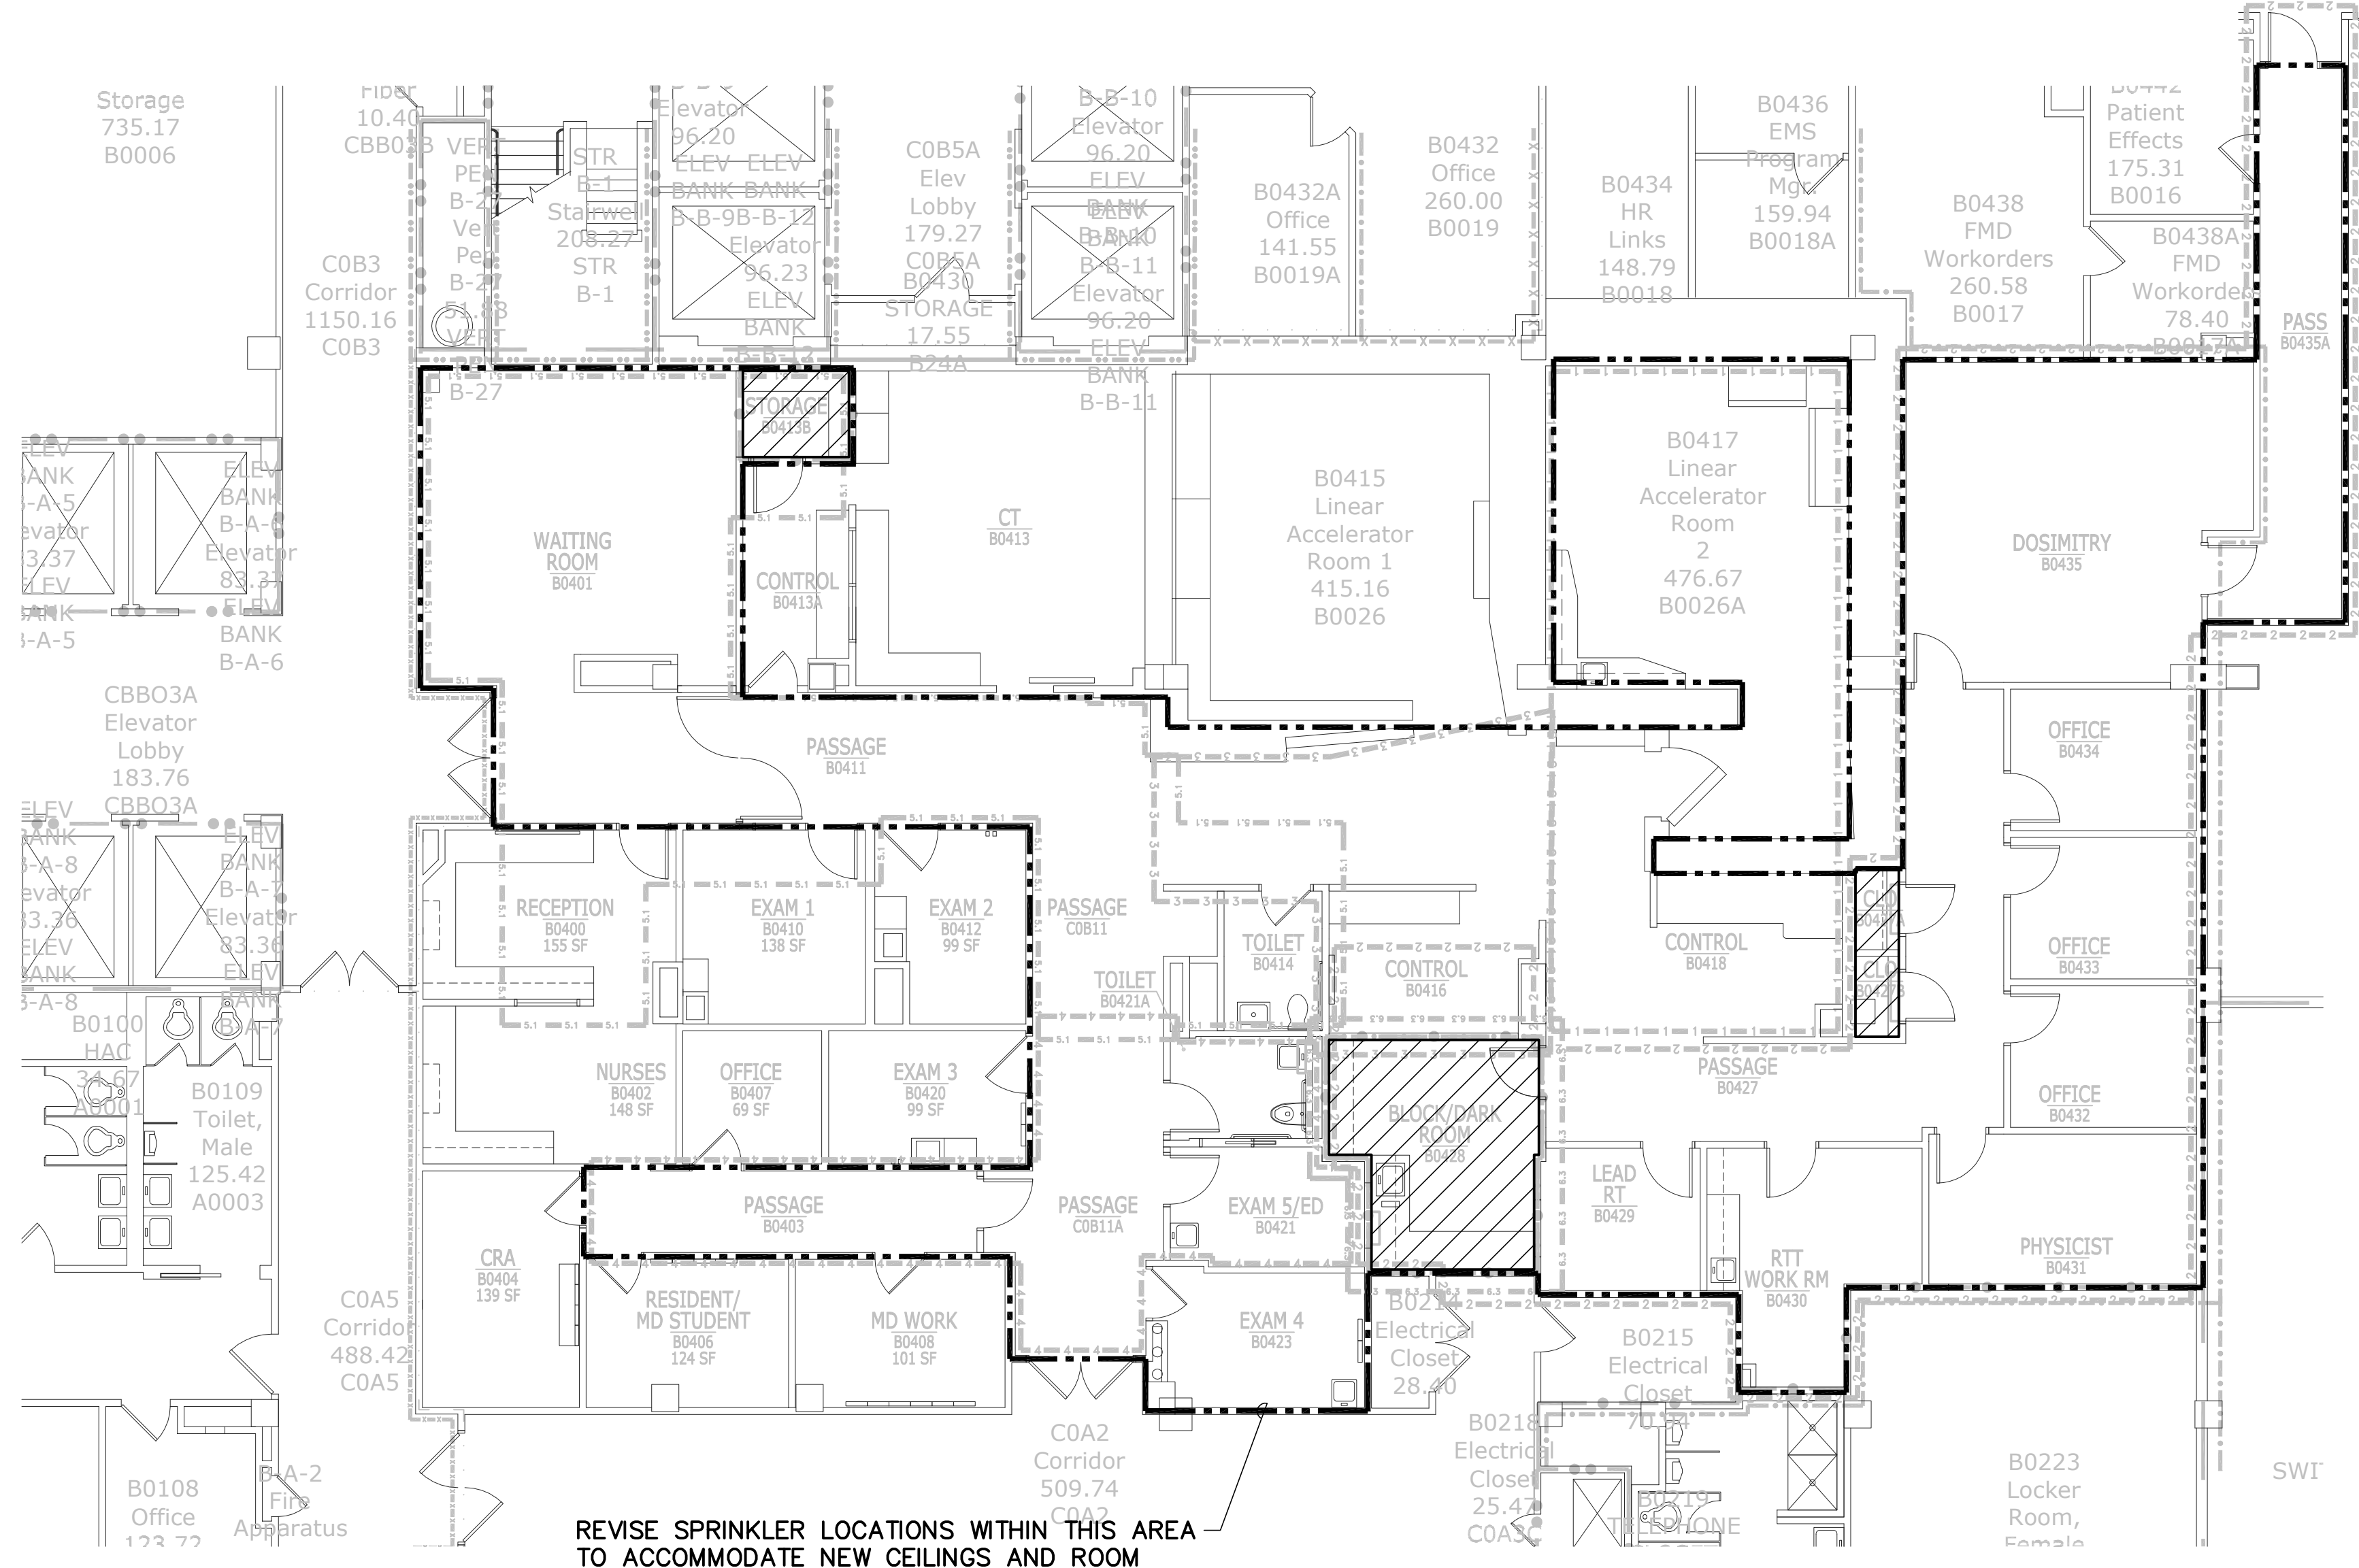

2 FLOOR PLAN - FIRE PROTECTION
SCALE: 1/8"=1'-0"

DEMOLITION PHASE LINETYPE KEY	
PHASE 1 DEMOLITION WORK	
PHASE 2 DEMOLITION WORK	
PHASE 3 DEMOLITION WORK	
PHASE 4 DEMOLITION WORK	
PHASE 5 DEMOLITION WORK	
PHASE 6 DEMOLITION WORK	

NEW WORK PHASE LINETYPE KEY	
PHASE 1 NEW WORK	
PHASE 2 NEW WORK	
PHASE 3 NEW WORK	
PHASE 4 NEW WORK	
PHASE 5 NEW WORK	
PHASE 6 NEW WORK	

FIRE / SMOKE BARRIER DESIGNATIONS	
THE SYMBOLS SHOWN ARE FOR THE CONVENIENCE OF THE CONTRACTOR. THE CONTRACTOR SHALL VERIFY RATINGS WITH THE LATEST SET OF ARCHITECTURAL PLANS AND FURNISH ALL MATERIALS REQUIRED TO COMPLY WITH THOSE RATINGS WHETHER SHOWN OR NOT.	
ALL FLOOR ASSEMBLIES SHALL BE DESIGNATED AS 2 HOUR FIRE/SMOKE BARRIERS, UNLESS NOTED OTHERWISE ON THE PLANS. RATINGS WERE ACQUIRED FROM THE ARCHITECTURAL PLANS DATED 04/02/2012.	
1 HOUR FIRE BARRIER	
2 HOUR FIRE BARRIER	
1 HOUR FIRE/SMOKE BARRIER	
2 HOUR FIRE/SMOKE BARRIER	

GENERAL NOTES	
1. REFER TO FX500 FOR TYPICAL GENERAL FIRE PROTECTION NOTES.	
2. THE FIRE PROTECTION DRAWINGS ARE CONCEPTUAL FOR GENERAL INFORMATION ONLY AND SHALL NOT BE CONSTRUED AS FINAL DESIGN OR INSTALLATION DOCUMENTS. THE SPRINKLER DESIGN AND INSTALLATION SHALL BE THE RESPONSIBILITY DESIGN-BUILD FIRE PROTECTION CONTRACTOR. THIS INCLUDES RELOCATION OF SPRINKLER MAINS, BRANCH PIPING AND HEADS AS NECESSARY FOR THE DESIGN. REFER TO SPECIFICATION FOR DESIGN CRITERIA.	
3. WORK SHALL BE COMPLETED IN PHASES IDENTIFIED ON THESE DRAWINGS. REFER TO ARCHITECTURAL PHASING DRAWINGS FOR ADDITIONAL INFORMATION. PROVIDE TEMPORARY PROVISIONS TO ACCOMMODATE PHASED CONSTRUCTION WHERE UTILITIES CROSS PHASING BOUNDARIES.	
KEYNOTES	
1. REMOVE EXISTING ABANDONED SPRINKLERS AND PIPING LOCATED ABOVE EXISTING CONTROL ROOM. FIELD VERIFY EXACT LOCATION AND QUANTITY.	

Amendment No. 3

09/05/12

Revisions

Date

CONSULTANTS:

KJWW ENGINEERING CONSULTANTS
802 WEST BROADWAY, SUITE 312
MILWAUKEE, WISCONSIN 53213-1031
608.223.9600 FAX: 608.223.9601
www.kjww.com PROJECT #11.0871.00
Experience you can build on.
KJWW ENGINEERING RESERVES PROPRIETARY RIGHTS, INCLUDING COPYRIGHTS, TO THIS DRAWING AND THE DATA SHOWN THEREON. THIS DRAWING AND/OR DATA ARE THE EXCLUSIVE PROPERTY OF KJWW ENGINEERING AND SHALL NOT BE USED OR REPRODUCED FOR ANY OTHER PROJECT WITHOUT THE EXPRESS WRITTEN APPROVAL AND PARTICIPATION OF KJWW ENGINEERING.
©2012 KJWW, P.C.
REFERENCE SCALE IN INCHES
0 1 2 3

PROJECT LOCATION

ARCHITECT:

11000 West Park Place • Milwaukee WI 53224 • Tel 414 359-3060 • Fax 414 359-3070
www.prarch.com
PRA Job No. R100077-10

Drawing Title

FLOOR PLANS - FIRE PROTECTION

Project Title

Building 111 - Radiation Oncology Expansion

Project Number

695-10-131

Building Number

111

Location

VA Medical Center, Milwaukee, WI

Date

20 August 2012

Checked

MJL

Drawn

DAS

Drawing Number

FX101

Dwg. 1 of 2

Office of Construction and Facilities Management

FULLY SPRINKLERED