



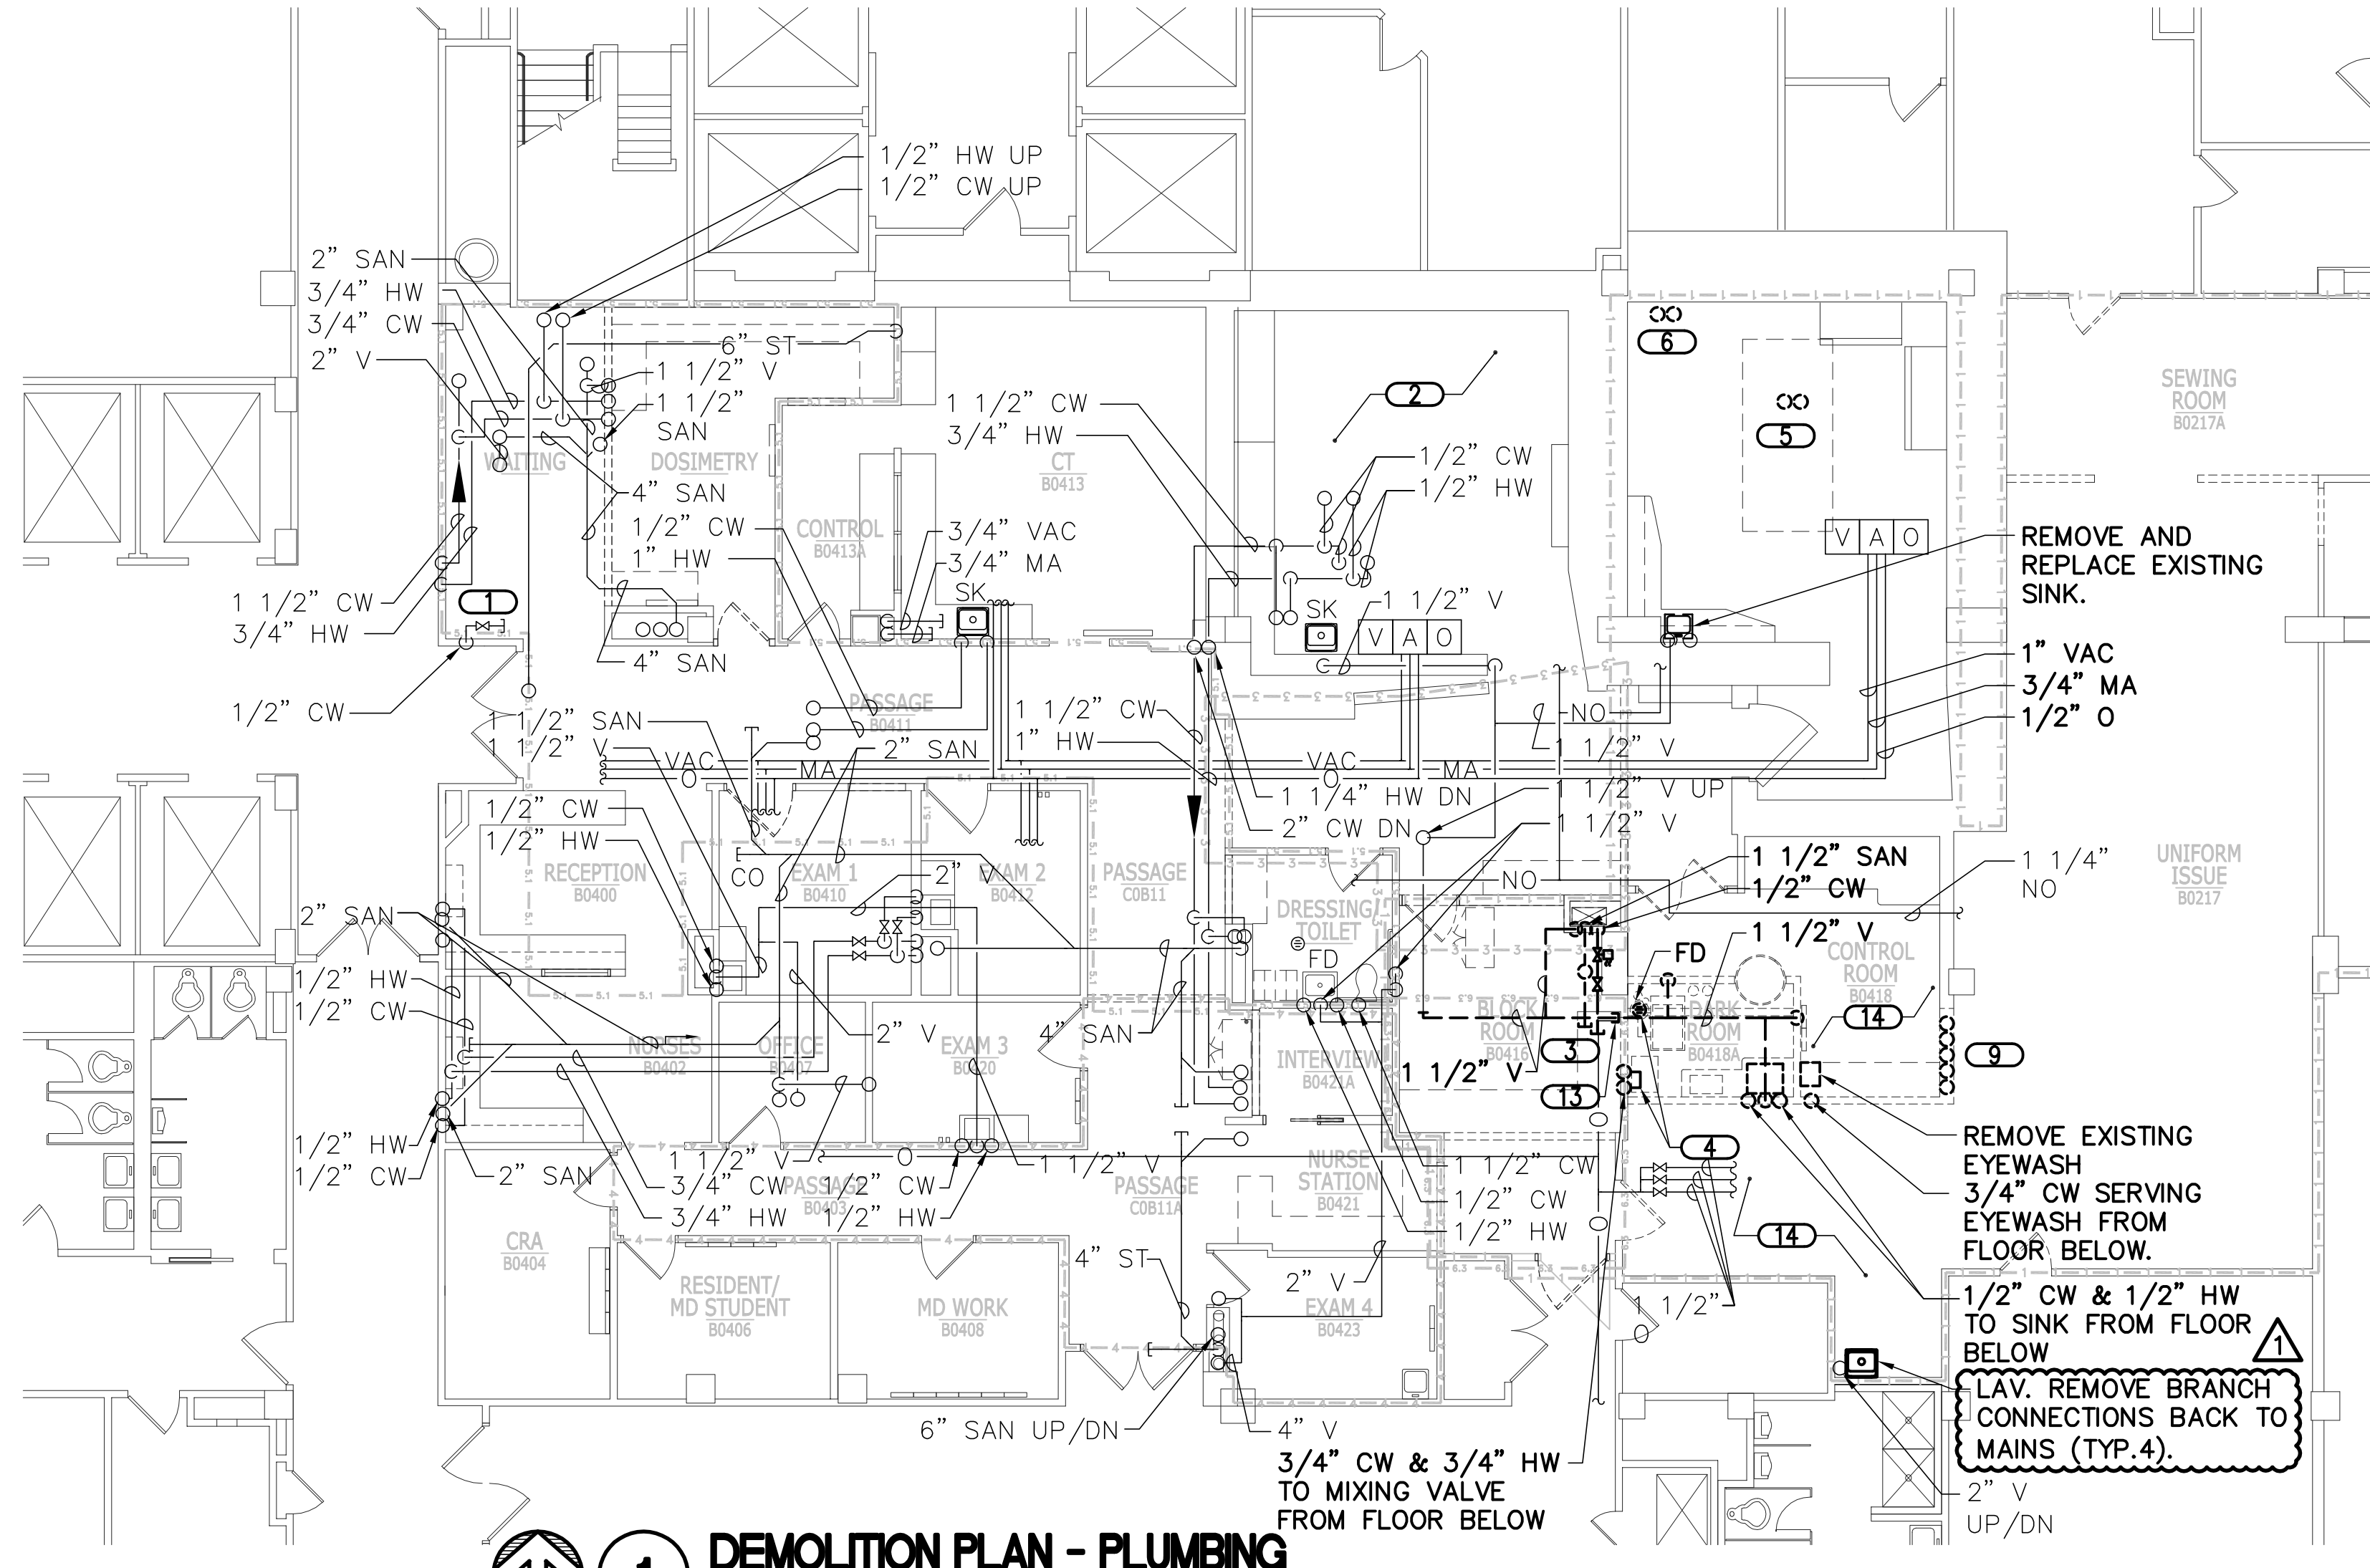

1 DEMOLITION PLAN - PLUMBING
SCALE: 1/8"=1'-0"

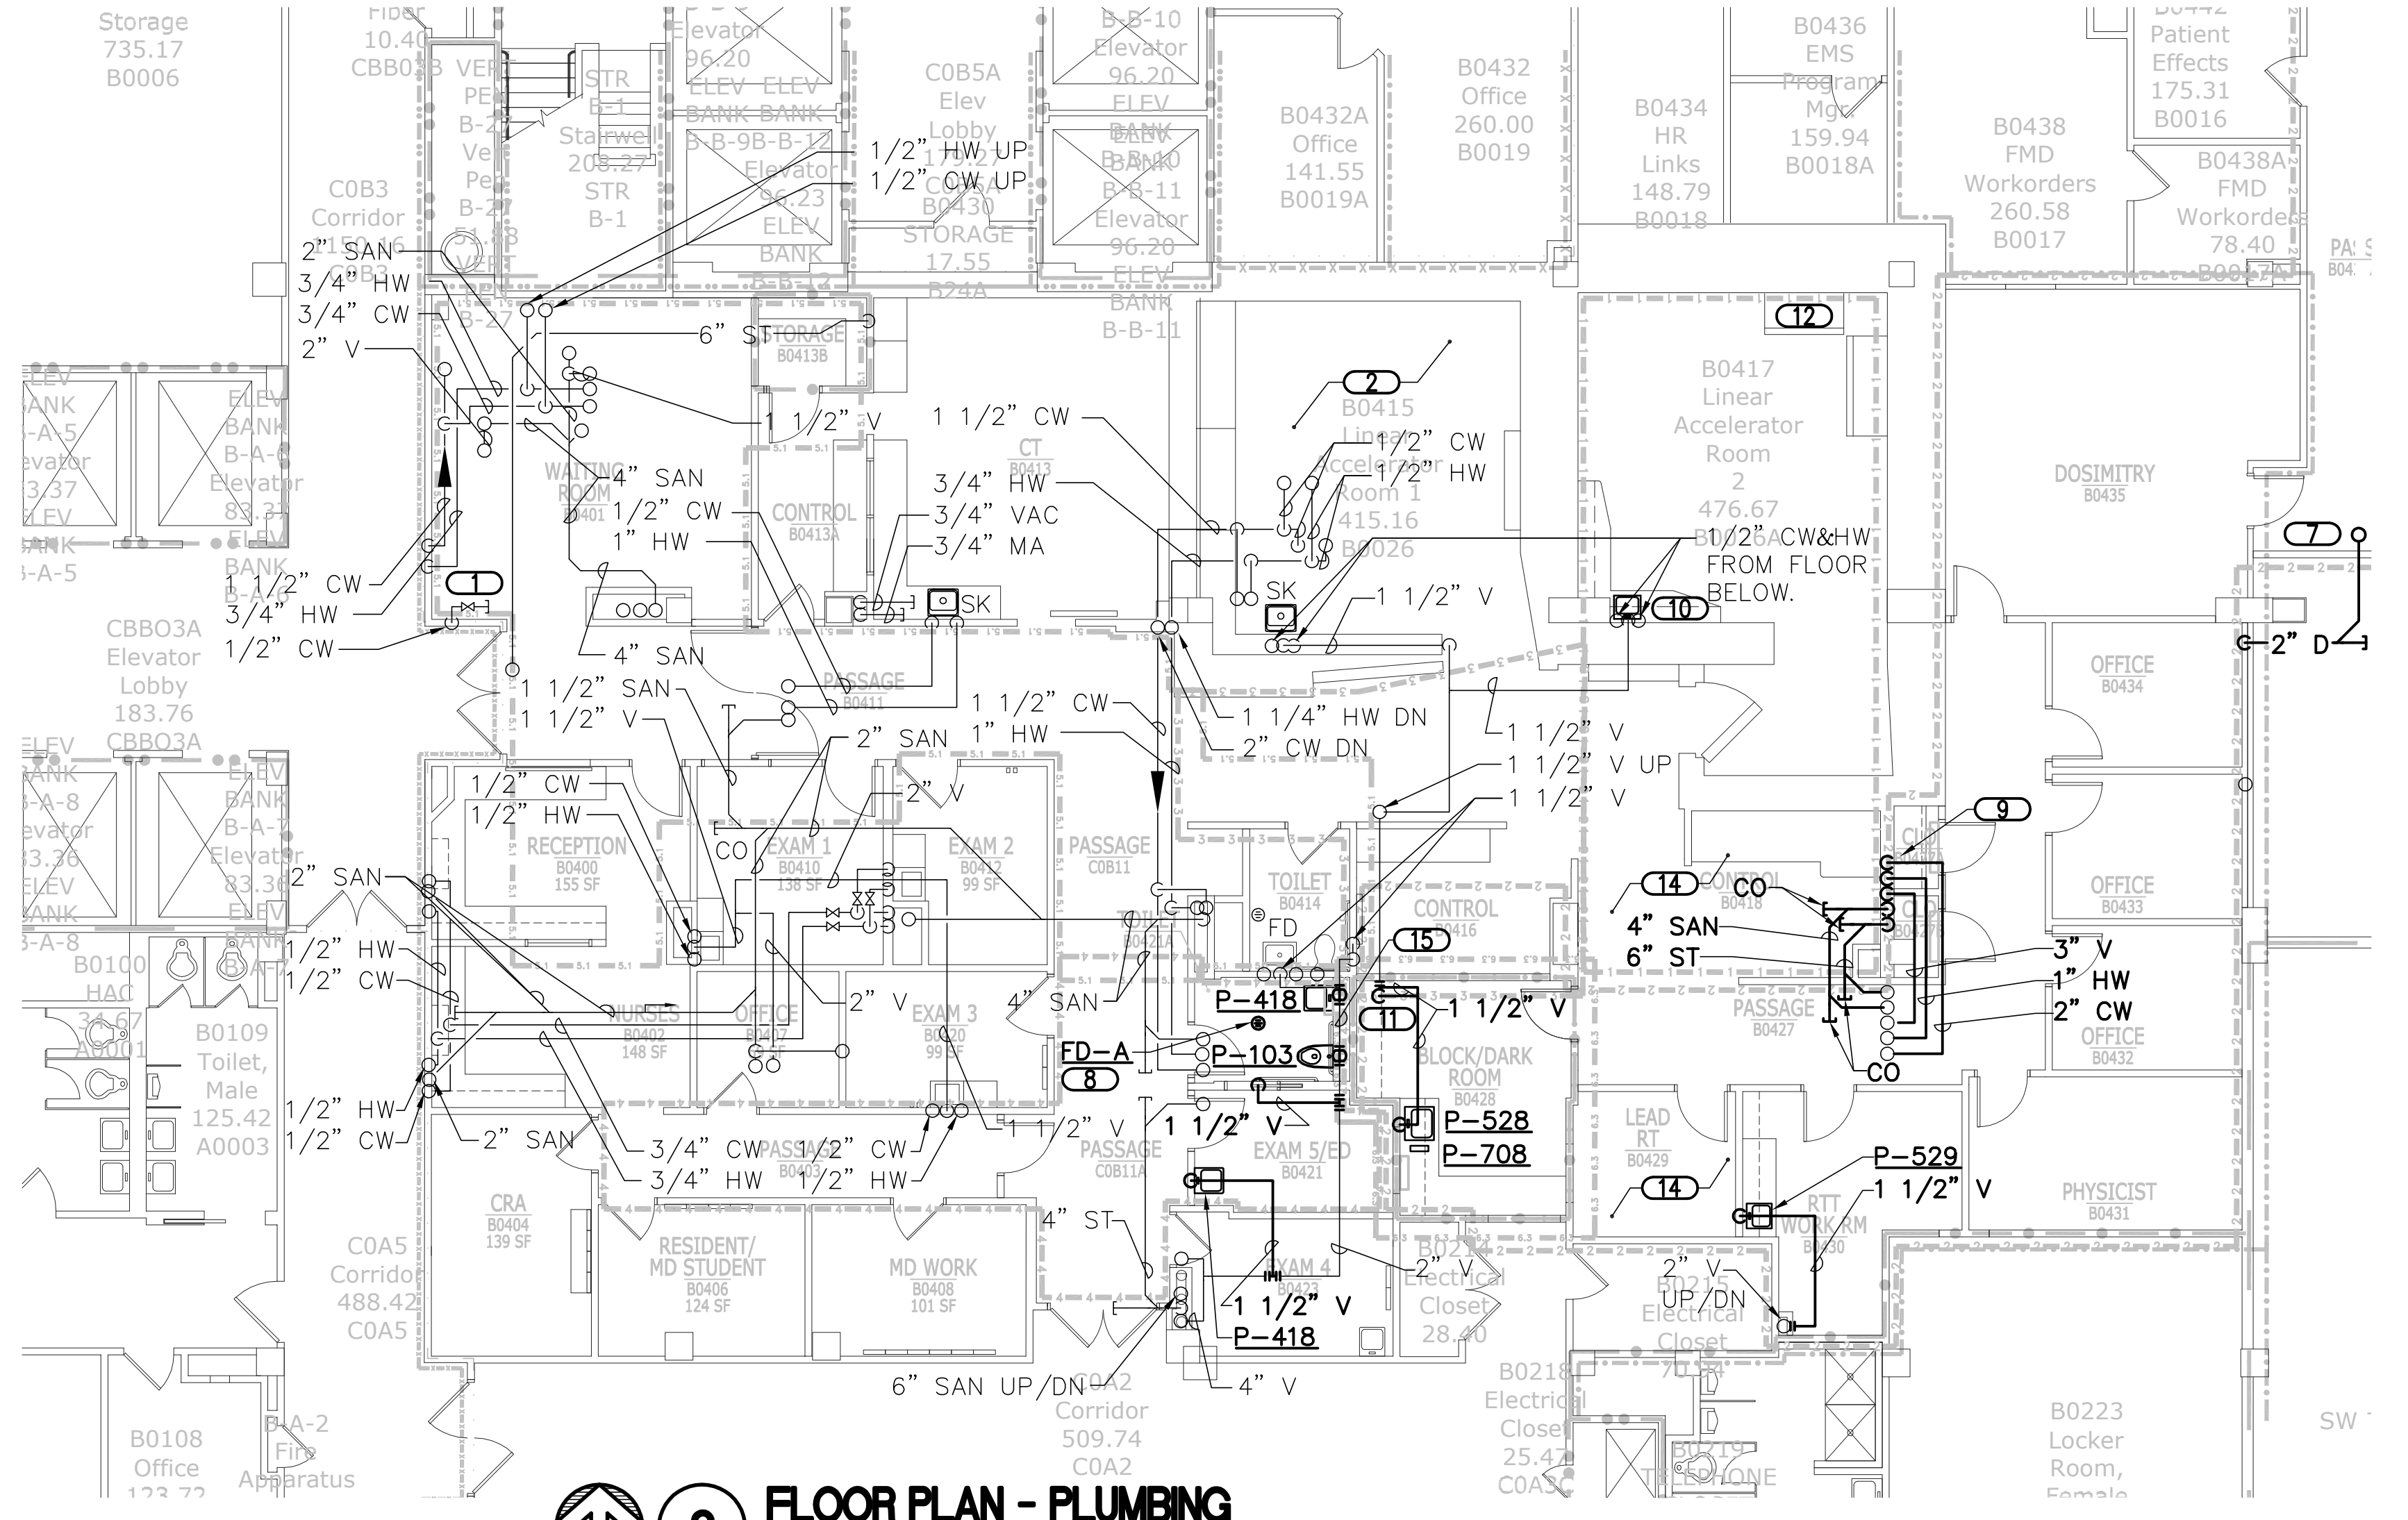

2 FLOOR PLAN - PLUMBING
SCALE: 1/8"=1'-0"

DEMOLITION PHASE LINETYPE KEY	
PHASE 1 DEMOLITION WORK	---
PHASE 2 DEMOLITION WORK	---
PHASE 3 DEMOLITION WORK	---
PHASE 4 DEMOLITION WORK	---
PHASE 5 DEMOLITION WORK	---
PHASE 6 DEMOLITION WORK	---
NEW WORK PHASE LINETYPE KEY	
PHASE 1 NEW WORK	---
PHASE 2 NEW WORK	---
PHASE 3 NEW WORK	---
PHASE 4 NEW WORK	---
PHASE 5 NEW WORK	---
PHASE 6 NEW WORK	---
FIRE / SMOKE BARRIER DESIGNATIONS	
THE SYMBOLS SHOWN ARE FOR THE CONVENIENCE OF THE CONTRACTOR. THE CONTRACTOR SHALL VERIFY RATINGS WITH THE LATEST SET OF ARCHITECTURAL PLANS AND FURNISH ALL MATERIALS REQUIRED TO COMPLY WITH THOSE RATINGS WHETHER SHOWN OR NOT.	
ALL FLOOR ASSEMBLIES SHALL BE DESIGNATED AS 2 HOUR FIRE/SMOKE BARRIERS, UNLESS NOTED OTHERWISE ON THE PLANS. RATINGS WERE ACQUIRED FROM THE ARCHITECTURAL PLANS DATED 04/02/2012.	
1 HOUR FIRE BARRIER	---
2 HOUR FIRE BARRIER	---
1 HOUR FIRE/SMOKE BARRIER	---
2 HOUR FIRE/SMOKE BARRIER	---

PLUMBING SYMBOLS LIST		PLUMBING SYMBOLS LIST	
SYMBOL:	DESCRIPTION:	SYMBOL:	DESCRIPTION:
---	EXISTING TO REMAIN	□	SINGLE GAS OUTLET (OXYGEN)
---	EXISTING TO BE REMOVED	▽	SINGLE GAS OUTLET (VACUUM)
---	NEW	EE	EMERGENCY EYEWASH
—CW—	COLD WATER — POTABLE	HD	HUB DRAIN
—D—	DRAIN LINE	LAV	LAVATORY
—HW—	HOT WATER — POTABLE	MC	MECHANICAL CONTRACTOR
—HWC—	HOT WATER CIRCULATING — POTABLE	SK	SINK
—MA—	MEDICAL AIR	WC	WATER CLOSET
—NO—	NITROUS OXIDE		
—O—	OXYGEN		
—SAN—	SANITARY DRAINAGE		
—ST—	STORM DRAINAGE		
—VAC—	MEDICAL VACUUM		
—V—	VENT		
—	PIPE CAP		
—	PIPE DOWN		
—	PIPE UP OR UP/DOWN		
—	PIPE SERVING FIXTURE ON FLOOR ABOVE. (EXAMPLE: FD = FLOOR DRAIN)		
—	PITCH PIPE IN DIRECTION		
—	DIRECTION OF FLOW IN PIPE		
—	NEW CONNECTION		
—	SHUTOFF VALVE NORMALLY OPEN		
—0.5	BALANCING VALVE (NO. INDICATES GPM)		
—A	SINGLE GAS OUTLET (AIR)		

KEYNOTES	GENERAL NOTES
8. REFER TO 2/P500 FOR NEW FLOOR DRAIN IN EXISTING FLOOR DETAIL.	1. REFER TO P500 FOR GENERAL PLUMBING NOTES.
9. RELOCATE RISERS IN WALL SHOWN. MAKE HORIZONTAL OFFSETS ABOVE CEILING AND BELOW FLOOR TO RE-CONNECT WITH EXISTING PIPING. FIELD VERIFY EXACT LOCATIONS AND SIZES.	2. WORK SHALL BE COMPLETED IN PHASES IDENTIFIED ON THESE DRAWINGS. REFER TO ARCHITECTURAL PHASING DRAWINGS FOR ADDITIONAL INFORMATION. PROVIDE TEMPORARY PROVISIONS TO ACCOMMODATE PHASED CONSTRUCTION WHERE UTILITIES CROSS PHASING BOUNDARIES.
10. PROVIDE NEW SINK IN CASEWORK AND RECONNECT EXISTING PIPING. SINK SHALL MATCH P-528 DESCRIPTION. FINAL SINK SIZE SHALL BE VERIFIED WITH CASEWORK DIMENSIONS PRIOR TO ORDERING.	3. REFER TO 1/P500 FOR PIPE HANGERS DETAIL AND 3/P500 FOR PIPE PENETRATIONS DETAIL.
11. MAKE 3/4" CW AND 1" DRAIN CONNECTIONS TO TABLE-TOP SRX-101A PROCESSOR. FIELD VERIFY FINAL LOCATION. PROVIDE 4" HUB DRAIN IN FLOOR AND ROUTE DRAIN PIPING TO HUB DRAIN. COORDINATE FINAL HUB DRAIN LOCATION WITH OWNER-PROVIDED EQUIPMENT.	
12. PROVIDE 1" CW AND 2" DRAIN CONNECTIONS FROM BELOW TO SIEMENS TRANSFER STATION FOR EMERGENCY COOLING BACKUP. PROVIDE ALL PRESSURE REGULATORS, VALVES, PRESSURE GAUGES, FILTERS, AND BACKFLOW PREVENTERS AS REQUIRED BY SIEMENS DRAWING M-101. REFER TO SIEMENS DRAWING M-101 FOR MORE INFORMATION. COORDINATE FINAL TRANSFER STATION LOCATION WITH SIEMENS.	
13. TEMPORARILY VALVE/ CAP AT PHASING BOUNDARY.	
14. EXISTING OXYGEN AND NITROUS OXIDE MEDICAL GAS PIPING IN CEILING SPACE SHALL BE REMOVED AND RELOCATED TO ACCOMMODATE MEP WORK IN CEILING SPACE. EXACT LOCATION AND ROUTING OF PIPING SHALL BE FIELD-VERIFIED. THIS CONTRACTOR SHALL REMOVE AND RELOCATE 100'-0" OF 2" OXYGEN & 1-1/2" OF NITROUS OXIDE PIPING. ASSUME THREE SEPARATE SHUT-DOWNS AND MED GAS CERTIFICATIONS.	
15. RELOCATE EXISTING 2" V PIPING AS NECESSARY TO ACCOMMODATE NEW WALL.	

KEYNOTES	
1. EXISTING 1/2" CW COFFEE MAKER CONNECTION SHALL REMAIN. TEMPORARILY REMOVE AND RECONNECT COFFEE MAKER TO ACCOMMODATE CONSTRUCTION ACTIVITIES.	
2. ALL PLUMBING CONNECTIONS TO EXISTING MEDICAL EQUIPMENT WITHIN THIS ROOM SHALL REMAIN.	
3. REMOVE CONNECTION TO EXISTING COOLING TABLE AND ALL RELATED ACCESSORIES, INCLUDING SOLENOID VALVE, STANDPIPE, BACKFLOW PREVENTER, SHUT-OFF VALVES, ETC.	
4. REMOVE ALL DARK ROOM PLUMBING CONNECTIONS AND ACCESSORIES, INCLUDING FLOOR DRAIN, MIXING VALVE, VACUUM BREAKER, PROCESSOR, ETC.	
5. REMOVE 1" CW AND 1" SAN CONNECTION TO EXISTING LINAC EQUIPMENT. REFER TO 1/P100 FOR EXTENT OF DEMOLITION SCOPE IN THE SUB-BASEMENT.	
6. REMOVE 1" CW, FILTER SYSTEM, CONNECTION TO LINAC EQUIPMENT, AND ALL RELATED ACCESSORIES. REFER TO 1/P100 FOR EXTENT OF DEMOLITION SCOPE IN THE SUB-BASEMENT.	
7. PROVIDE 2" DRAIN CONNECTION TO FCU. COORDINATE EXACT LOCATION WITH MC.	

Amendment No. 3 09/05/12

CONSULTANTS:

KJWW ENGINEERING CONSULTANTS
802 WEST BROADWAY, SUITE 312
MILWAUKEE, WISCONSIN 53212-1031
808.223.9600 FAX: 808.223.9601
www.kjww.com PROJECT #11 0871.00
KJWW ENGINEERING RESERVES PROPRIETARY RIGHTS, INCLUDING COPYRIGHTS, TO THIS DRAWING AND THE DATA SHOWN THEREON. NO REUSE OR REPRODUCTION OF THIS DRAWING OR DATA ARE THE EXCLUSIVE PROPERTY OF KJWW ENGINEERING AND SHALL NOT BE USED OR REPRODUCED FOR ANY OTHER PROJECT WITHOUT THE EXPRESS WRITTEN APPROVAL AND PARTICIPATION OF KJWW ENGINEERING. ©2012 KJWW, P.C.

PROJECT LOCATION

ARCHITECT:

Intelligent Designs
11000 West Park Place • Milwaukee WI 53224 • Tel 414 359-3060 • Fax 414 359-3070
www.prarch.com PRA Job No. R100077-10

Drawing Title
FLOOR PLANS - PLUMBING

Approved Project Director

Project Title
Building 111 - Radiation Oncology Expansion

Location
VA Medical Center, Milwaukee, WI

Date
20 August 2012

Checked
MJL

Drawn
DAS

Project Number
695-10-131

Building Number
111

Drawing Number
P101

Dwg. 2 of 3

Office of Construction and Facilities Management

FULLY SPRINKLERED