

PROJECT NO.: BUILDING: 320 - PHASE 4	POINT LEGEND		SYSTEM OUTPUTS		SYSTEM INPUTS		SYSTEM SOFTWARE/CONTROL														PAGE: 2	
			BINARY	ANALOG	BINARY	ANALOG	ALARM PROCESSING	
			START/STOP	OPEN/CLOSE	SPEED COMMAND	VALVE POSITION	DAMPER POSITION	STATUS	ALARM	PRESSURE	HIGH HUMIDITY	HIGH STATIC PRESSURE	LOW TEMPERATURE	TEMPERATURE (TI)	POSITION	FLOW	PERCENT	STATIC PRESSURE	CARBON MONOXIDE	HUMIDITY		VACUUM	LOCAL ALARM PANEL	AREA ALARM PANEL	MASTER ALARM PANEL	HIGH LIMIT	LOW LIMIT	UNIT STATUS	SCHEDULE START/STOP	FUNCTION	DUTY CYCLE	TEMPERATURE ECONOMIZER	TEMPERATURE LIMIT	TEMPERATURE RESET	DEMAND LIMITING	TEMPERATURE OVERRIDE	STATIC PRESSURE RESET	PRESSURE/VOLUME CONTROL	SPACE TEMPERATURE CONTROL	FULL COMMUNICATION	TRENDING	GRAPHICS	REMARKS	
SYSTEM COMPONENT:	POINT ID	ABBREVIATION	PRIORITY/ADD - ALTERNATE NO.	ELECTRIC DEVICE	START/STOP	OPEN/CLOSE	SPEED COMMAND	VALVE POSITION	DAMPER POSITION	STATUS	ALARM	PRESSURE	HIGH HUMIDITY	HIGH STATIC PRESSURE	LOW TEMPERATURE	TEMPERATURE (TI)	POSITION	FLOW	PERCENT	STATIC PRESSURE	CARBON MONOXIDE	HUMIDITY	VACUUM	LOCAL ALARM PANEL	AREA ALARM PANEL	MASTER ALARM PANEL	HIGH LIMIT	LOW LIMIT	UNIT STATUS	SCHEDULE START/STOP	FUNCTION	DUTY CYCLE	TEMPERATURE ECONOMIZER	TEMPERATURE LIMIT	TEMPERATURE RESET	DEMAND LIMITING	TEMPERATURE OVERRIDE	STATIC PRESSURE RESET	PRESSURE/VOLUME CONTROL	SPACE TEMPERATURE CONTROL	FULL COMMUNICATION	TRENDING	GRAPHICS	REMARKS	
CHILLED WATER TEMPERATURES	


### POINTS LIST FOR HEAT EXCHANGER, HOT WATER SYSTEM, AND CHILLED WATER SYSTEM

NTS

PROJECT NO.: BUILDING: 320 - PHASE 4		POINT LEGEND		SYSTEM OUTPUTS		SYSTEM INPUTS				SYSTEM SOFTWARE/CONTROL												PAGE: 3	
SYSTEM:  FANS		POINT ID	ABBREVIATION	PRIORITY/ADD - ALTERNATE NO.	BINARY	ANALOG	BINARY	ANALOG			ALARM PROCESSING			APPLICATION/FUNCTION						REMARKS	
SYSTEM COMPONENT:					START/STOP	OPEN/CLOSE	SPEED COMMAND	VALVE POSITION	DAMPER POSITION	ALARM	PRESSURE	HIGH HUMIDITY	HIGH STATIC PRESSURE	LOW TEMPERATURE	MOD END SWITCH	TEMPERATURE (Ti)	TEMPERATURE (To)	POSITION	FLOW		PERCENT	STATIC PRESSURE	CARBON MONOXIDE	HUMIDITY	VACUUM	AREA ALARM PANEL	MASTER ALARM PANEL	LOW LIMIT	HIGH LIMIT	STATUS	SCHEDULE START/STOP	FUNCTION	DUTY CYCLE	TEMPERATURE ECONOMIZER	ENTHALPY ECONOMIZER	TEMPERATURE RESET	DEMAND LIMITING	TEMPERATURE OVERIDE	STATIC PRESSURE RESET	PRESSURE/VOLUME CONTROL	FAILURE MODE	SPACE TEMPERATURE CONTROL	FULL COMMUNICATION	TRENDING	GRAPHICS	
EXHAUST FAN 320-EF1		BO-5/BI-18	320-EF1-SST	


### POINTS LIST FOR FANS

NTS

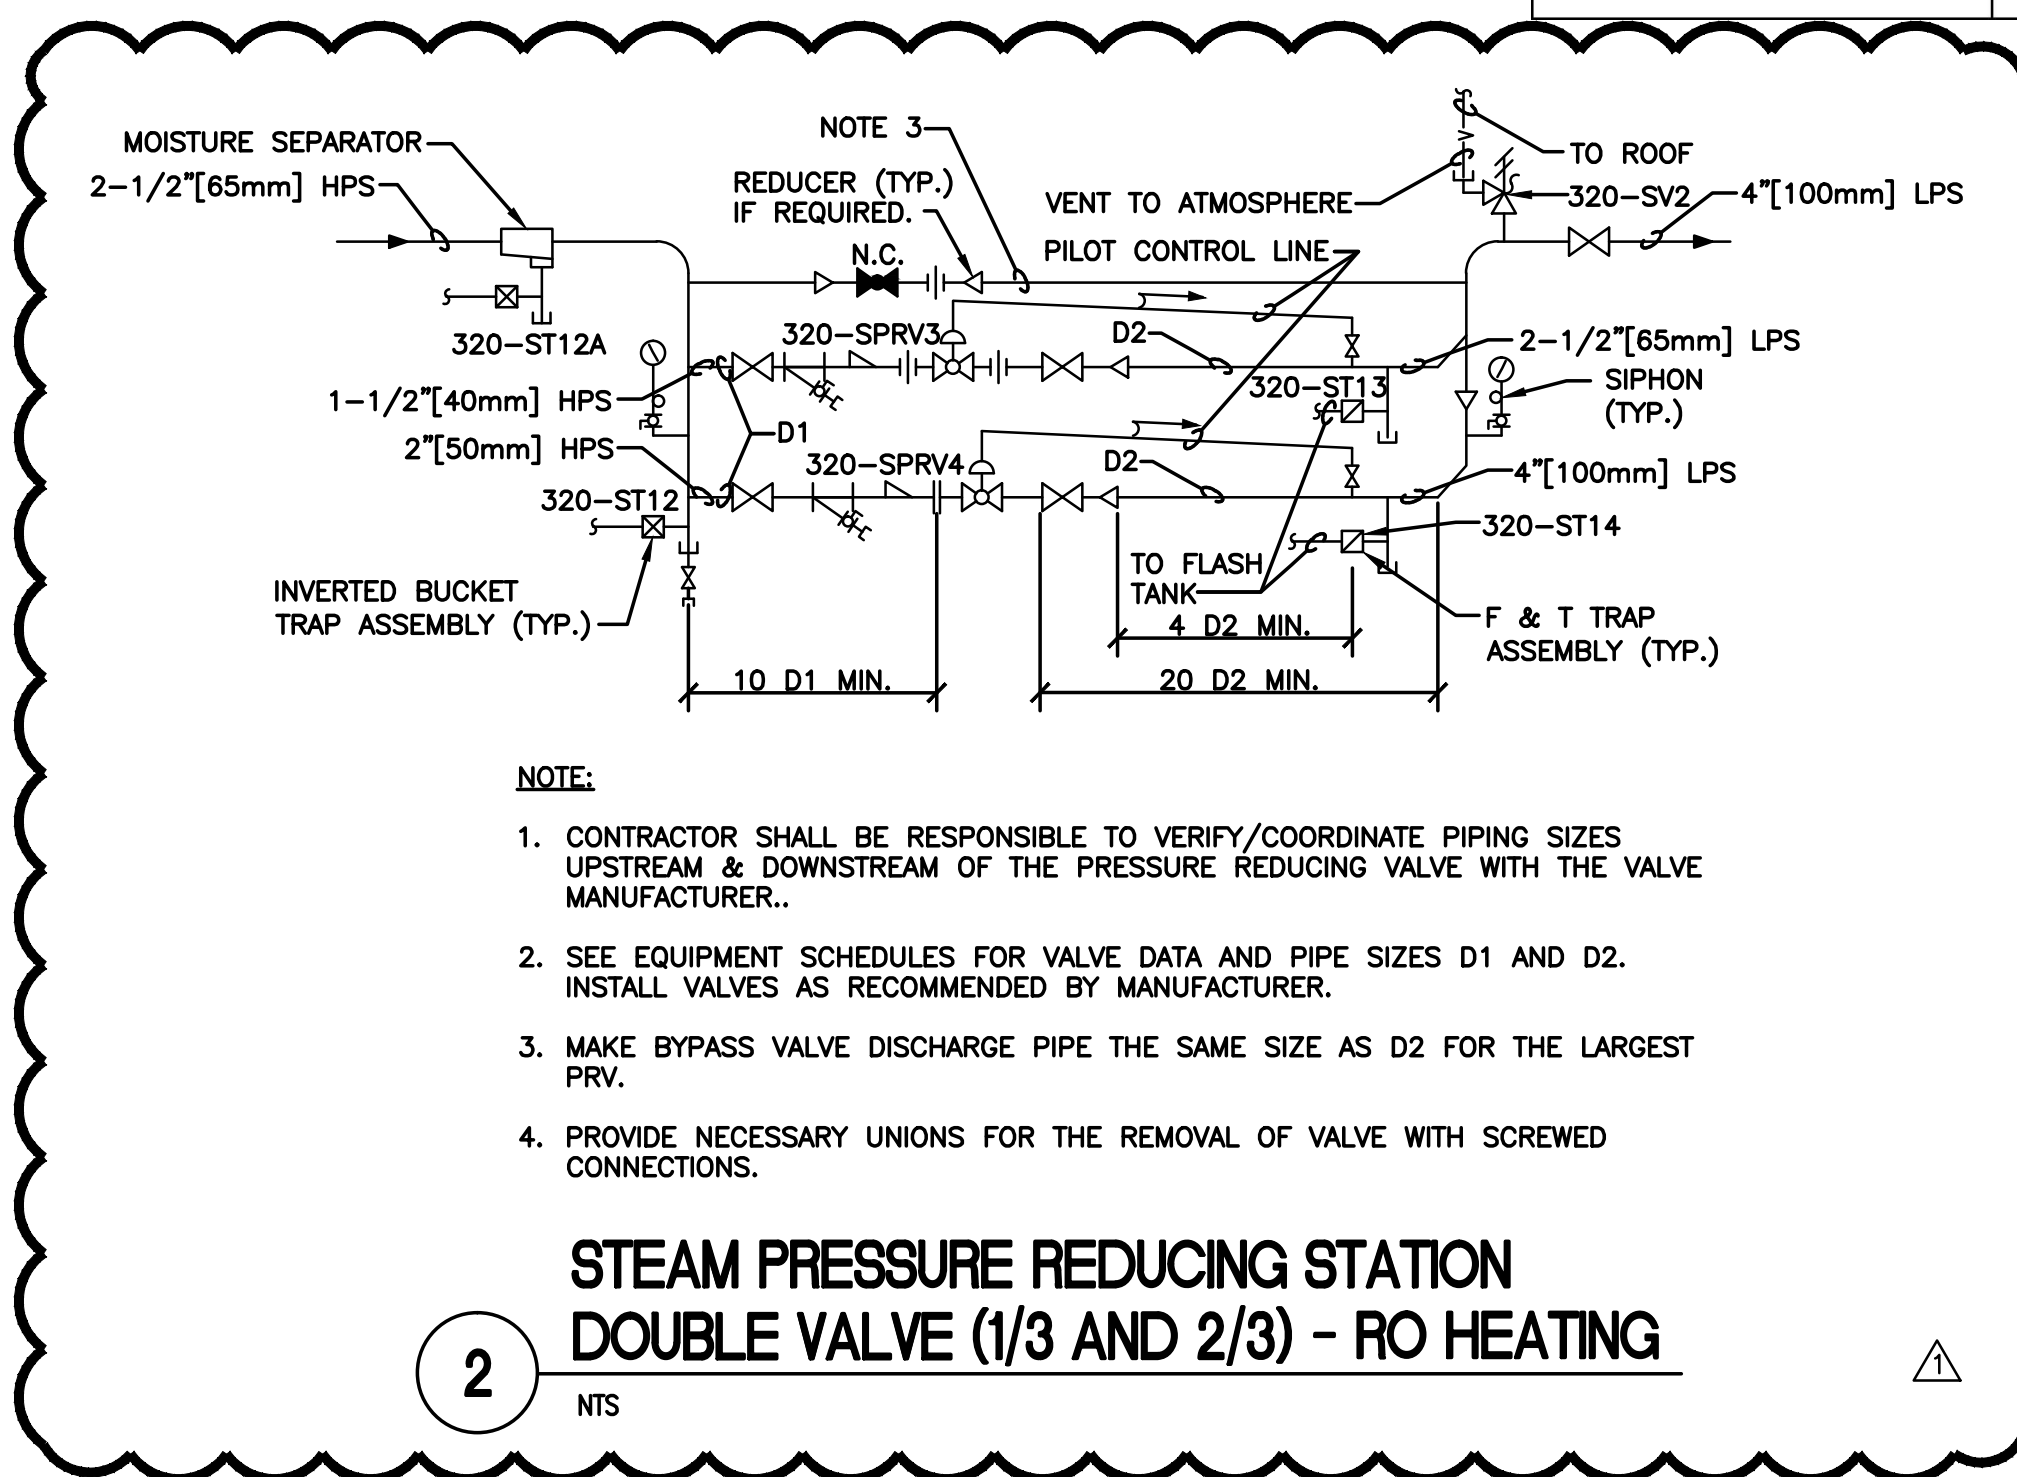

### POINTS LIST FOR VAV AIR HANDLING UNIT WITH ECONOMIZER

NTS

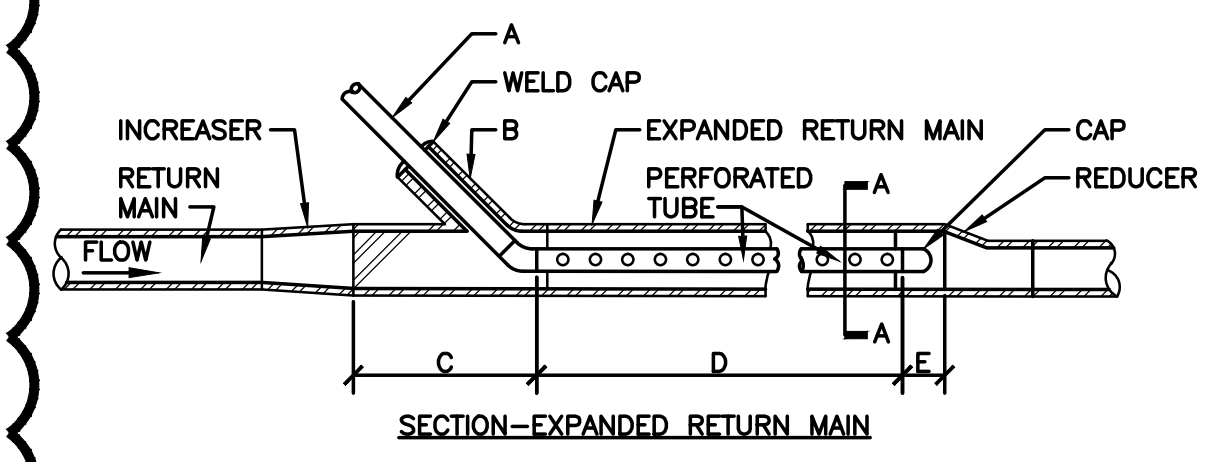

A SIZE, TRAP DISCHARGE LINE	1/2" [15mm]	3/4" [20mm]
B SIZE, 45° WELDING NIPPLE	1" [25mm]	1-1/4" [32mm]
C LENGTH OF EXPANDED MAIN AHEAD OF TRAP DISCHARGE PIPE	7" [175mm]	7" [175mm]
D LENGTH OF PERFORATED PIPE	16-1/2" [415mm]	16-1/2" [415mm]
E LENGTH OF EXPANDED MAIN OF FOLLOWING PERFORATED PIPE	2" [50mm]	2" [50mm]
RETURN MAIN SIZE UP TO 1-1/2" [40mm]	2" [50mm]	3" [75mm] & OVER
EXPANDED RETURN MAIN SIZE	2-1/2" [65mm]	SAME SIZE

- NOTES:  
1. 1/2" [15mm] PERFORATED TUBE SHALL HAVE 40 - 1/8" [16mm] DIAMETER HOLES SPACED 1-1/2" [40mm] O.C. IN 4 ROWS.  
2. 3/4" [20mm] PERFORATED TUBE SHALL HAVE 78 - 1/8" [6mm] DIAMETER HOLES SPACED 1-1/2" [40mm] O.C. IN 6 ROWS.  
3. HOLES IN TUBE SHALL BE SPACED EQUALLY AROUND PERIMETER.

### HIGH AND MEDIUM PRESSURE STEAM TRAP DISCHARGE INTO PUMPED CONDENSATE RETURN LINE

NTS

CONSULTANTS:  
**Barton Associates.**  
Consulting Engineers  
Susquehanna Commerce Center  
North Building  
221 West Philadelphia Street  
York, PA 17401  
Tel: (717) 846-7824  
Web: www.bac-inc.com  
**We Make Buildings Work.**

PROJECT No. 2011130.01  
DATE 9.04.12  
REVISIONS

YORK | HARRISBURG | STATE COLLEGE  
DRAWN BY: RGG  
DESIGNED BY: JRA  
CHECKED BY: DJB

ARCHITECT/ENGINEERS:  
**SAA architects**

Drawing Title  
DETAILS AND CONTROLS POINTS LISTS  
Approved Project Director

Project Title  
BOILER PLANT UPGRADE  
PHASE IV  
Location  
VAMC MARTINSBURG, WV  
Date 5.31.12  
Checked  
Drawn

Project Number  
613-12-401  
Building Number  
320  
Drawing Number  
320-M504  
Dwg. of--  
Office of Construction and Facilities Management  
Department of Veterans Affairs

VA FORM 08-6231