
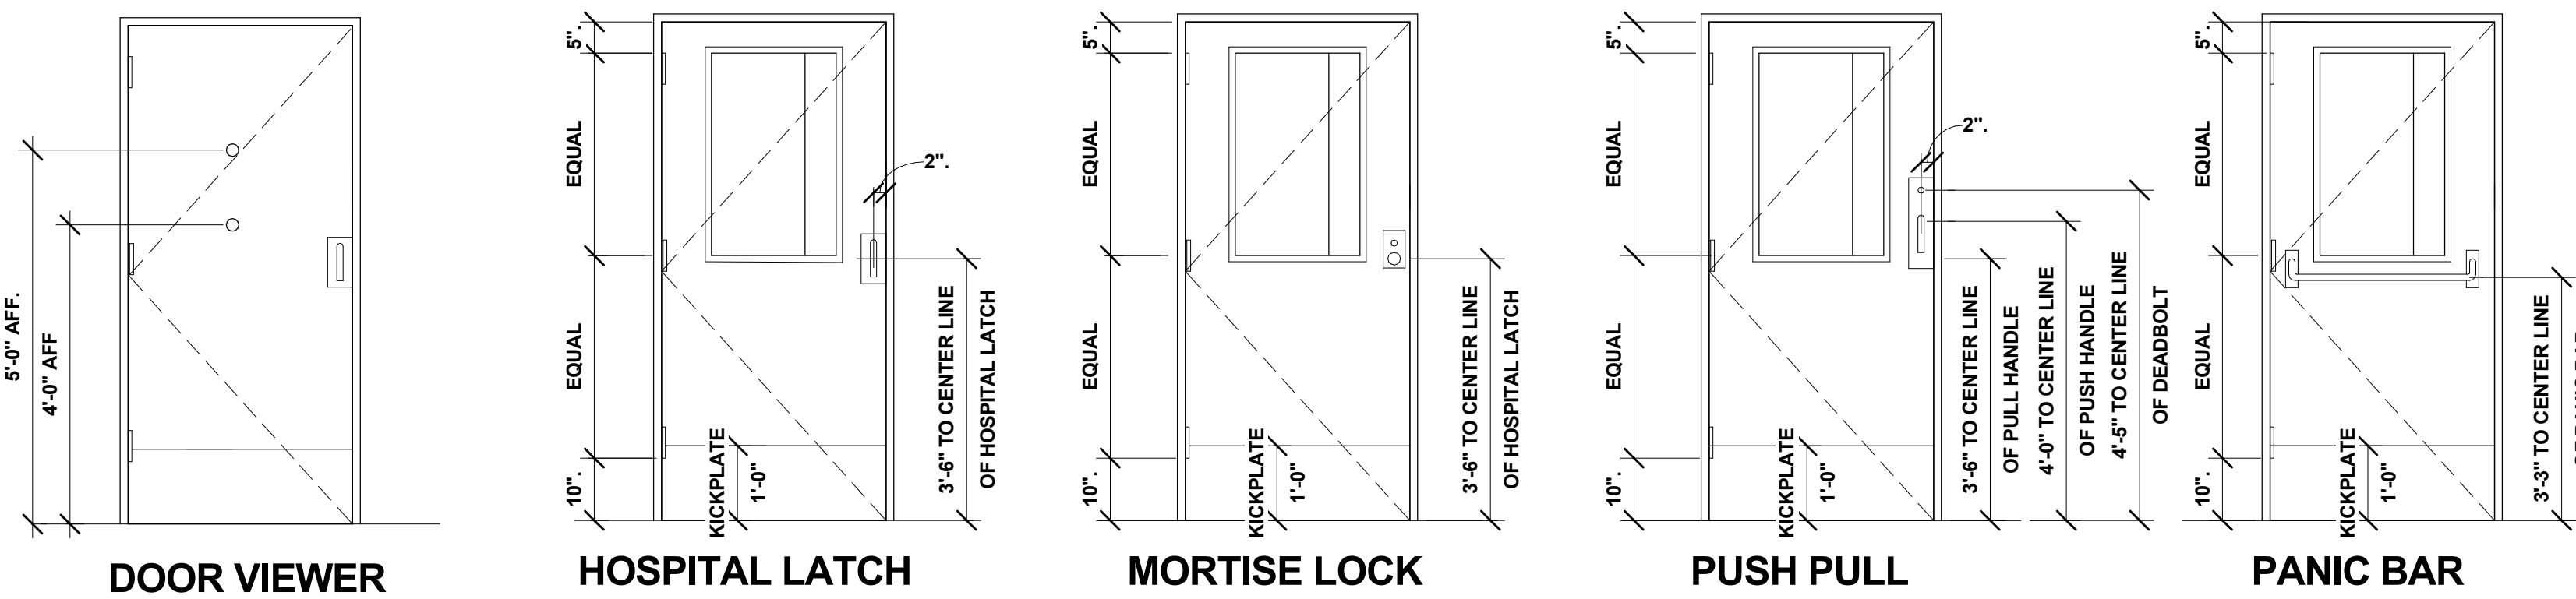
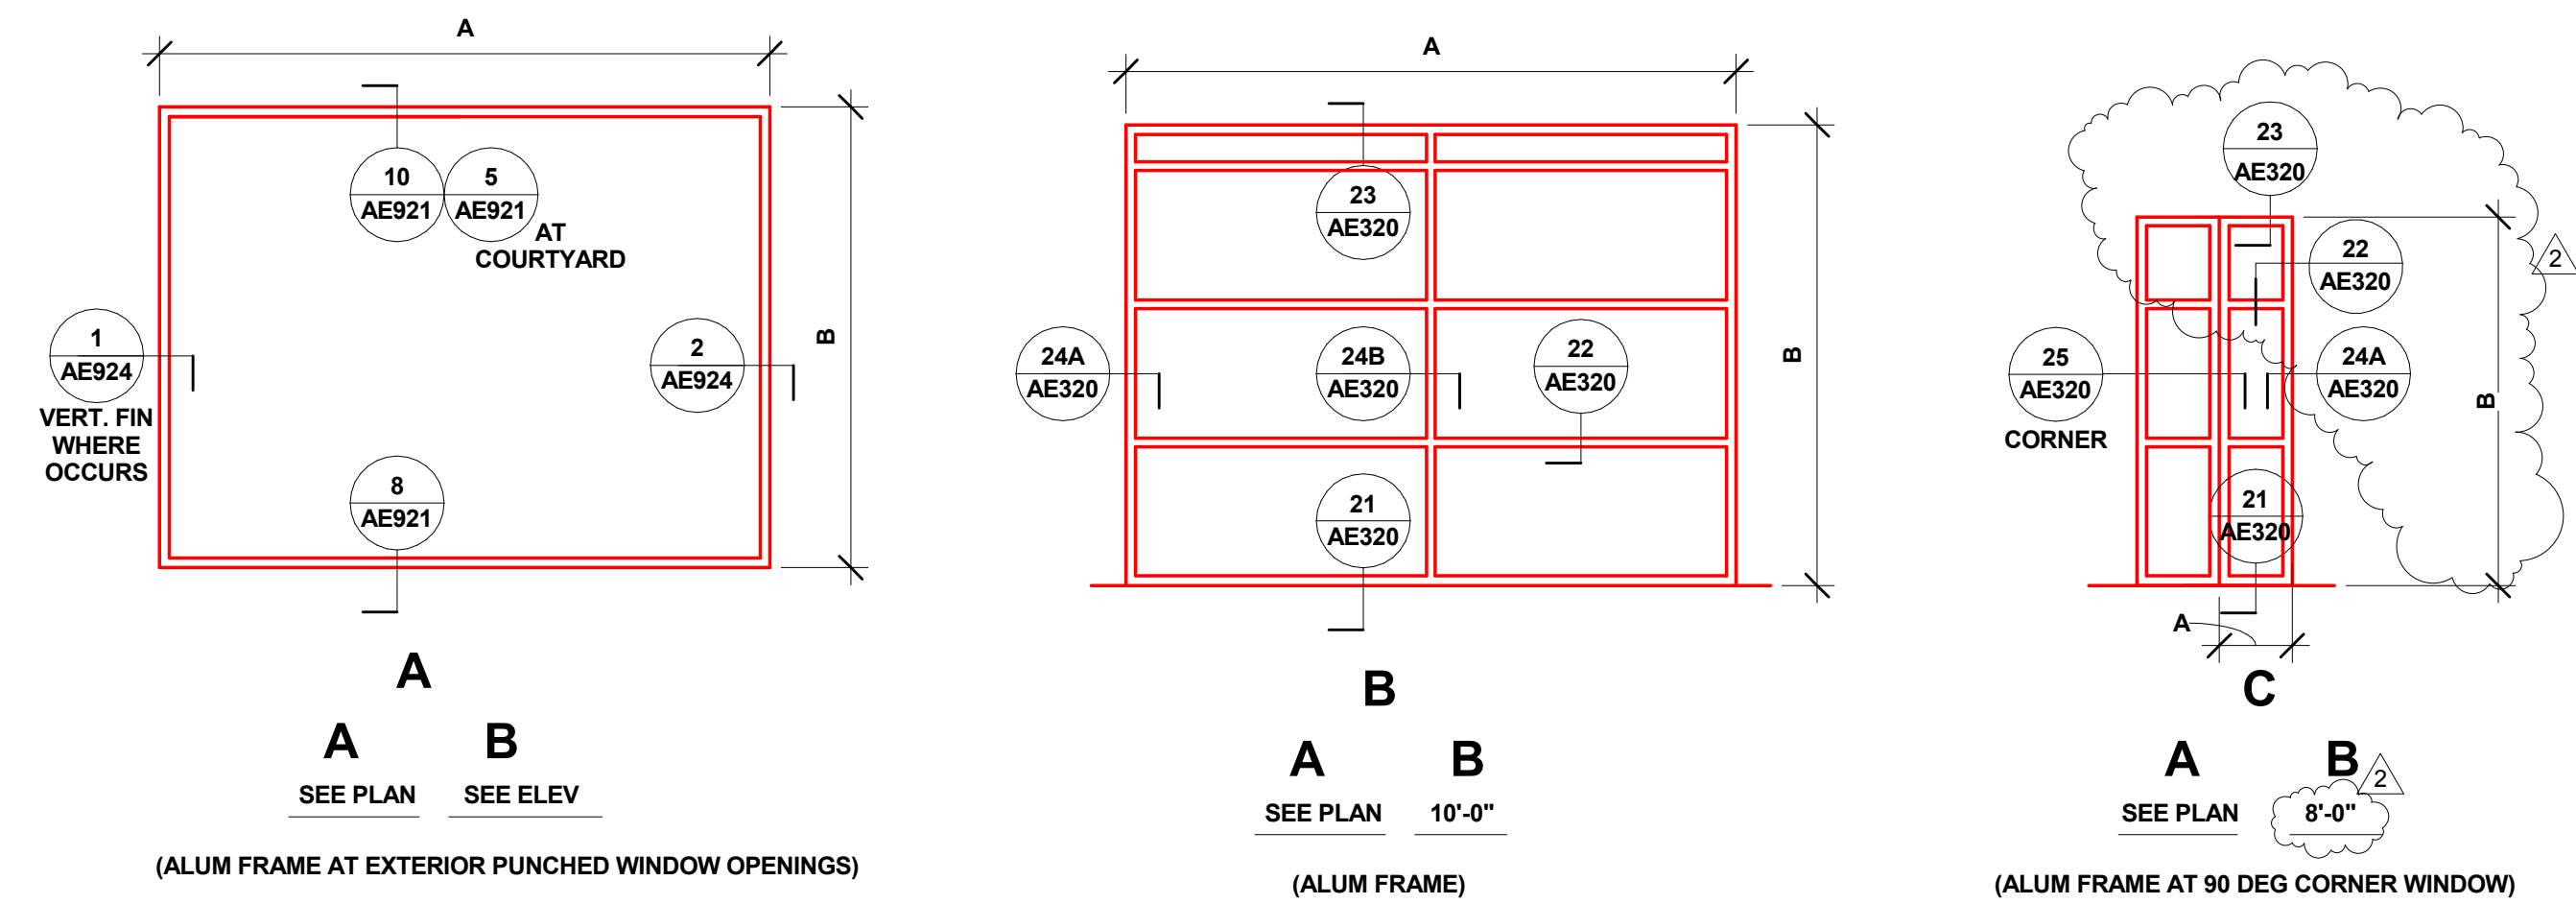


HARDWARE MOUNTING HEIGHT

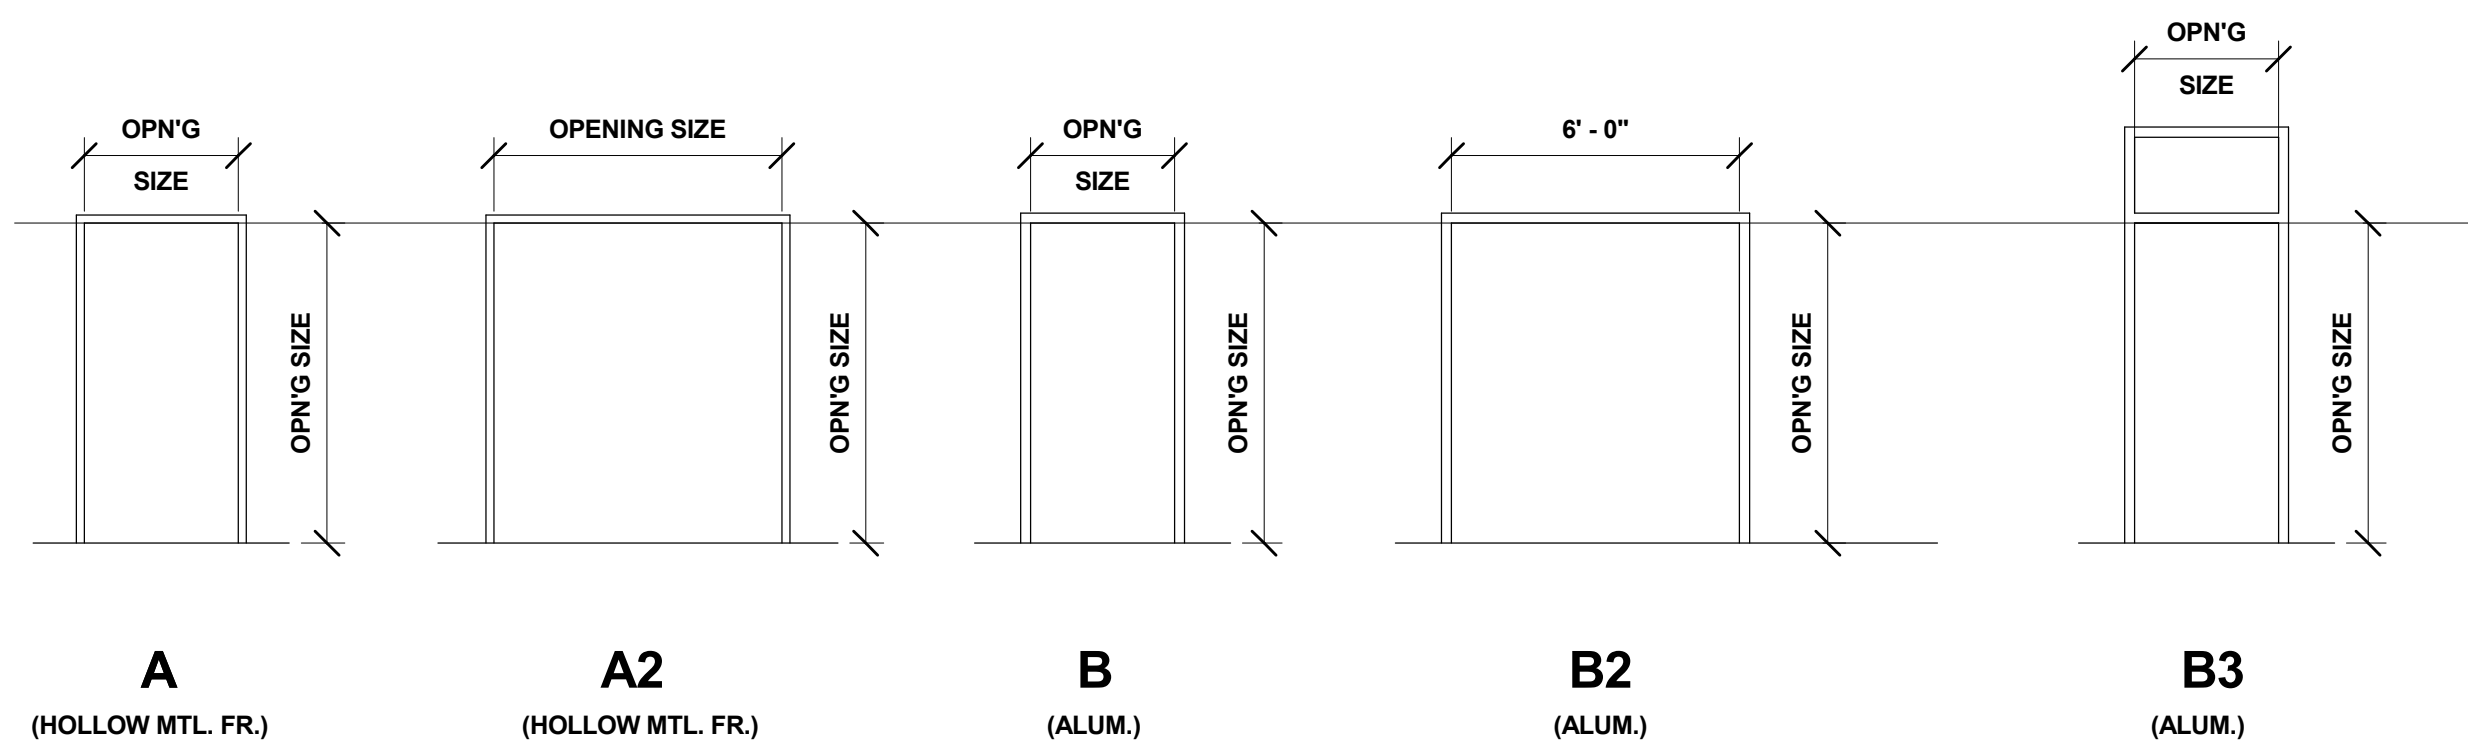

<u>2</u>	AMENDMENT 2	9/6/12
Revisions		Date

Consultants


COLLABORATIVE
DESIGN
STUDIO *architecture of experience and place*

www.collaborativedesignstudio.com
T 775.348.7777 F 775.348.0904
9444 DOUBLE R BLVD SUITE B | RENO NV 89521

Reviewing Agency - Fire Protection

AON

Fire Protection Engineering
Aon Fire Protection Engineering Corporation
11770 Bernardo Plaza Court | Suite 116 | San Diego, CA 92128
t + 1.658.673.6945 | f + 1.658.673.5849 | www.aonfire.com
Fire Protection | Code | Risk | Life Safety | Security

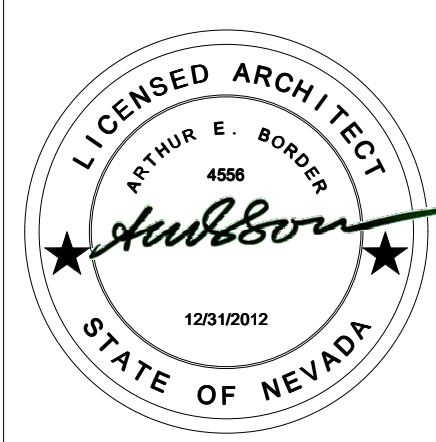


Architects/Engineers			
RBB ARCHITECTS INC 10980 Wilshire Boulevard Los Angeles, California 90024-3905 Telephone 310 473 3555 Facsimile 310 473 3555 www.rbbinc.com		917 7th St. 2nd Floor Ste. 3 Sacramento, California 95814 Telephone 310 473 3555 Facsimile 310 473 3555 www.rbbinc.com	

Drawing Title DOORS, FRAMES, HARDWARE, MOUNTING
Scale 1/4" = 1'-0"
Approved Project Director

Project Title VA RENO HEALTHCARE SYSTEM COMMUNITY LIVING CENTER EXPANSION		
Project No. #1017200	VA Contract No. VA261-P-0933	
Location 975 KIRMAN AVE., RENO, NV		
Date 06/01/2012	Checked RP	Drawn TC

VA Project No. 654-317
Building No.
Drawing No. AE310

**Office of
Construction and
Facilities
Management**

 **Department of
Veteran Affairs**