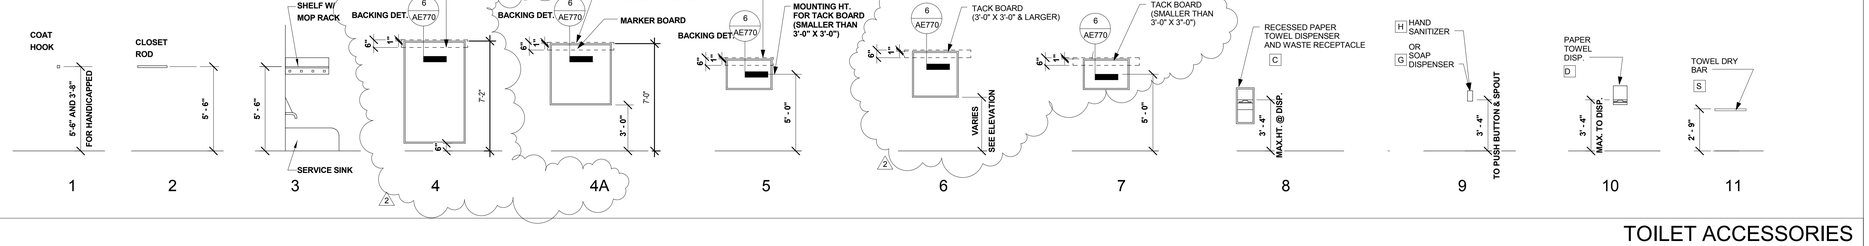

TOILET ACCESSORIES

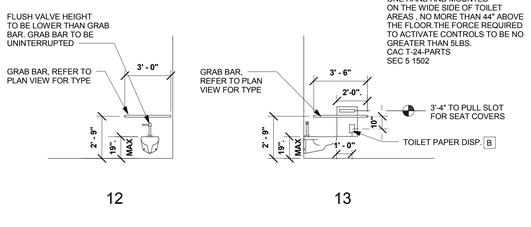

PUBLIC/STAFF TOILET-HANDICAP ACCESSIBLE

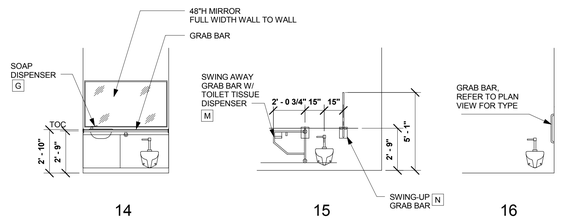

TOILET GRAB BARS

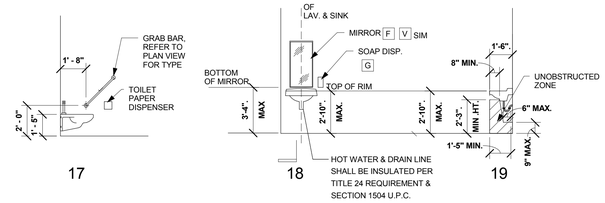

PATIENT ROOM TOILET

LAVATORY - WALL MTD.

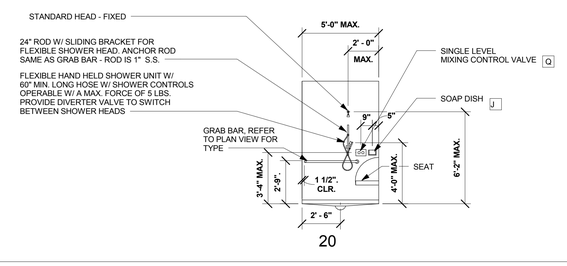

SHOWER - CERAMIC TILE HANDICAP ACCESSIBLE

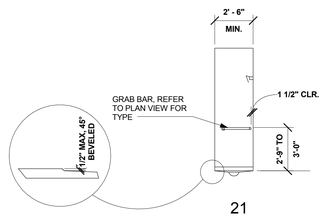

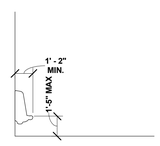

URINAL - WALL MTD.

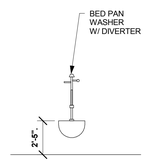

CLINIC SINK

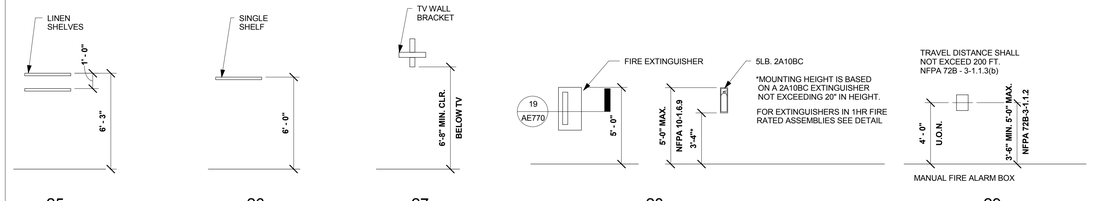

MOUNTING HEIGHT SCHEDULE

FIRE EXTIGUISHER CABINET

FIRE ALARM PULL BOX

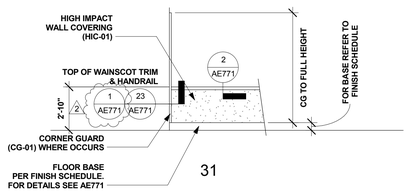

HIGH IMPACT WALL COVERING & CORNER GUARD

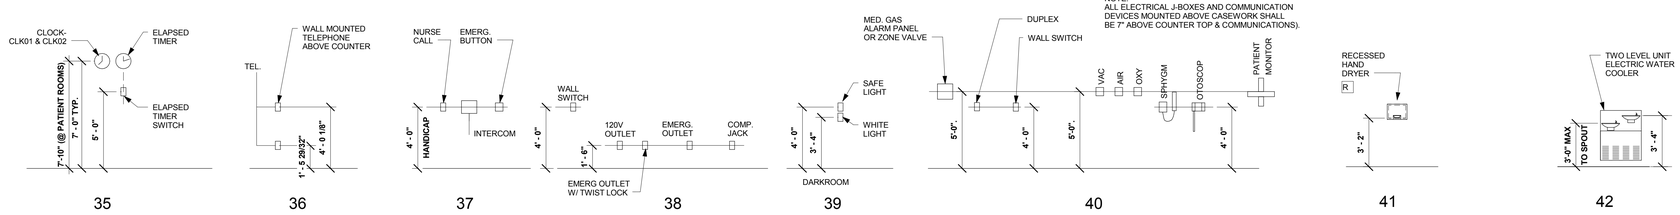

CLOCKS

TELEPHONE

COMMUNICATIONS

MEDICAL GASES

ELEC . DRYER

PUBLIC D.F.

GENERAL NOTES:

THE FOLLOWING NOTES SHALL APPLY TO ALL INTERIOR ELEVATIONS.

1. **PROVIDE BACKING PLATE FOR ALL WALL HUNG CABINETS, SEE DETAIL** 6 AE770
2. **FOR WALL HUNG AND FLOOR MOUNTED EQUIPMENTS, FIXTURES AND CASEWORK REQUIRING ANCHORAGE SEE SHEET** 6 AE770
3. **FOR GRAB BAR DETAIL, SEE** 10 AE771
4. **FOR TOILET ACCESSORY LOCATIONS, SEE ENLARGED FLOOR PLANS AE591 .**
5. **ALL TOILET ACCESSORIES LISTED MAY NOT OCCUR.**

Toilet Accessories Legend - See Spec section 090600 for Manuf./Model,/Finish/Color Basis of Design

Toilet Accessory Letter	Toilet Accessory Description
A	42" X 1 1/4" HORIZ. GRAB BAR +33" A.F.F.
B	RECESSED TOILET SEAT COVER DISPENSER, ROLL TOILET TISSUE DISPENSER W/ NAPKIN DISPOSAL AT FEMALE OR UNISEX TOILETS
C	RECESSED PAPER TOWEL DISPENSER
D	SURFACE MOUNTED PAPER TOWEL DISPENSER
E	1 1/4" HORIZ. GRAB BAR +33" A.F.F. FULL WIDTH OF ROOM WITH MODIFIED 2 1/2" RADIUS @ INTERMEDIATE SUPPORT AND WALL TO WALL END PLATE SUPPORTS
F	24" X 36" MIRROR W/ STAINLESS STEEL CHANNEL FRAME
G	SURFACE MOUNTED SOAP DISPENSER
H	SURFACE MOUNTED HAND SANITIZER
I	(2) SURFACE-MOUNTED SINGLE ROBE HOOKS MOUNTED AT 54" AND 72" AFF
J	RECESSED SOAP AND SHAMPOO HOLDER
K	24" X 1 1/4" HORIZ. GRAB BAR +33" A.F.F.
L	FLOOR DRAIN (6" CORE DRILLED)
M	29" X 1 1/4" HORIZ. SWING-UP GRAB BAR +33" A.F.F. W/ TOILET PAPER
N	29" X 1 1/4" HORIZ. SWING-UP GRAB BAR +33" A.F.F.
O	FOLDING SHOWER SEAT +18" AFF.
P	WASTE RECEPTACLE
Q	SHOWER HEAD CONTROLS AT 40" AFF
R	HANDRYER (+38" AFF @ B.O. OF R.O.).
S	24" X 1 1/4" HORIZ. TOWEL BAR +33" A.F.F.
T	DRINKING FOUNTAIN, REFER TO PLUMBING DWGS.
U	MIRROR FULL HEIGHT
V	12 X 18 RECESSED TOILETRY SHELF

Revisions	Date
2. AMENDMENT 2	9/6/12

Consultants

COLLABORATIVE DESIGN STUDIO architecture of experience and place
www.collaborativedesignstudio.com
T 775.348.7777 F 775.348.0904
9444 DOUBLE R BLVD SUITE B | RENO NV 89521

Reviewing Agency - Fire Protection

AON
Fire Protection Engineering
Aon Fire Protection Engineering Corporation
11770 Bernardo Plaza Court | Suite 116 | San Diego, CA 92128
t +1.858.673.5845 | f + 1.858.673.5849 | www.aonfpe.com
Fire Protection | Code | Risk | Life Safety | Security

LICENSED ARCHITECT ARTHUR E. BORDER 4556 12/31/2012 STATE OF NEVADA

Architects/Engineers

RBB ARCHITECTS INC
10980 Wilshire Boulevard
Los Angeles, California
90024-3905
Telephone 310 473 3555
Facsimile 310 473 3555
www.rbbinc.com

917 7th St. 2nd Floor Ste. 3
Sacramento, California
95814
Telephone 310 473 3555
Facsimile 310 473 3555
www.rbbinc.com

RBB

Drawing Title
TYPICAL MOUNTING HEIGHTS, TYPICAL TOILET ELEVATIONS & ACCESSORIES

Scale
1/4" = 1'-0"

Approved Project Director

Project Title
VA RENO HEALTHCARE SYSTEM COMMUNITY LIVING CENTER EXPANSION

Project No. #1017200
VA Contract No. VA261-P-0933

Location
975 KIRMAN AVE., RENO, NV

Date 06/01/2012
Checked RP
Drawn TC

VA Project No. 654-317
Building No.
Drawing No. AE710

Office of Construction and Facilities Management
Department of Veteran Affairs

BID DOCUMENTS