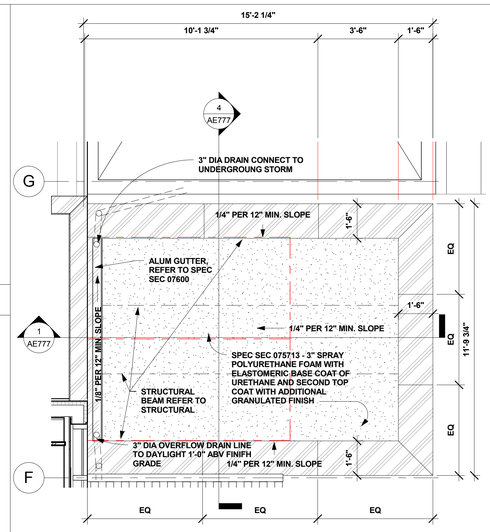

ALT. # 10

VESTIBULE ROOF PLAN | 3/8" = 1'-0" | 14

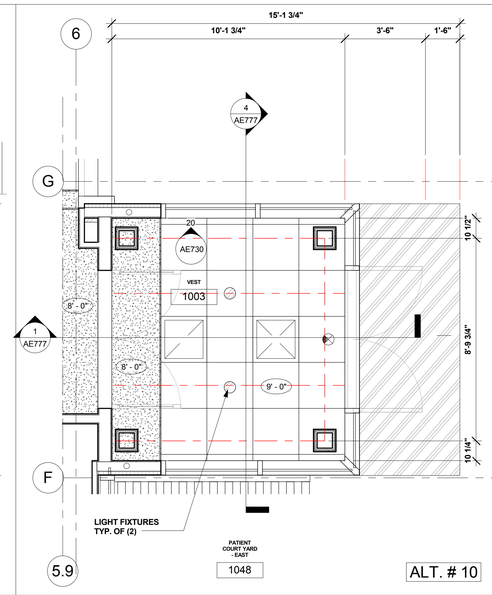

ALT. # 10

VESTIBULE CEILING PLAN | 3/8" = 1'-0" | 9

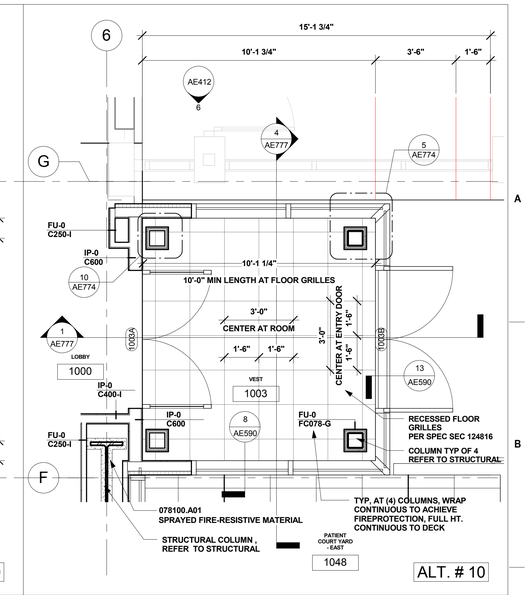

ALT. # 10

VESTIBULE FIRST FLOOR PLAN | 3/8" = 1'-0" | 4

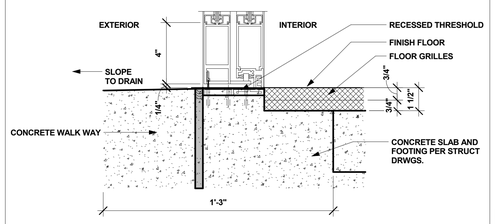

SINGLE SLIDE W/ FIXED SIDELITE - DOOR @ THRESHOLD | 3" = 1'-0" | 13

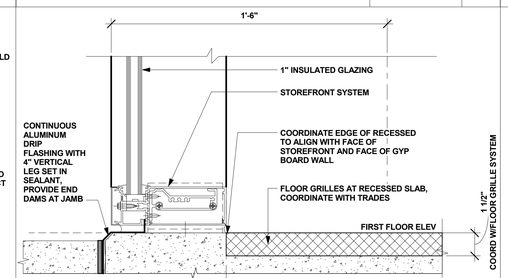

COMPOSITE SIDING PANEL SYSTEM - SILL DETAIL | 3" = 1'-0" | 8

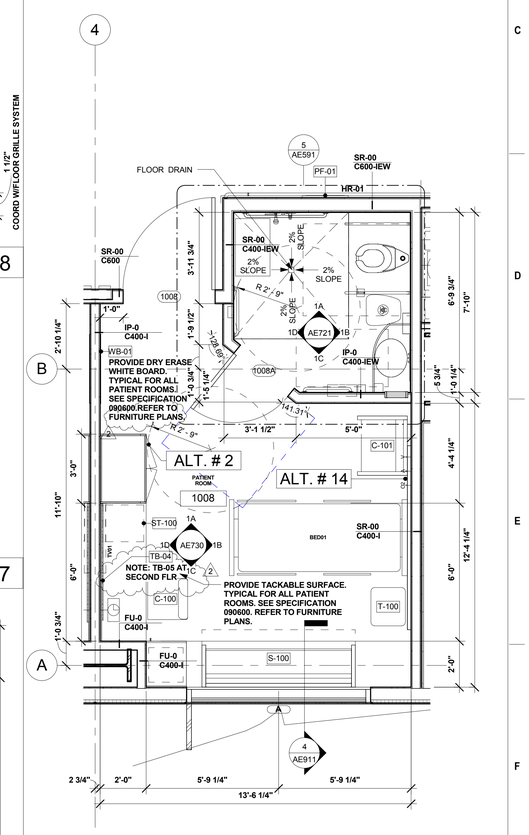

TYPICAL PATIENT ROOM | 3/8" = 1'-0" | 1

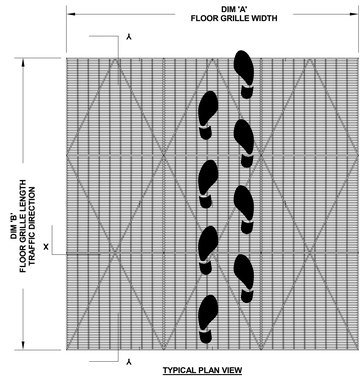

TYPICAL PLAN VIEW

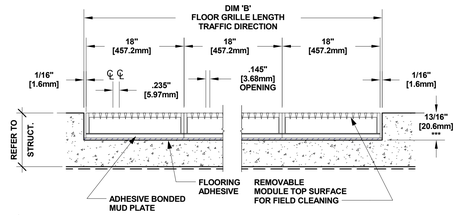

SECTION Y-Y

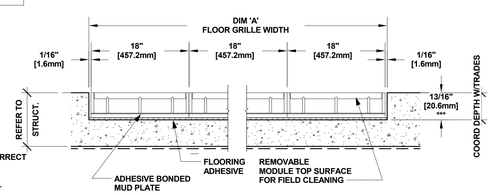

SECTION X-X

NOTES:

1. PERIMETER CUT MODULES ARE AVAILABLE FROM THE FACTORY.
2. ALL SURFACE WIRES AND SUPPORT BARS ARE ELECTRONICALLY RESISTANCE WELDED TO ENSURE CORRECT WEIGHT BEARING PROPERTIES. S/S BANDING TACK WELDED TO THE ASSEMBLY.
3. FLOOR GRILLE/GRID AND FRAME SHALL BE ABLE TO SUPPORT A 500LB ROLLING LOAD.
4. SURFACE WIRE SPACING PROVIDES A 57.7% EFFECTIVE OPEN AREA FOR DIRT AND MOISTURE REMOVAL.
5. REFER TO PLUMBING DRAWINGS FOR LOCATION OF FLOOR DRAIN

*** COORDINATE DEPTH WITH FLOOR GRILL MANUFACTURER

ENTRANCE FLOOR GRILLES | 1/4" = 1'-0" | 11

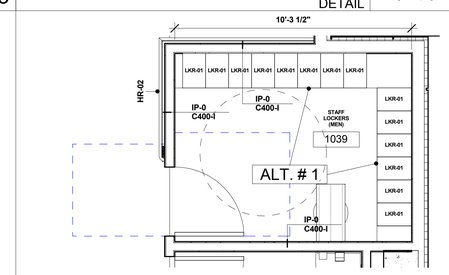

RM. 1039 STAFF LOCKERS (MEN) | 3/8" = 1'-0" | 7

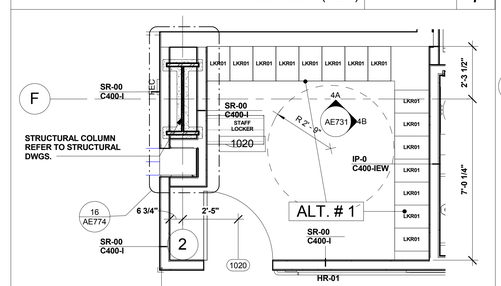

RM. 1020 STAFF LOCKERS | 3/8" = 1'-0" | 6

2	AMENDMENT 2	9/6/12

Revisions | Date

Consultants

COLLABORATIVE DESIGN STUDIO architecture of experience and place
www.collaborativedesignstudio.com
T 775.348.7777 F 775.348.0904
9444 DOUBLE R BLVD SUITE B | RENO NV 89521

Reviewing Agency - Fire Protection

AON
Fire Protection Engineering
Aon Fire Protection Engineering Corporation
11770 Bernardo Plaza Court | Suite 116 | San Diego, CA 92128
t +1.858.673.5845 | f + 1.858.673.5849 | www.aonfpe.com
Fire Protection | Code | Risk | Life Safety | Security

LICENSED ARCHITECT ARTHUR E. BORGER 4556 12/31/2012 STATE OF NEVADA

Architects/Engineers

RBB ARCHITECTS INC
10980 Wilshire Boulevard
Los Angeles, California
90024-3905
Telephone 310 473 3555
Facsimile 310 473 3555
www.rbbinc.com

917 7th St. 2nd Floor Ste. 3
Sacramento, California
95814
Telephone 310 473 3555
Facsimile 310 473 3555
www.rbbinc.com

RBB

Drawing Title
ENLARGED PLANS - PATIENT ROOM & VESTIBULE

Scale
As indicated

Approved Project Director

Project Title
VA RENO HEALTHCARE SYSTEM COMMUNITY LIVING CENTER EXPANSION

Project No. #1017200
VA Contract No. VA261-P-0933

Location
975 KIRMAN AVE., RENO, NV

Date 06/01/2012
Checked RP
Drawn TC

VA Project No. 654-317
Building No.
Drawing No. AE590

Office of Construction and Facilities Management
Department of Veteran Affairs

BID DOCUMENTS