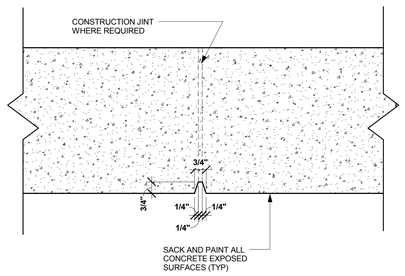

CONCRETE REVEAL DETAIL | 3" = 1'-0" | 24

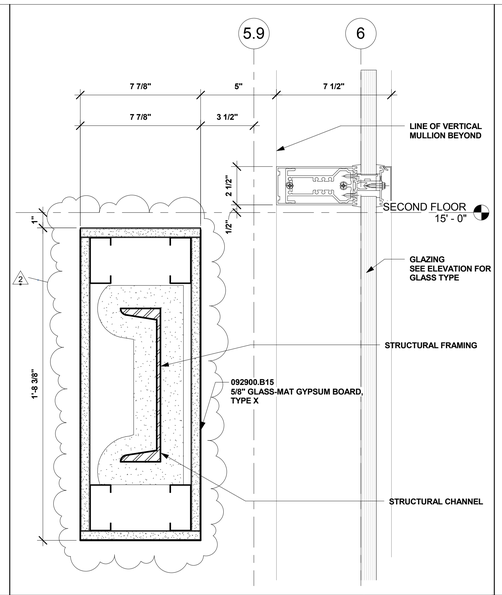

HORIZONTAL CHANNEL ENCLOSURE | 3" = 1'-0" | 19

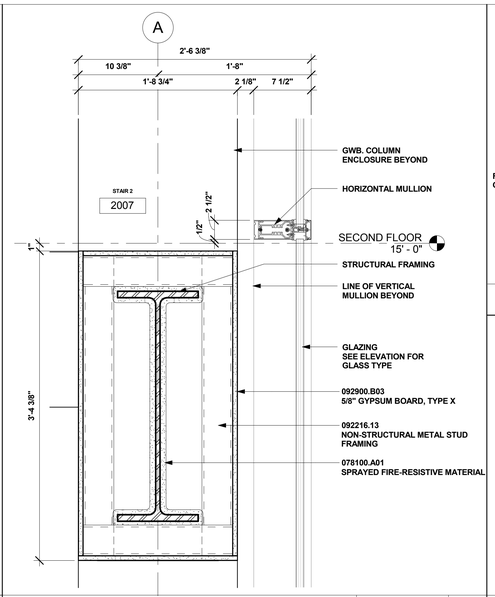

BEAM ENCLOSURE AT STAIR | 1 1/2" = 1'-0" | 14

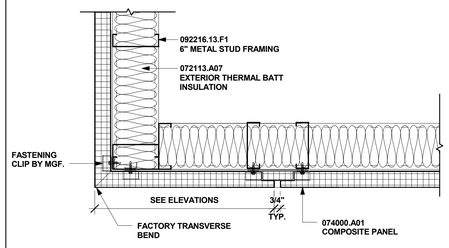

OUTSIDE CORNER AT METAL PANEL | 1 1/2" = 1'-0" | 10

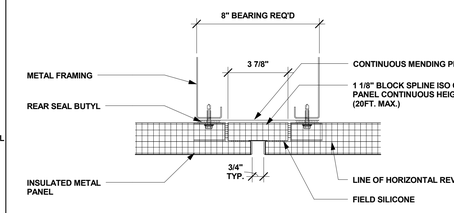

METAL PANEL VERTICAL JOINT | 3" = 1'-0" | 9

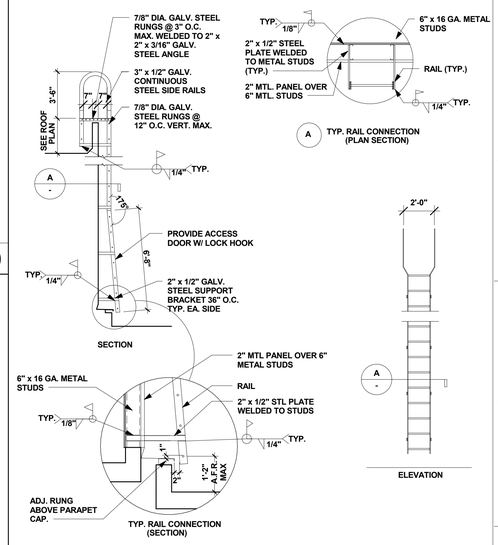

ROOF ACCESS LADDER | 1/4" = 1'-0" | 4

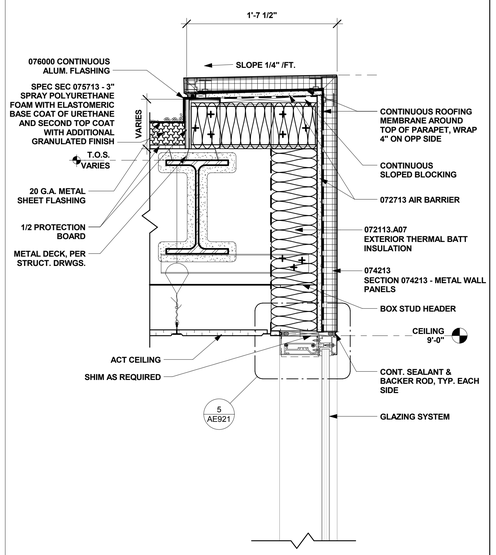

ENTRY VESTIBULE SIDE SECTION | 1 1/2" = 1'-0" | 22

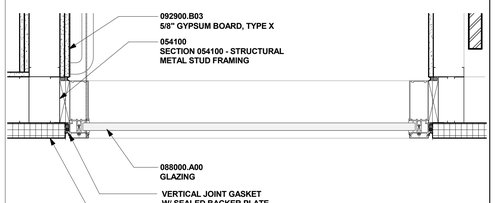

VERTICAL MULLION TO METAL PANEL WALL | 1 1/2" = 1'-0" | 21

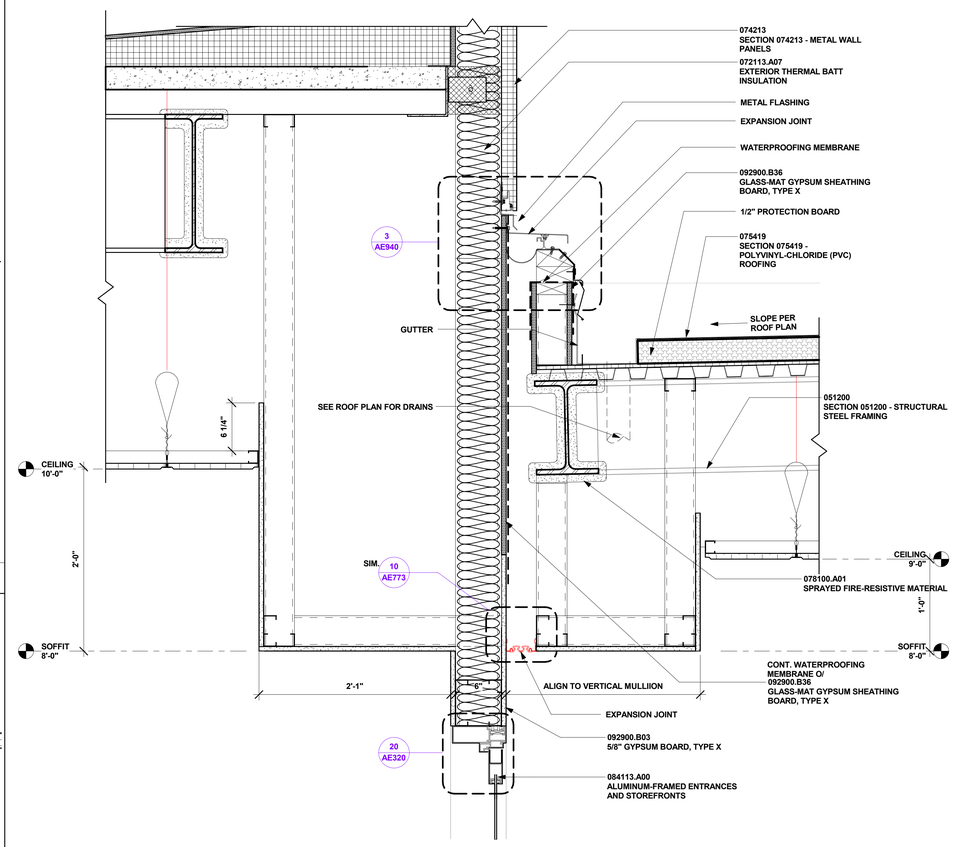

ENTRY VESTIBULE CANOPY REAR SECTION | 1 1/2" = 1'-0" | 11

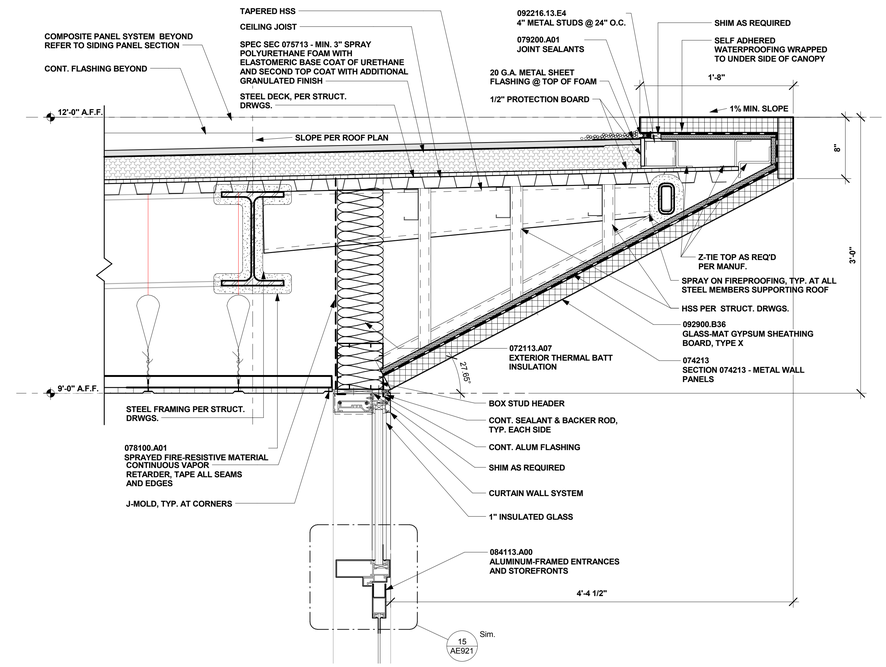

ENTRY VESTIBULE CANOPY FRONT SECTION | 1 1/2" = 1'-0" | 1

	AMENDMENT 2	9/6/12