


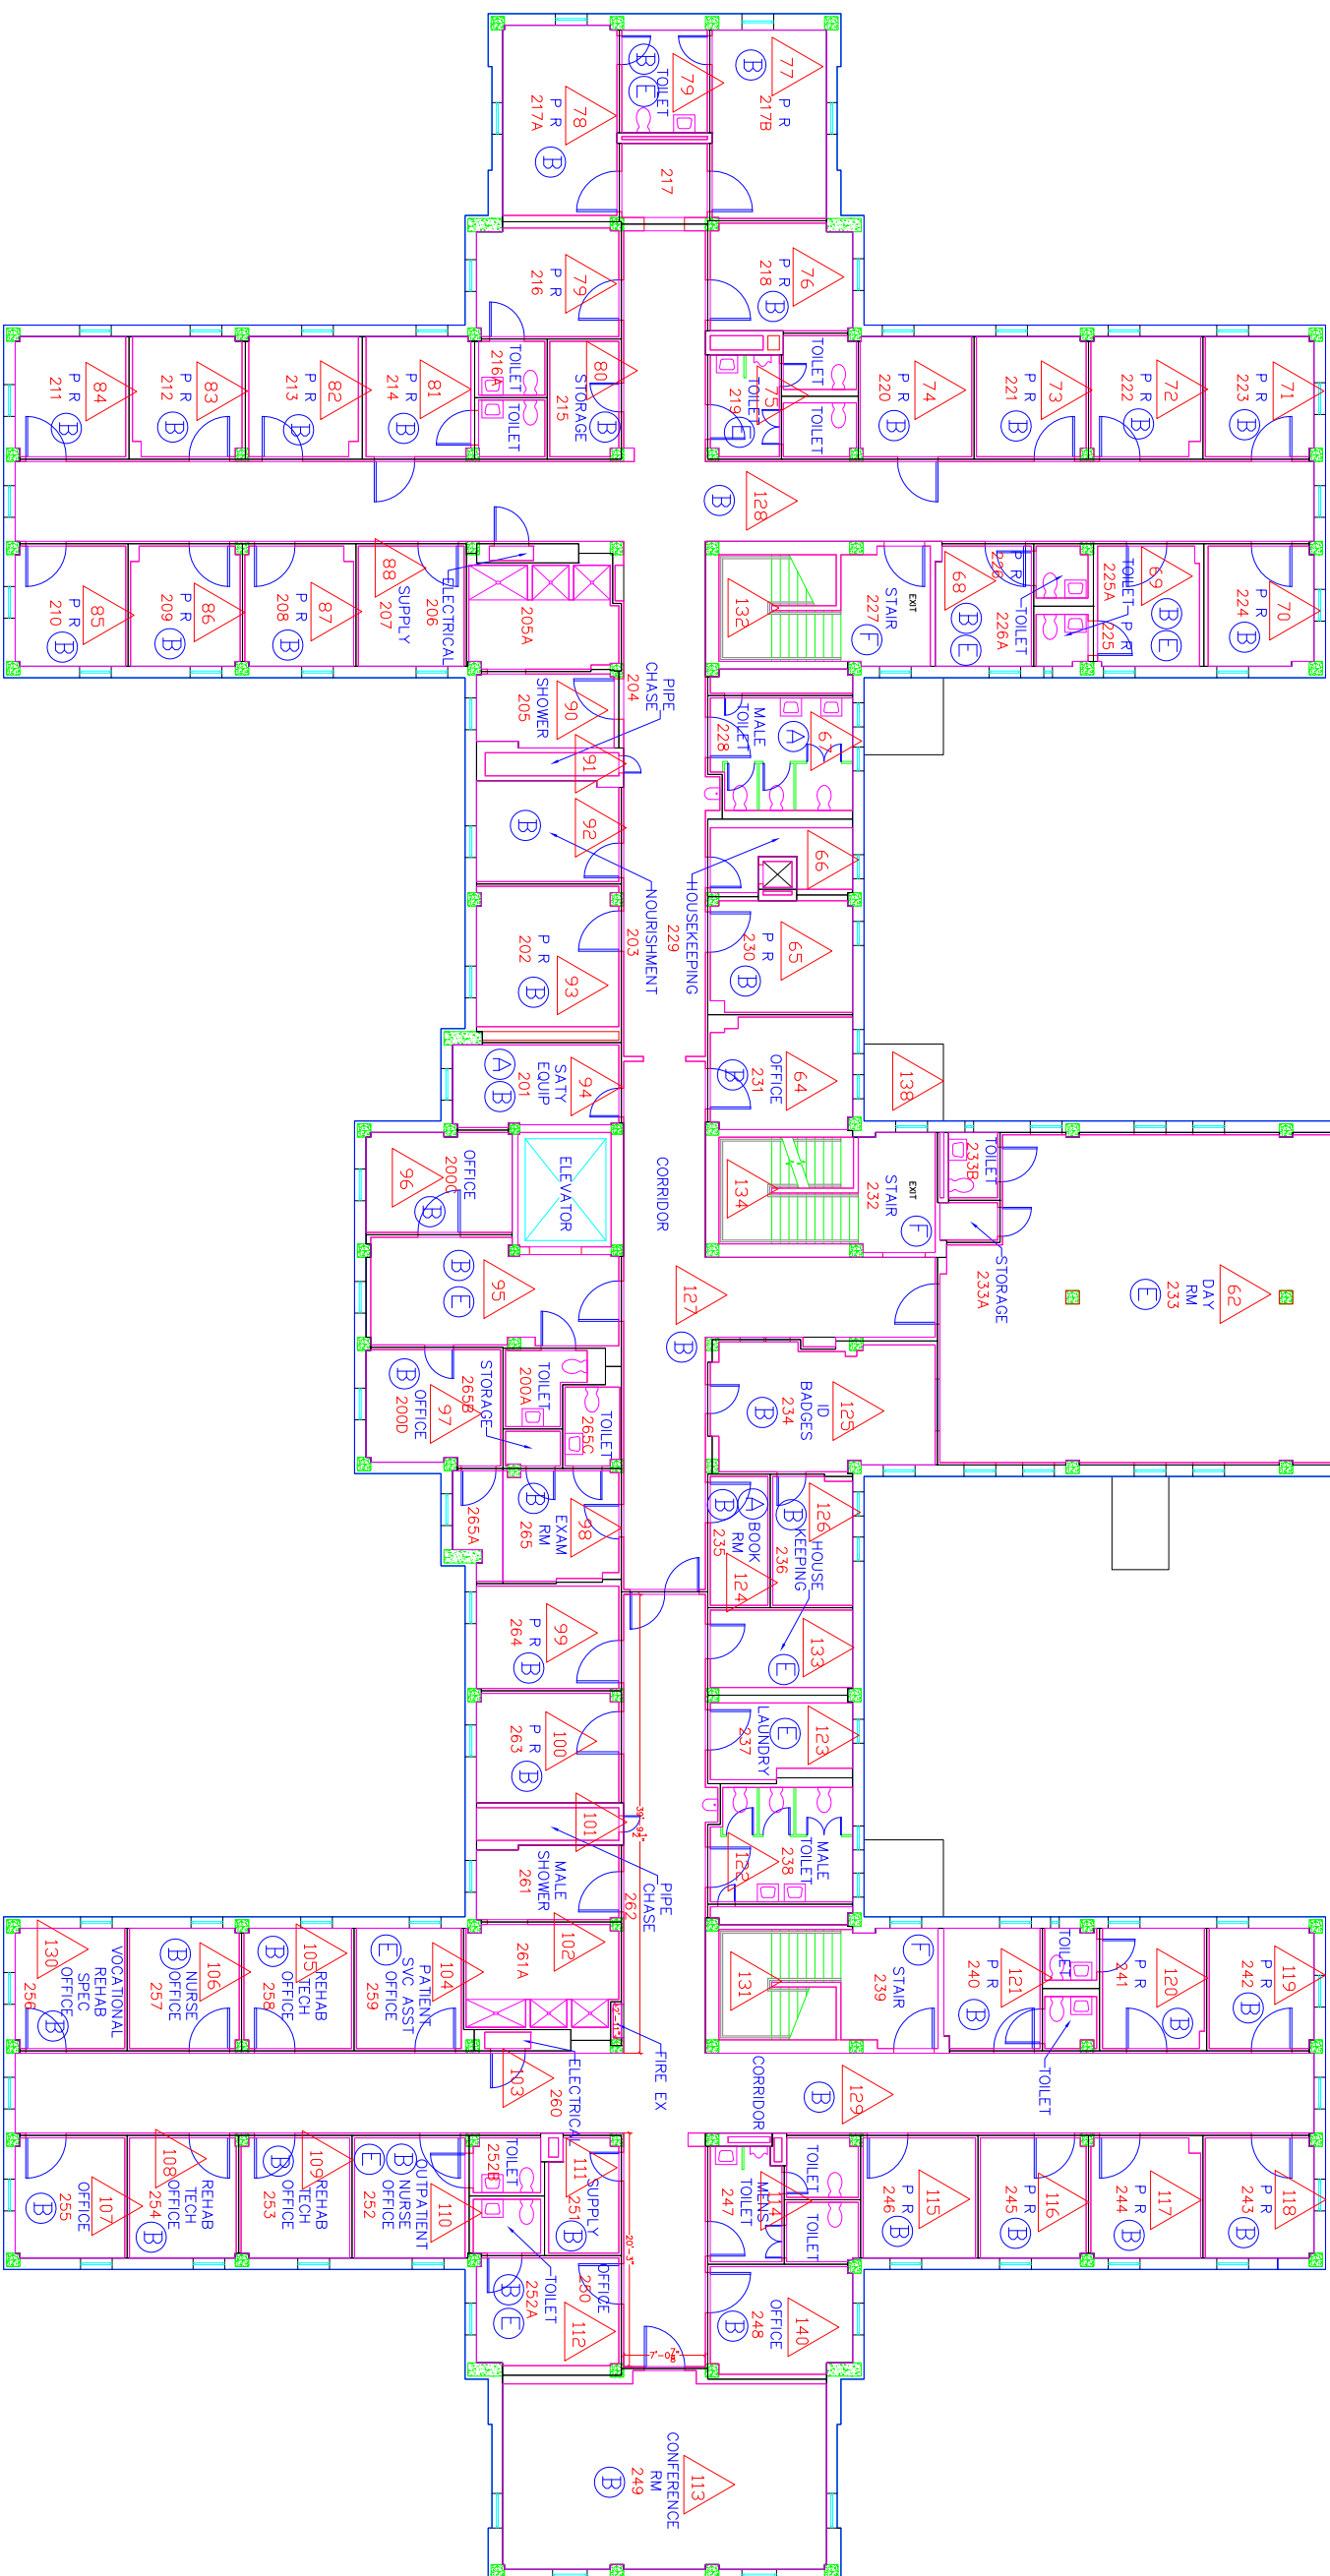





- ASBESTOS CONTAINING MATERIALS
- A. FLOOR TILE
 - B. BLACK FLOOR TILE MASTIC
 - C. AIR CELL PIPE INSULATION
 - D. MUDDIED PIPE FITTINGS
 - E. ASSUMED PIPE AND PIPE FITTING INSULATION
 - F. ASSUMED FIRE DOORS
 - G. MIRROR MASTIC
 - H. ASSUMED ELEVATOR CAB INSULATION
 - I. ASSUMED ELEVATOR DOOR INSULATION
 - J. ASSUMED ROOFING

-  - AREA DESIGNATION
-  - ASBESTOS CONTAINING MATERIAL DESIGNATION



| | | | | |
|--|---|-----------------------------------|------|---|
|  <p> ADAMSON ENGINEERING & DESIGN, INC. 1323 W. 10TH AVE., SUITE 200 DENVER, COLORADO 80202 PHONE: 303-733-8227 FAX: 303-733-8228 </p> | Divisions | | Date | |
| | Drawing Title SECOND FLOOR PLAN ARCHITECTURAL | | | |
| Project Title Asbestos Drawings | | Date 10-11-2011 | |  |
| Approved: | | Project No. | | |
| Building Number 22H | | Checked | |  |
| Location VAMC PERRYPOINT MARYLAND | | Drawn | | |
| Approved: | | Drawing No. H-22H3 | |  |
| Professional Seal | | VA Department of Veterans Affairs | | |