




NORTH

ASBESTOS CONTAINING MATERIALS

- A. FLOOR TILE
- B. BLACK FLOOR TILE MASTIC
- C. AIR CELL PIPE INSULATION
- D. MUDDIED PIPE FITTINGS
- E. ASSUMED PIPE AND PIPE FITTING INSULATION
- F. ASSUMED FIRE DOORS
- G. MIRROR MASTIC
- H. ASSUMED ELEVATOR CAB INSULATION
- I. ASSUMED ELEVATOR DOOR INSULATION
- J. ASSUMED ROOFING

△ - AREA DESIGNATION

○ - ASBESTOS CONTAINING MATERIAL DESIGNATION

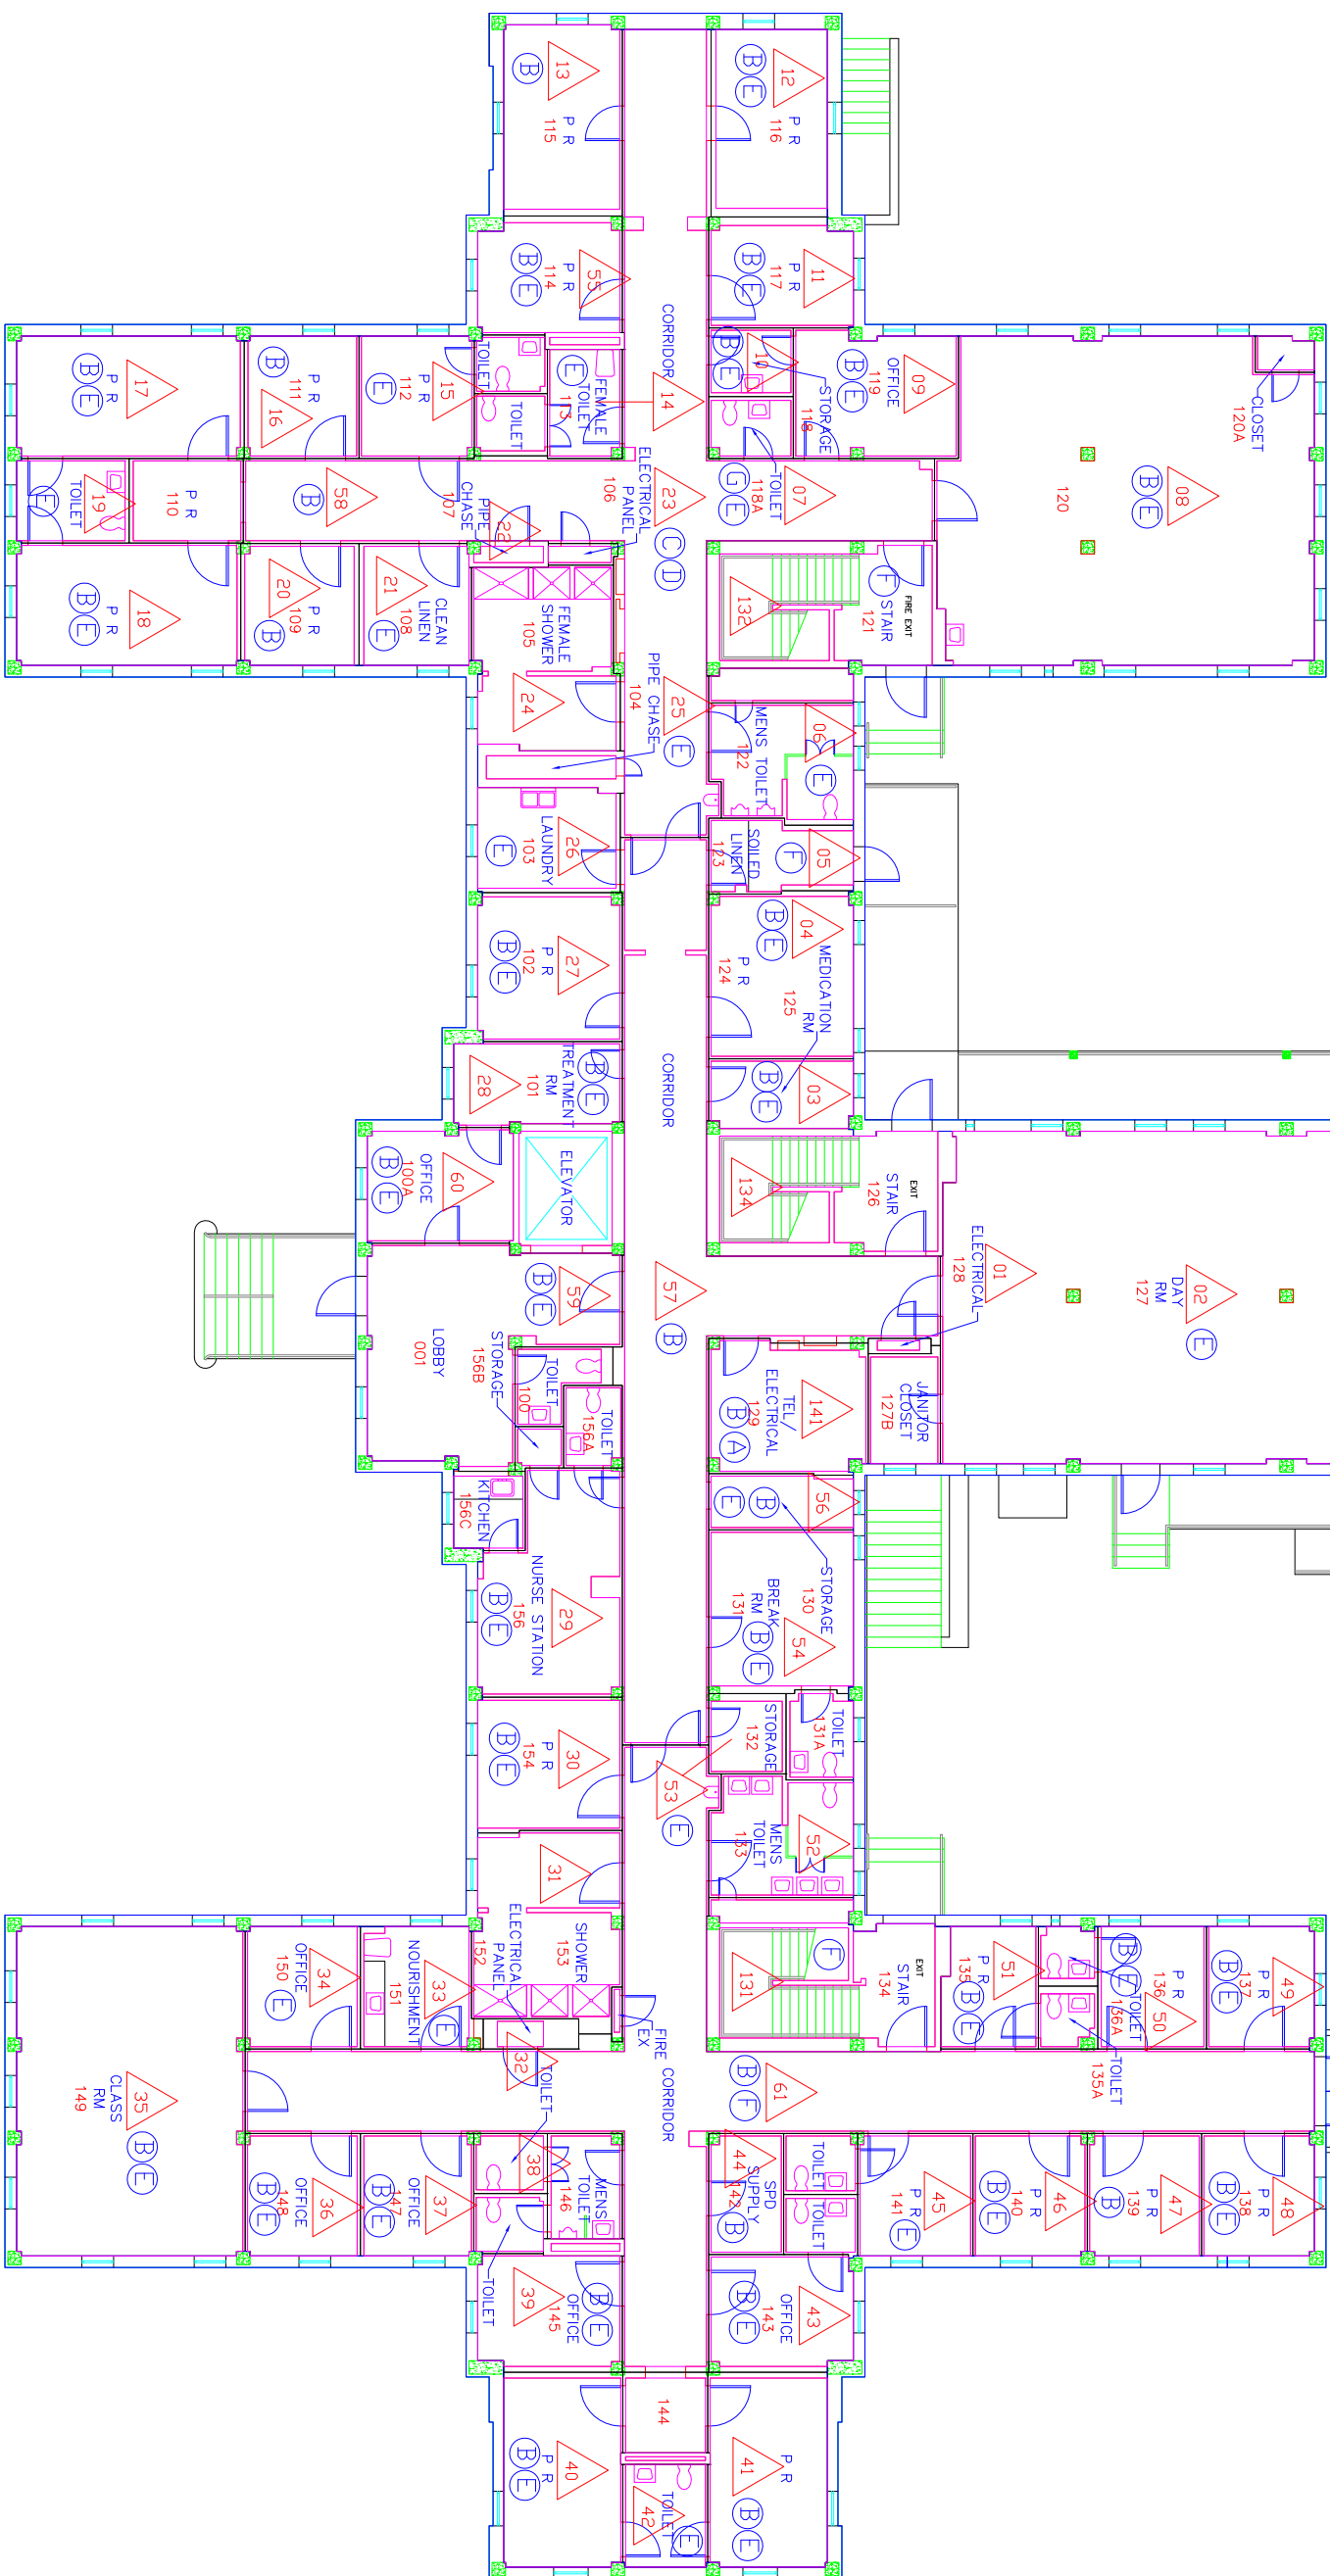

Revisions	Date
-----------	------

Date


**AEROSOL MONITORING
& ANALYSIS, INC.**
1331 ASHTON ROAD, P.O. BOX 646
HAMMONT, MARYLAND 21078
WEBSITE: WWW.AAMCONCROLLING.COM
PHONE: 410-664-3327
FAX: 410-664-3384

Professional Seal

Drawing Title
FIRST FLOOR PLAN
ARCHITECTURAL
Approved:
Approved:

Project Title		
Asbestos Drawings		
Building Number	Checked	Drawn
22H		
Location		
VAMC PERRYPOINT MARYLAND		

Date	10-01-2011
Project No.	
Drawing No.	H-22H1

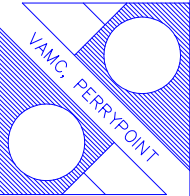

VA Department of
Veterans Affairs