


PLAN NOTES:

- | | |
|-----|--------------------------------|
| (A) | LIGHT SUPPORT PER SECT 7/54.01 |
| (B) | BOOM SUPPORT PER SECT 8/54.01 |

3rd FLOOR INTERSTITIAL FRAMING PLAN

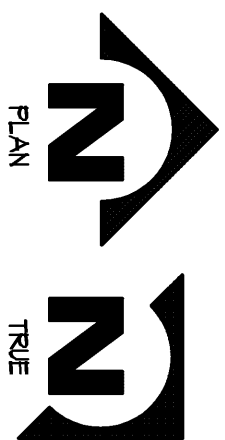

Revision 1	9/7/12
Revision	Date


Tompkins Architects 507 Walnut, Suite 200 Kansas City, MO 65106 816.472.5656	Frank Zim (Planning) 1401 W. 50th Terrace Kansas City, MO 64112 816.561.7186	SSR (Mech/Elec/Plumb) 11460 Tomahawk Creek, Suite 320 Leawood, KS 66211 913.319.3560
Bob D. Campbell (Structural) 4338 Bellview Kansas City, MO 64111 816.531.4144	Mustardseed (Environmental) 2222 W. Gregory Blvd., Suite 211 Kansas City, MO 64114 816.333.2424	CMG (Fire Protection) 10727 West 128th Street Overland Park, KS 66213 816.239.8900

Approved For:	Name	Initials	Date
<input type="checkbox"/> Construction <input type="checkbox"/> Submittal			


Drawing Title	
THIRD FLOOR INTERSTITIAL FRAMING PLAN	

Project Title		
SPECIALTY CLINIC EXPANSION		
Building Number	Checked	Drawn
100 D&T	SRC	EAO
VA PUGET SOUND HEALTH CARE SYSTEM (SEATTLE) 16160 S. COLUMBIAN WAY, SEATTLE, WA, 98108		

Date	08/10/2012
Project No.	VA 663-376
Drawing No.	100-SS 1.02
Dwg. of	

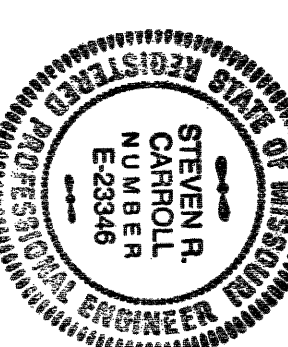

STEVEN R.
CARROLL
NUMBER
PROFESSIONAL ENGINEER
REGISTERED



Department of
Veterans Affairs