



A three inches = one foot
 B one and one-half inches = one foot
 C one inch = one foot
 D three-quarters inch = one foot
 E one-half inch = one foot
 F three-eighths inch = one foot
 G one-quarter inch = one foot
 H one-eighth inch = one foot


A
 B
 C
 D
 E
 F

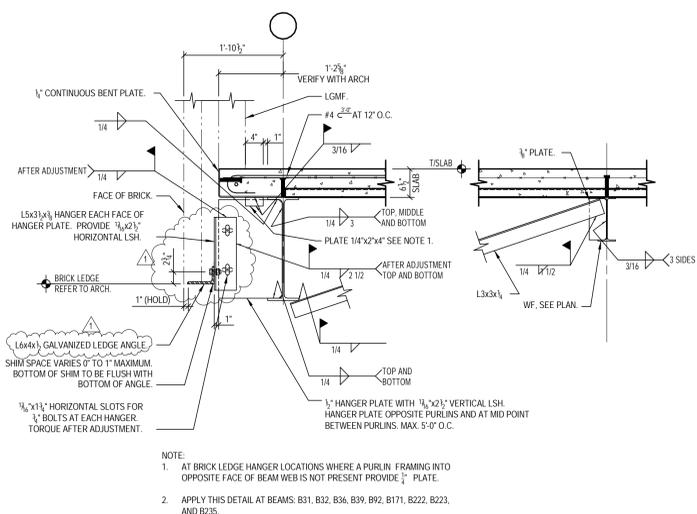


SECTION 1
 2.3S307 3/4" = 1'-0"

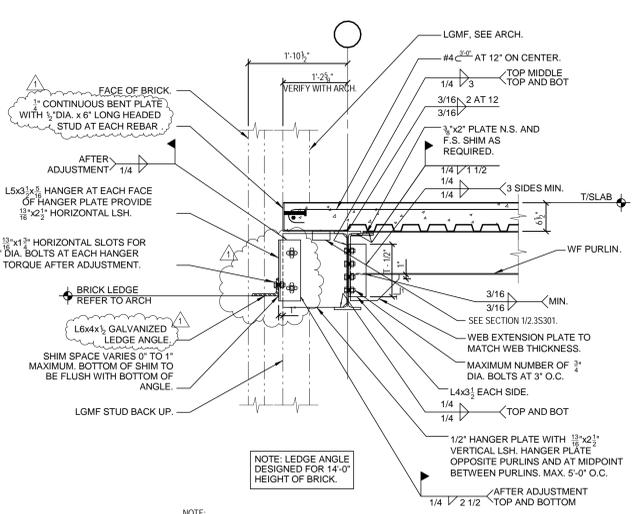


SECTION 2
 2.3S307 3/4" = 1'-0"

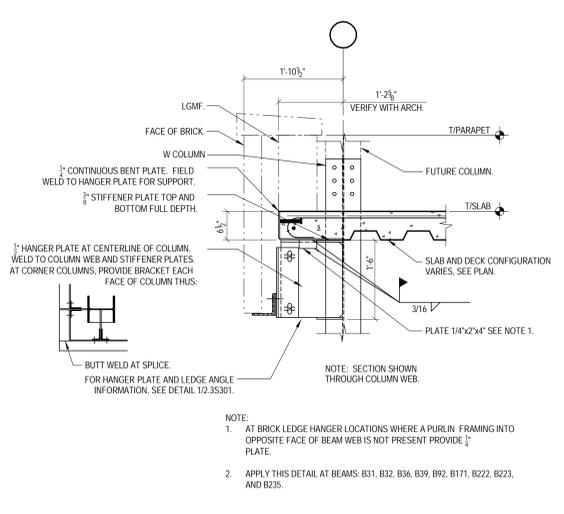


SECTION 3
 2.3S307 3/4" = 1'-0"

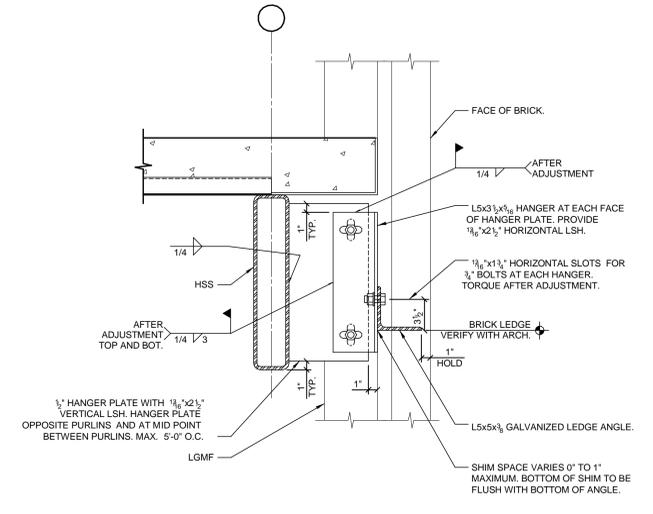


SECTION 4
 2.3S307 1 1/2" = 1'-0"

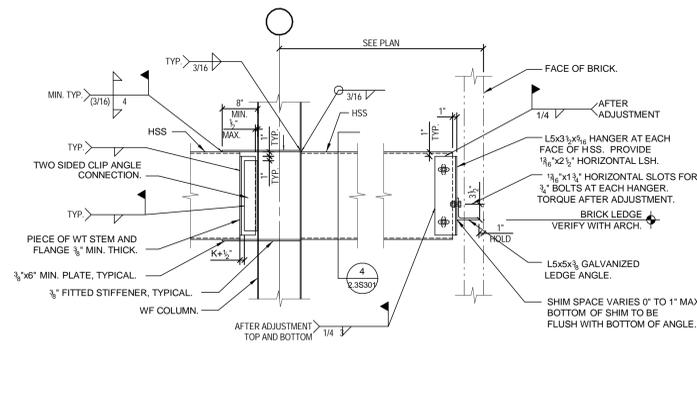


SECTION 5
 2.3S307 3/4" = 1'-0"

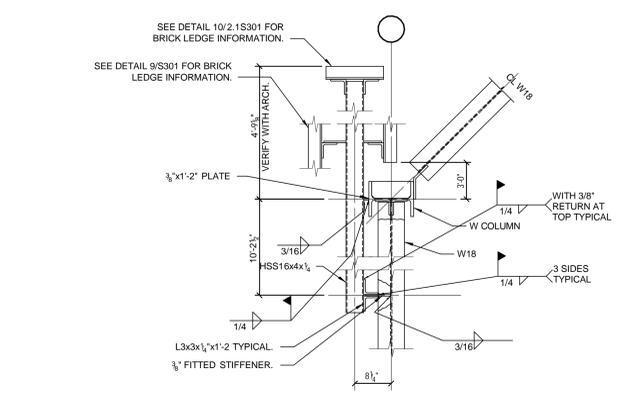


SECTION 6
 2.3S307 3/4" = 1'-0"

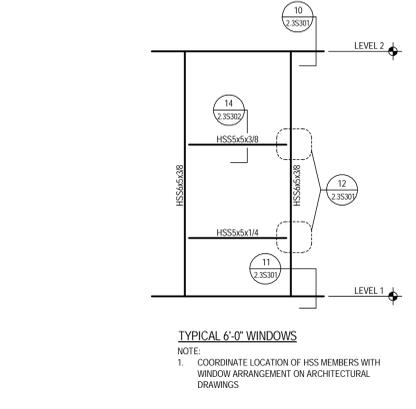


ELEVATION 7
 2.3S307 1/4" = 1'-0"

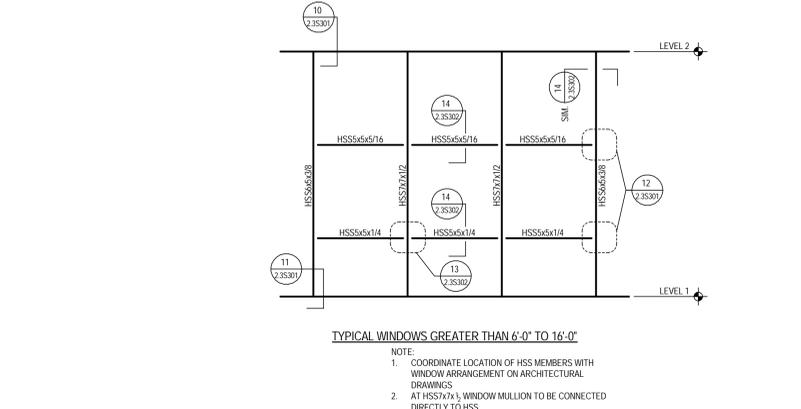


ELEVATION 8
 2.3S307 1/4" = 1'-0"

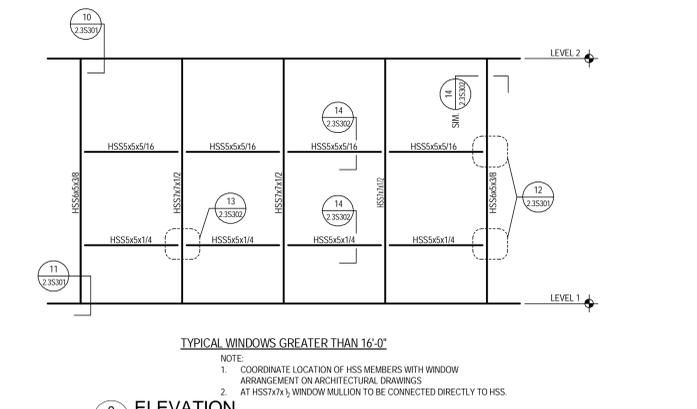


ELEVATION 9
 2.3S307 1/4" = 1'-0"

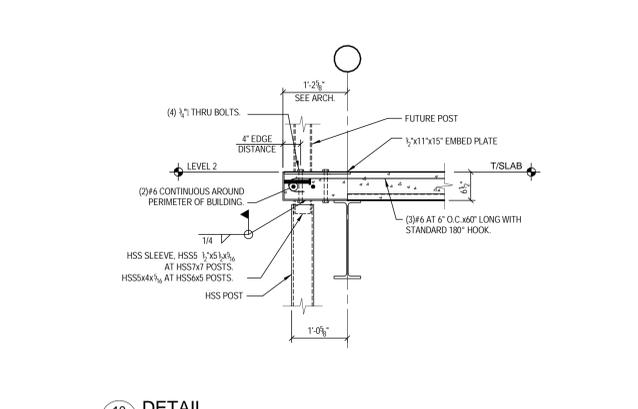

DETAIL 10
 2.3S307 3/4" = 1'-0"

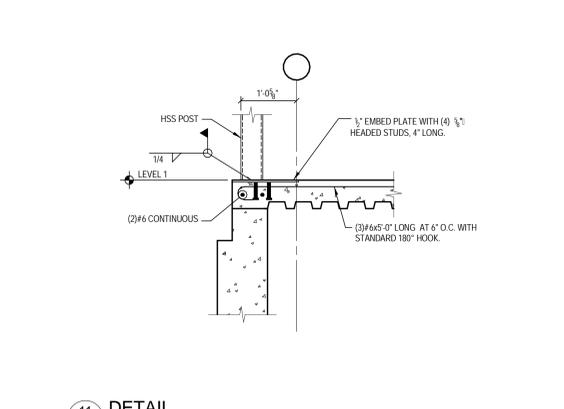

DETAIL 11
 2.3S307 3/4" = 1'-0"

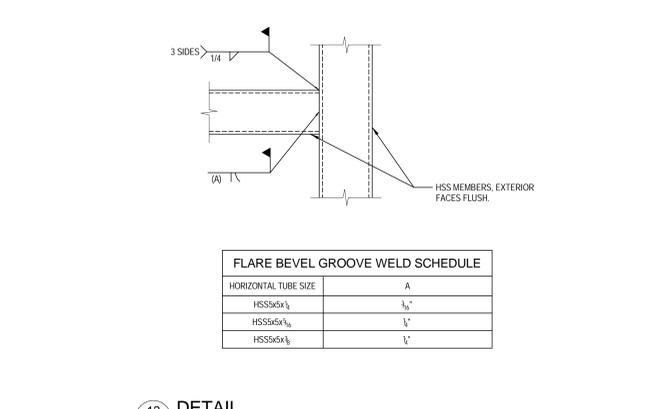

DETAIL 12
 2.3S307 1 1/2" = 1'-0"

FLARE BEVEL GROOVE WELD SCHEDULE	
HORIZONTAL TUBE SIZE	A

Revisions	Date
1	ADDENDUM #1 09.04.12
	BID DOCUMENTS 01.30.12
	100% REVIEW 01.10.12
	DESIGN DEVELOPMENT 11.15.11
	SCHEMATIC DESIGN 9.17.11

CONSULTANTS:

THP Limited, Inc.
 100 East Eighth Street
 Cincinnati, Ohio 45202
 Phone: 513.241.3222
 Fax: 513.241.2861
 www.thp.com

ARCHITECT/ENGINEERS:

thinkchamplin.com
 424 East Fourth Street
 Cincinnati, OH 45202
 T 513.241.4474 F 513.241.0081
 THINK CREATE REALIZE

Drawing Title

FRAMING DETAILS

PHASE 3

Approved: Project Director

Project Title

RELOCATE SHORT TERM REHAB COMMUNITY LIVING CENTER

Location

Enter address here

Date

9/4/12

Checked

STE

Drawn

VLB

Project No.

VA Project No. 539-324
 THP Project No. 08260.XX

Building Number

2

Drawing Number

2.3S301

Office of Construction and Facilities Management

Department of Veterans Affairs