

A

three inches = one foot  
6"

B

one and one half inch = one foot  
6"

C

one inch = one foot  
6"

D

three quarters inch = one foot  
6"


E

one half inch = one foot  
6"

F

three eighths inch = one foot  
6"

one eighth inch = one foot  
6"

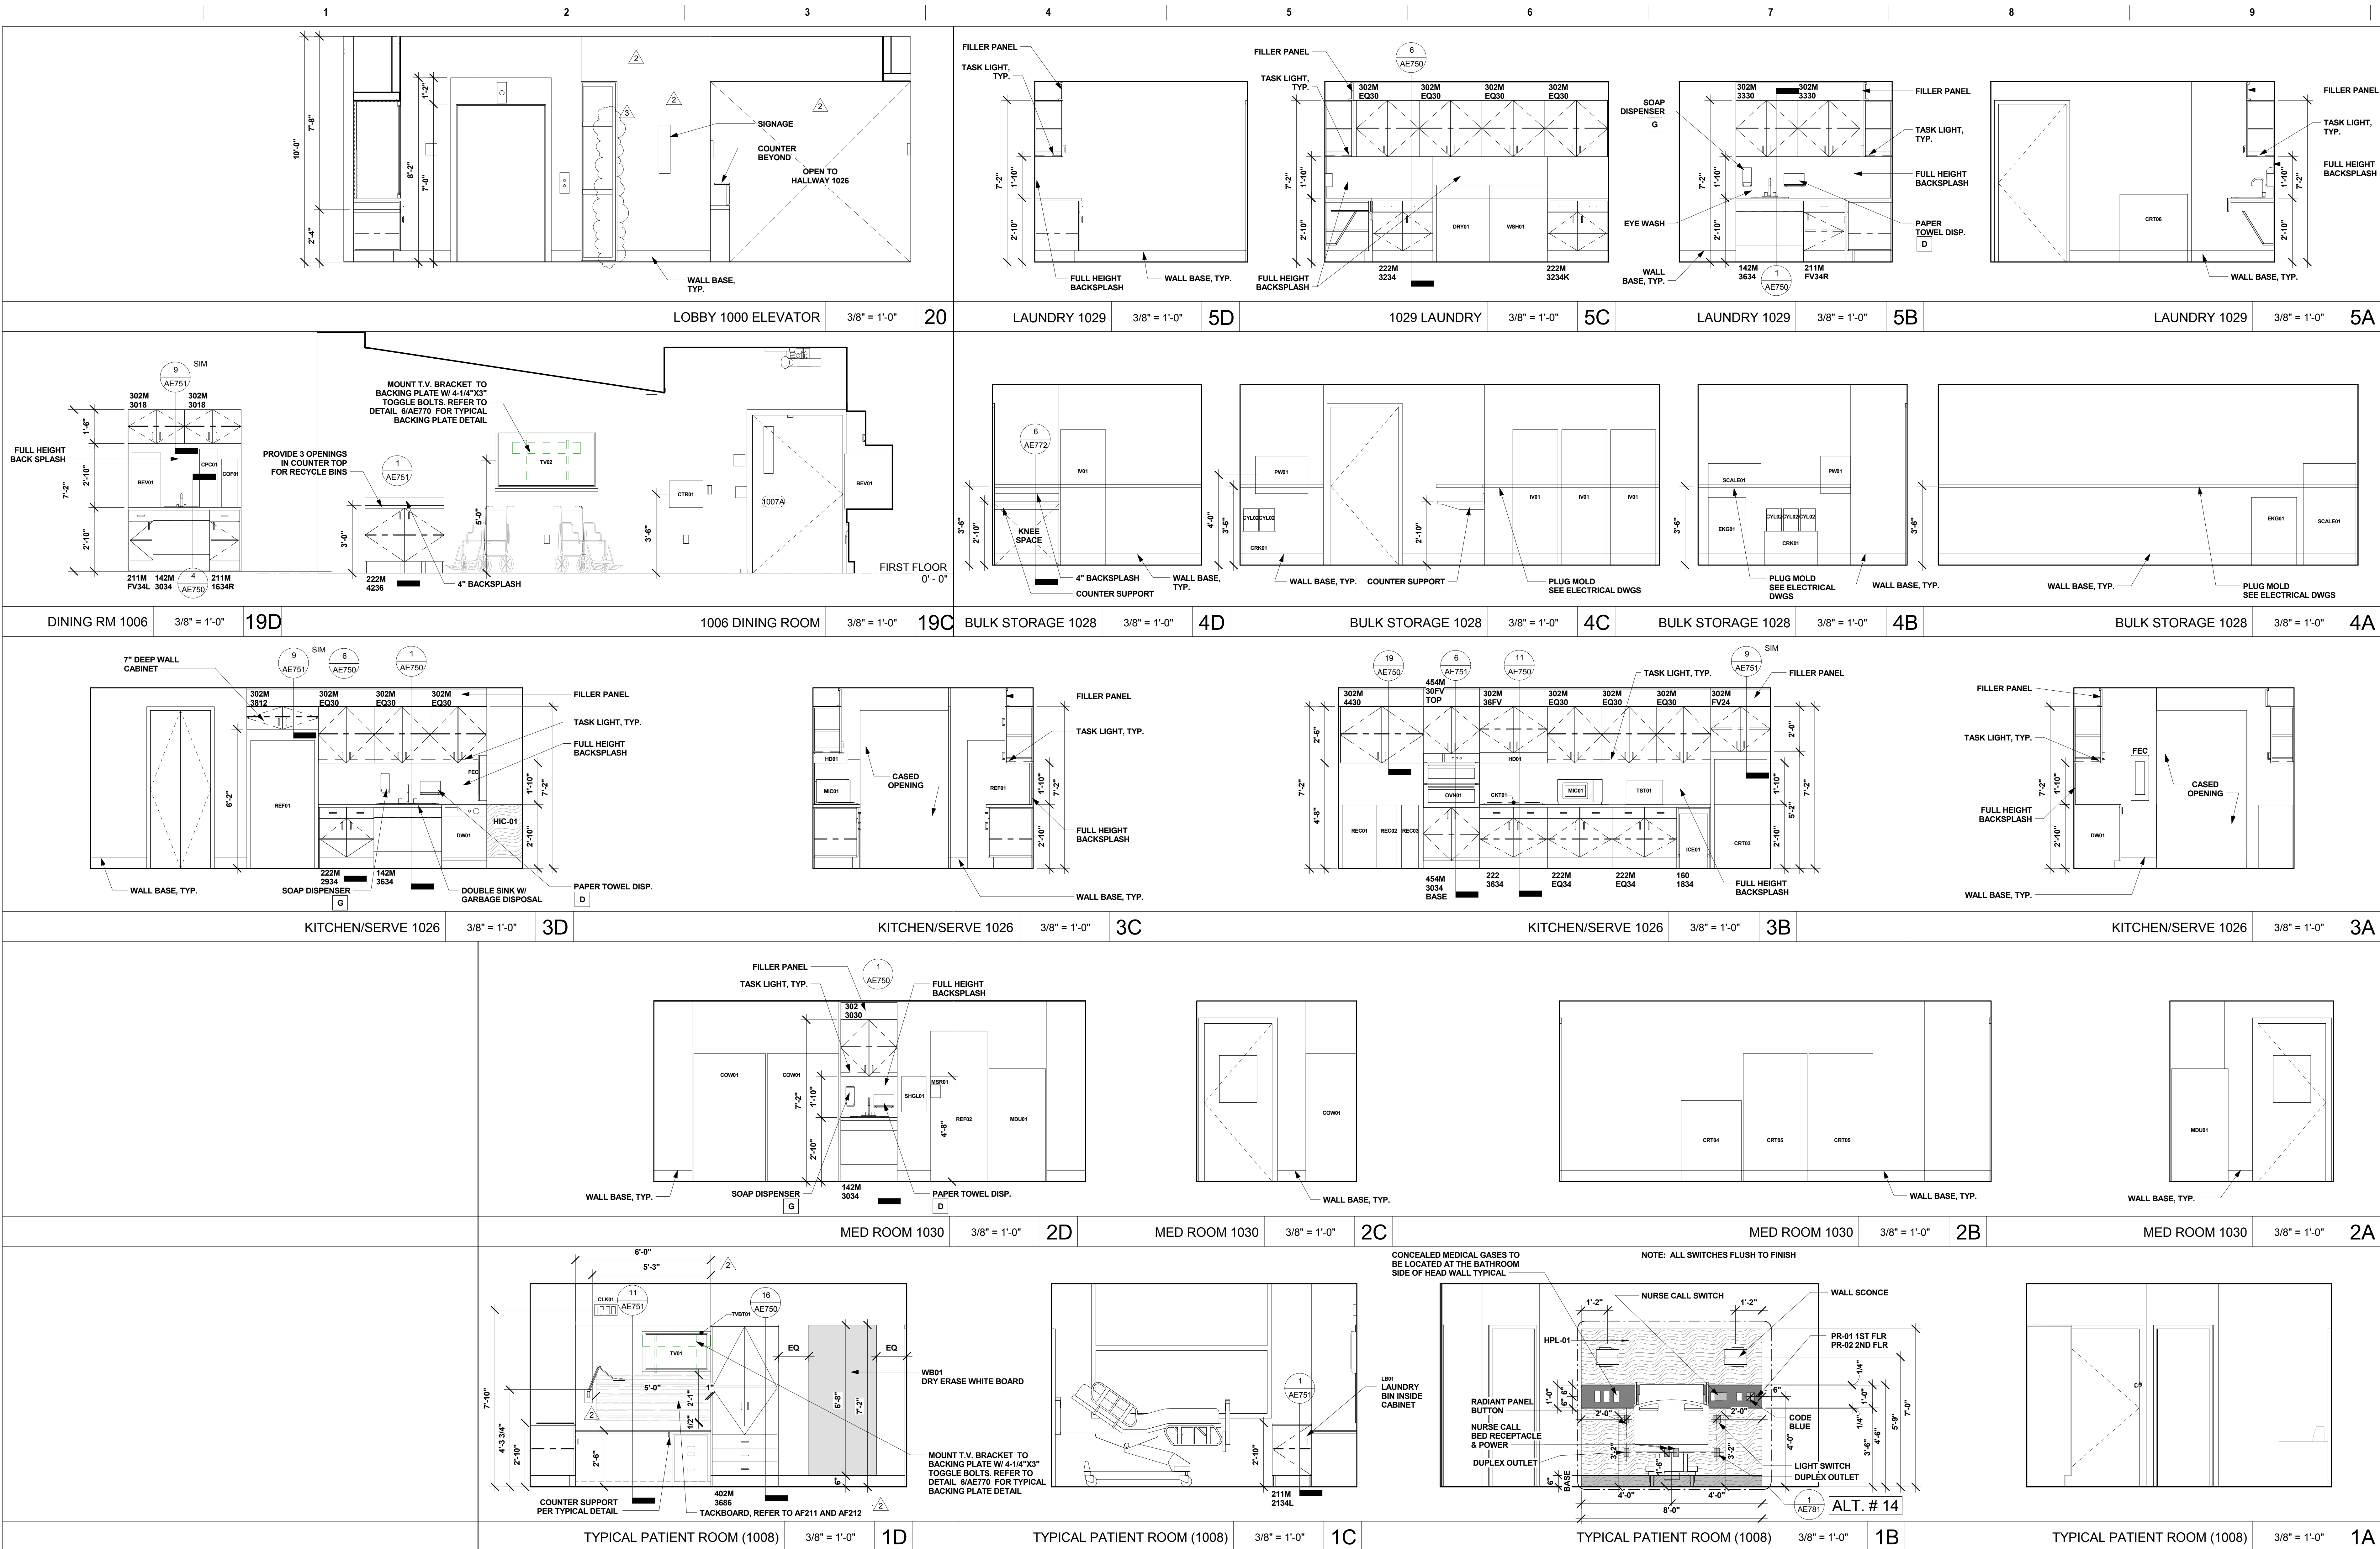

BID DOCUMENTS