


three inches = one foot
 one and one half inches = one foot
 one inch = one foot
 three quarters inch = one foot
 one half inch = one foot
 three eighths inch = one foot
 one quarter inch = one foot
 one eighth inch = one foot

Scale 1/8" = 1'-0"

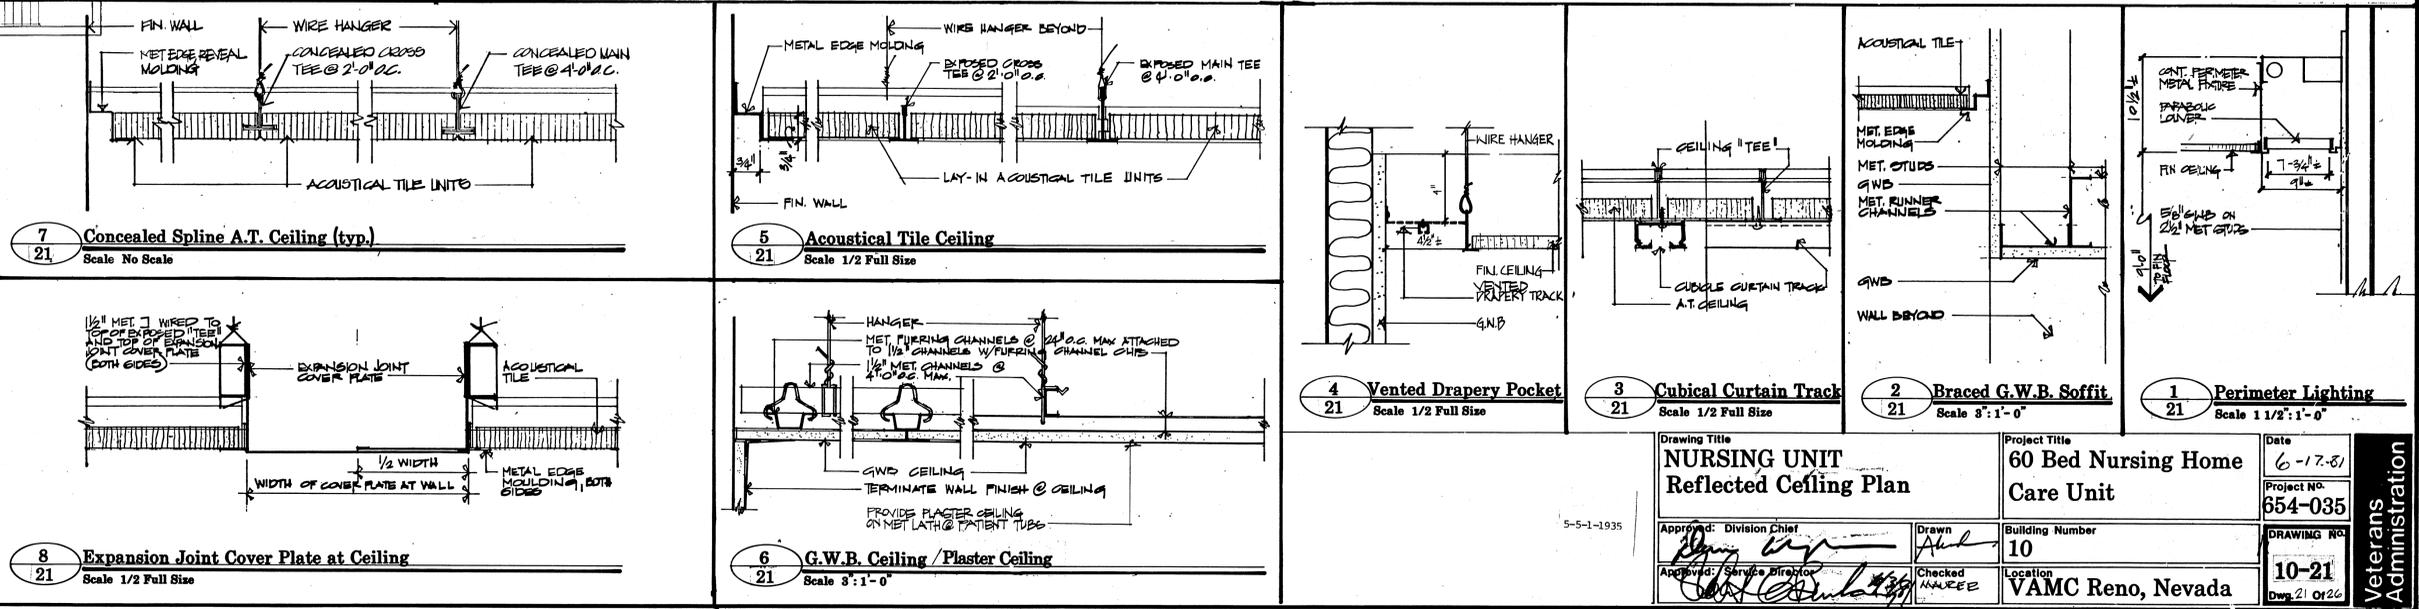

Drawing Title NURSING UNIT Reflected Ceiling Plan		Project Title 60 Bed Nursing Home Care Unit		Date 6-17-81
Approved: Division Chief <i>[Signature]</i>		Building Number 10		Project No. 654-035
Approved: Service Director <i>[Signature]</i>		Location VAMC Reno, Nevada		DRAWING NO. 10-21 Date: 21 Oct 81

FIRST FLOOR RCP
 BUILDING 10 AS BLT